


PLAN
 SHEET NO. 15(13)
 PROJECT NO. 99R385
 DATE 7/12/48
 DRAWN BY M.L. DENNIS, JR.
 CHECKED BY M.L. DENNIS, JR.

PROFILE
 SHEET NO. 15(13)
 PROJECT NO. 99R385
 DATE 7/12/48
 DRAWN BY M.L. DENNIS, JR.
 CHECKED BY M.L. DENNIS, JR.

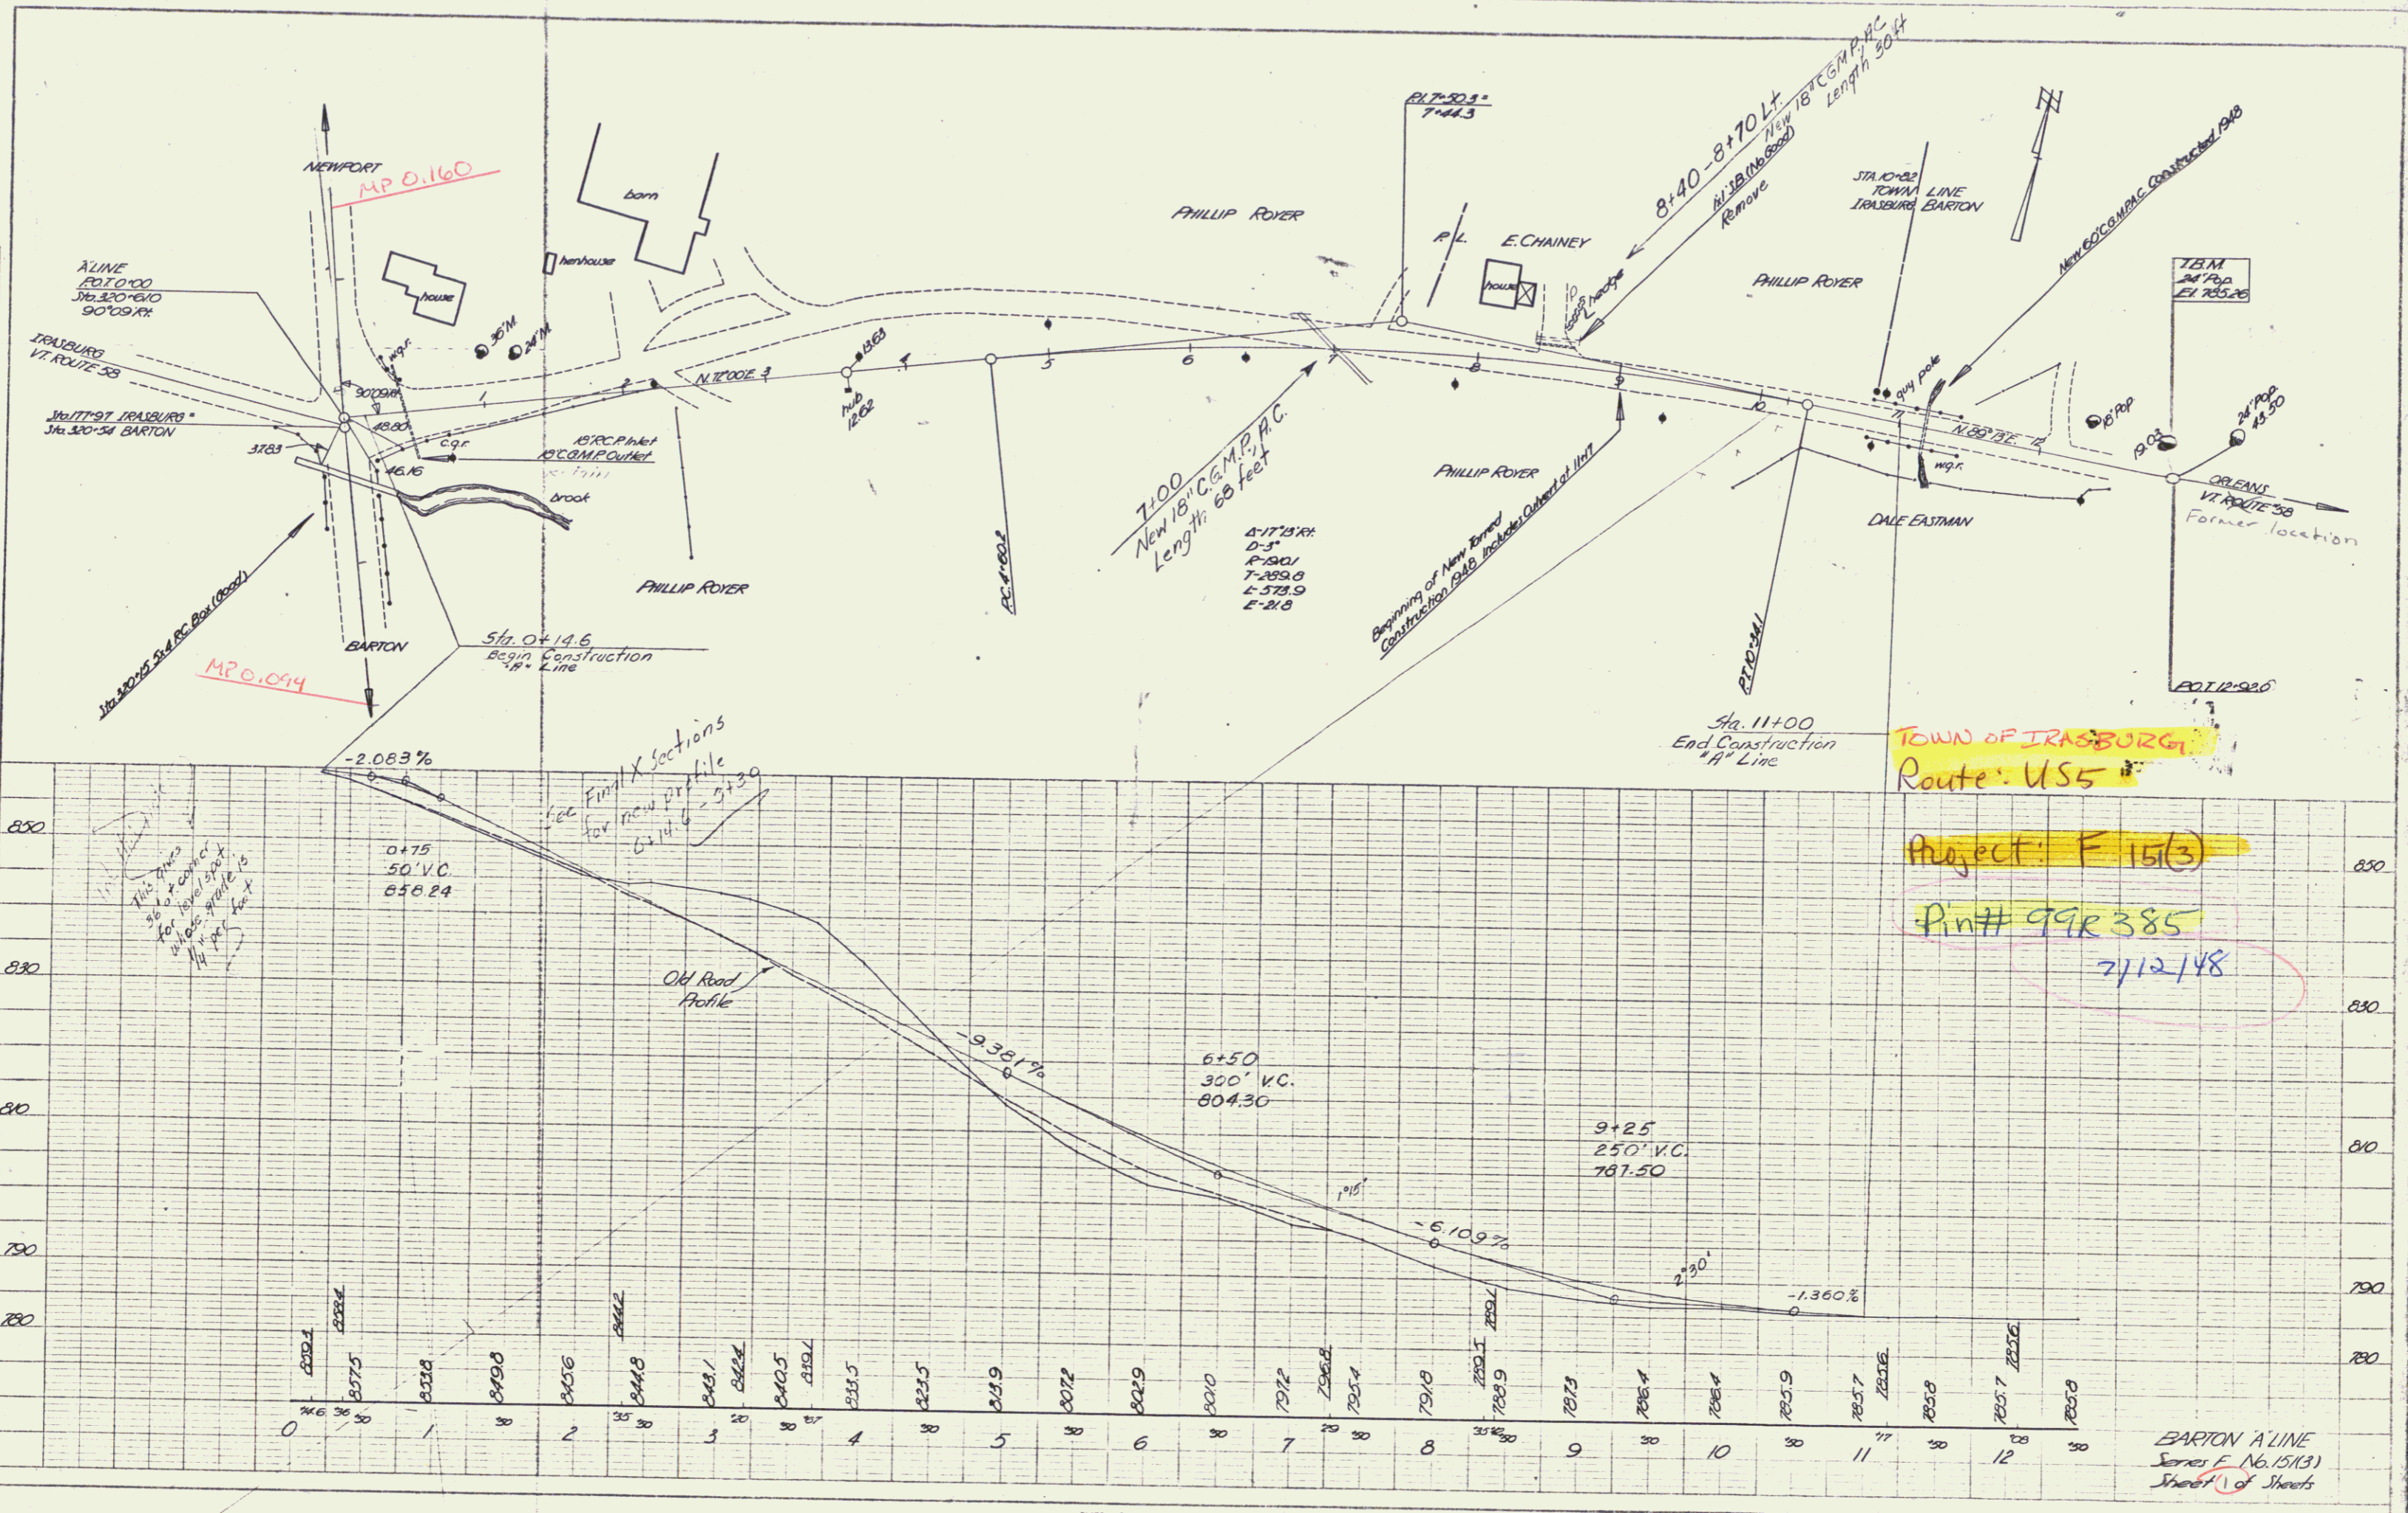

TOWN OF IRASBURG
 Route: US 5
 Project: F 15(13)
 Pin# 99R385
 7/12/48

BARTON A LINE
 Series E No. 15(13)
 Sheet 1 of 2