

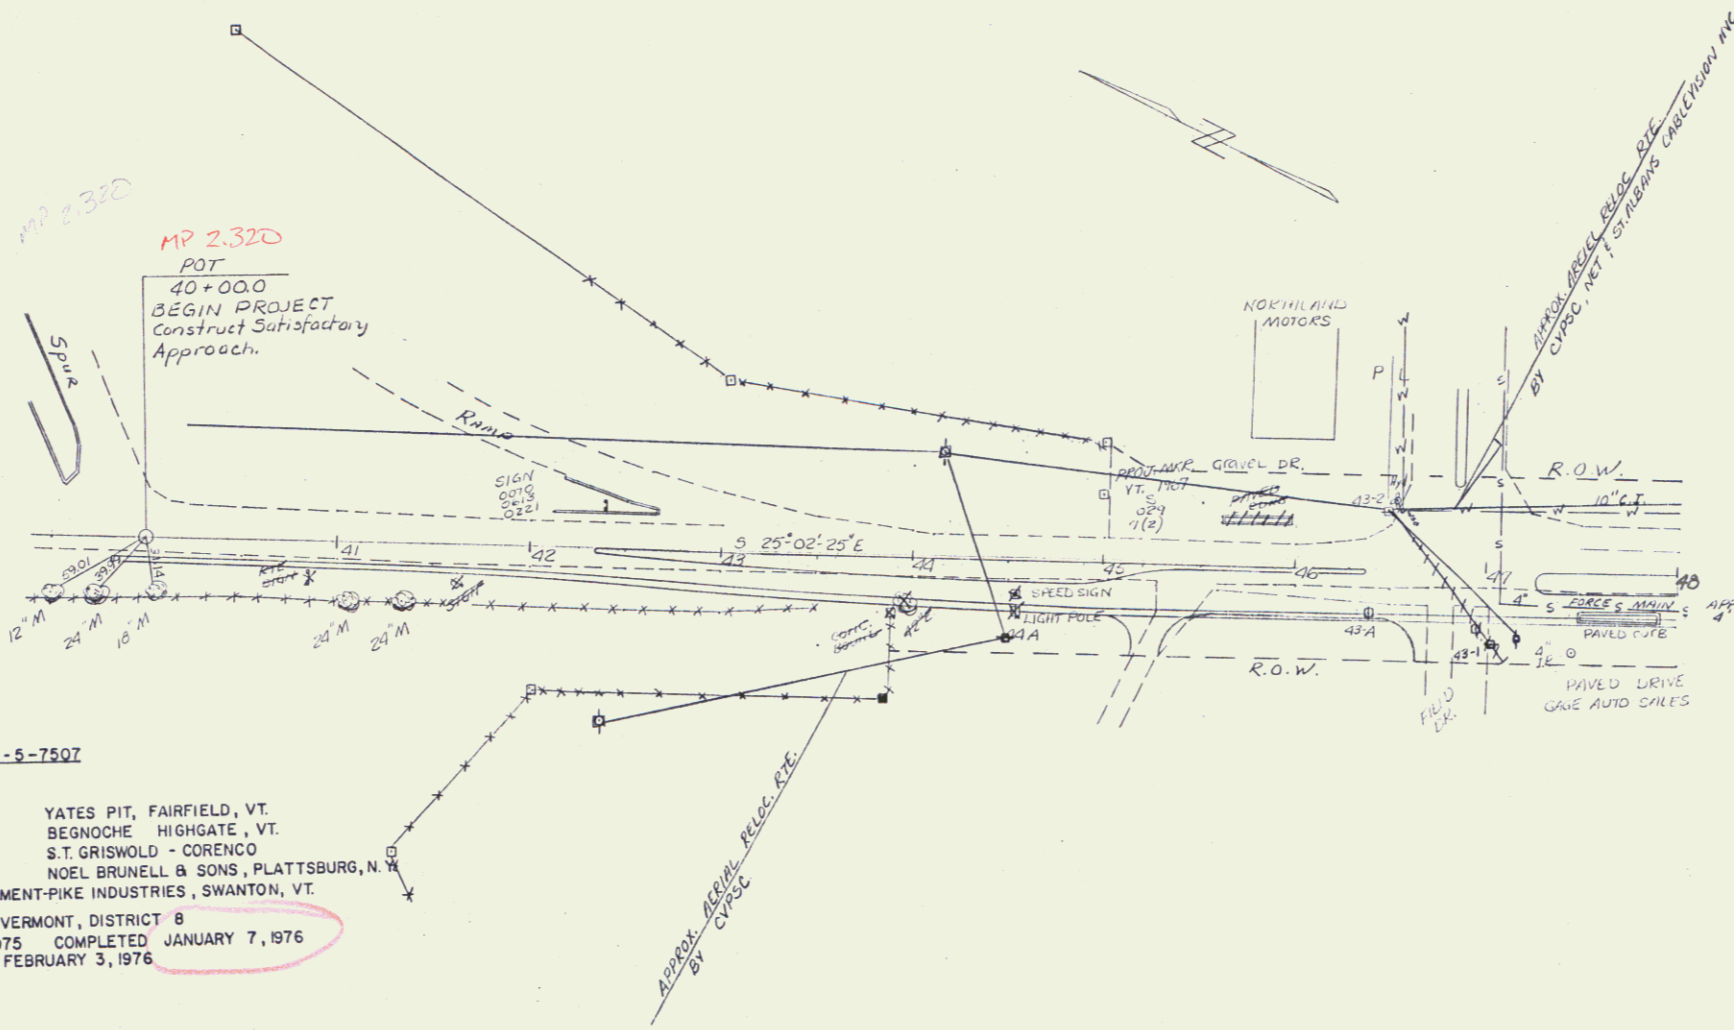


INDEX OF SHEETS

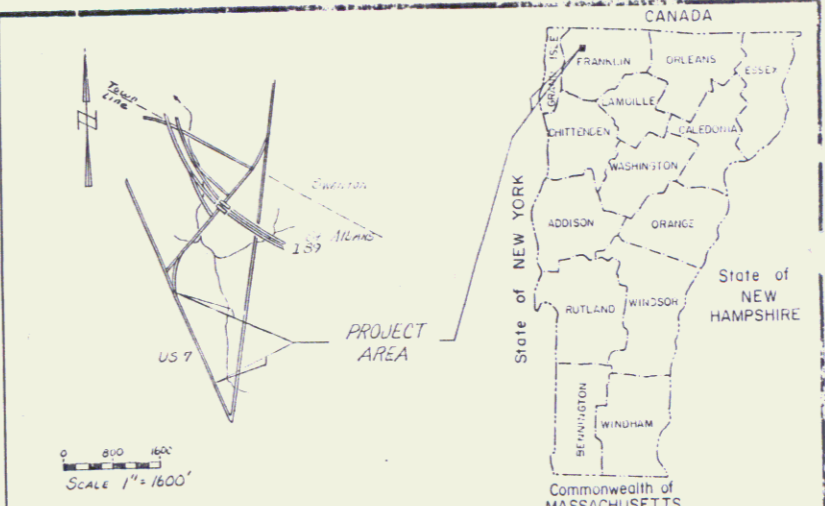


- CONVENTIONAL SIGNS
- COUNTY LINE
  - TOWN LINE
  - LIMITS OF ACCESS
  - POINT OF ACCESS
  - FENCE LINE
  - STONE WALL
  - TRAVELED WAY
  - GUARD RAIL
  - RAILROAD
  - SURVEY LINE
  - CULVERT
  - POWER POLE
  - TELEPHONE POLE
  - TREES
  - PROPERTY LINE
  - R.O.W. TAKING LINE
  - SLOPE RIGHTS
  - TOP OF CUT
  - T.O.E. OF SLOPE

ST. ALBANS BP 019-5-7507  
 RECORD PLANS  
 MATERIALS  
 SUBBASE OF GRAVEL  
 GRANULAR BORROW  
 SEED, FERTILIZER  
 ASPHALT  
 BITUMINOUS CONCRETE PAVEMENT-PIKE INDUSTRIES, SWANTON, VT.  
 CONTRACTOR STATE OF VERMONT, DISTRICT 8  
 PROJECT BEGUN JUNE 2, 1975 COMPLETED JANUARY 7, 1976  
 RECORD PLANS - P.F.W. FEBRUARY 3, 1976

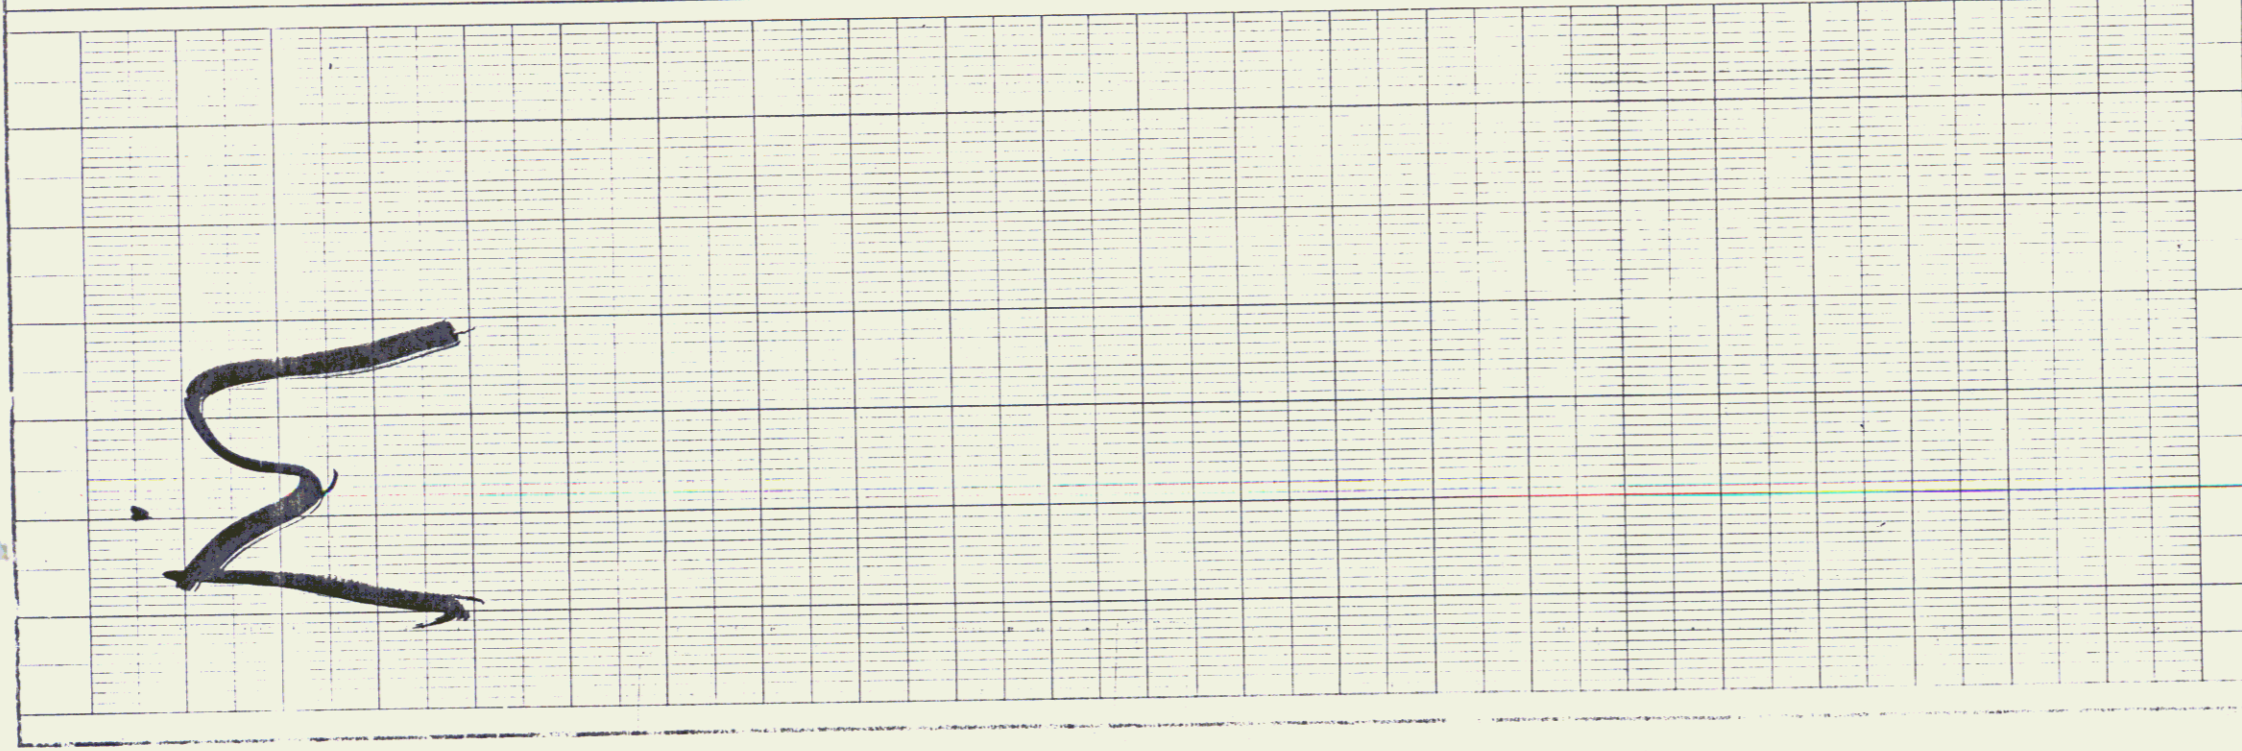

ITEM NO	ITEM	UNIT	NET	TOTAL	FINAL
201.16	Removing Large Trees to Right of Way	EA	1		1
203.16	Common Excavation	CY	1		1.12
205.38	Earth Borrow - Granular Borrow	CY	44.0		44.0
301.15	Sub base of gravel	CU	1.28		2.11
404.40	Bituminous Concrete Pavement - Type 1	Ton	250		250
407.15	Asphalt Synthetic Binder Base	Ton	100		100
407.20	Synthetic Base Binder	Ton	100		100
407.25	Support for Synthetic Base Binder	Ton	100		100
407.30	Synthetic Base Binder	Ton	100		100
407.35	Asphalt Synthetic Binder	Ton	100		100
407.40	Asphalt Synthetic Binder	Ton	100		100
651.10	Seed	10	50		50
651.15	Fertilizer	Ton	1		1
651.20	Agricultural Limestone	Ton	1		1
651.25	Hay Mulch	Ton	1		1
653.10	Topsoil	CY	50		50
653.15	Signal Modification	EA	1		1
653.20	Signaling	EA	1		1

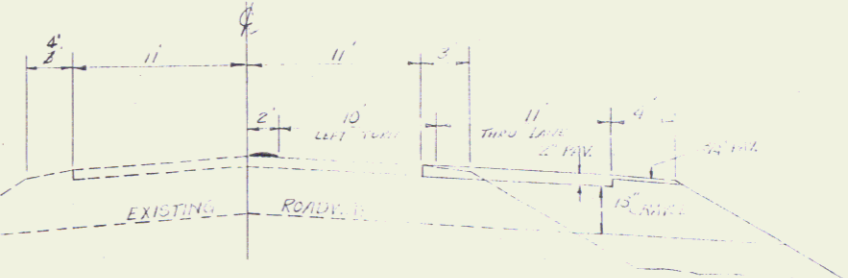

Sta. 46+00  
 TYPICAL SECTION

Pin # 992394

STATE OF VERMONT  
 DEPARTMENT OF HIGHWAYS

TOWN OF ST. ALBANS RTE. NO. US 7

BRIDGE NO. \_\_\_\_\_  
 LOG STA. \_\_\_\_\_  
 SURV STA. 40+00 - 42+00

DESIGNED BY WOF DATE Aug 74  
 DRAWN BY GAS DATE SEPT 74  
 CHECKED BY \_\_\_\_\_ DATE \_\_\_\_\_

Design Supervisor \_\_\_\_\_

PROJECT BP 019-5-7507

SUBMITTED BY ORDER OF THE STATE HIGHWAY BOARD

APPROVED E.H. Steinhilber DATE 1-2-75  
 CHIEF ENGINEER

APPROVED N.P. [unclear] DATE 12-2-74  
 DISTRICT ENGINEER