

WOOD GUARD RAIL REQUIRED
 LEFT
 STA 42+21 to STA 42+43 Length 22 ft.
 RIGHT
 STA 42+21 to STA 43+17 Length 96 ft.
 Total for Street → 118 ft.


RELAYING PIPE CULVERTS
 STA 46+30 Right 34 ft.
 Concrete Class B (1-3/4"-2) 15 cu yds.

POR CONCRETE PAVEMENT
 4" SUB-BASE OF STONE STA 42+00 TO STA 47+00 1800 LIN FT.


FOR CONTINUOUS MACADAM
 12" SUB-BASE OF STONE STA 42+00 TO STA 47+00 1800 LIN FT.

DATE	BY	CHECKED	DATE
11.1.22	11.7.22		

1/2" Contour Interval

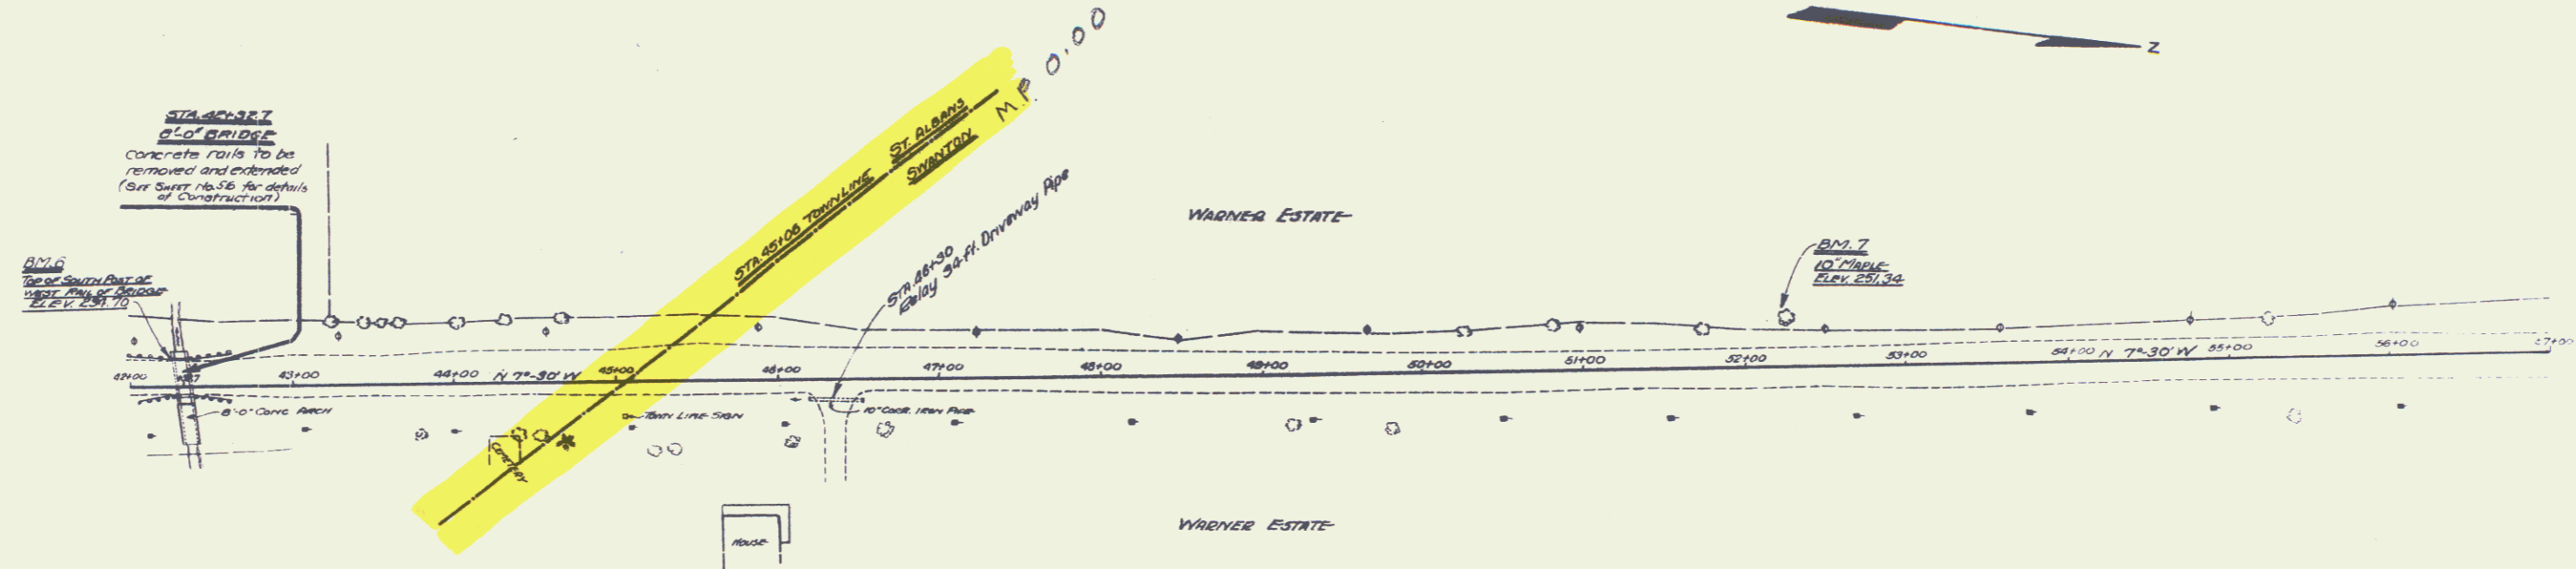

1/2" Contour Interval

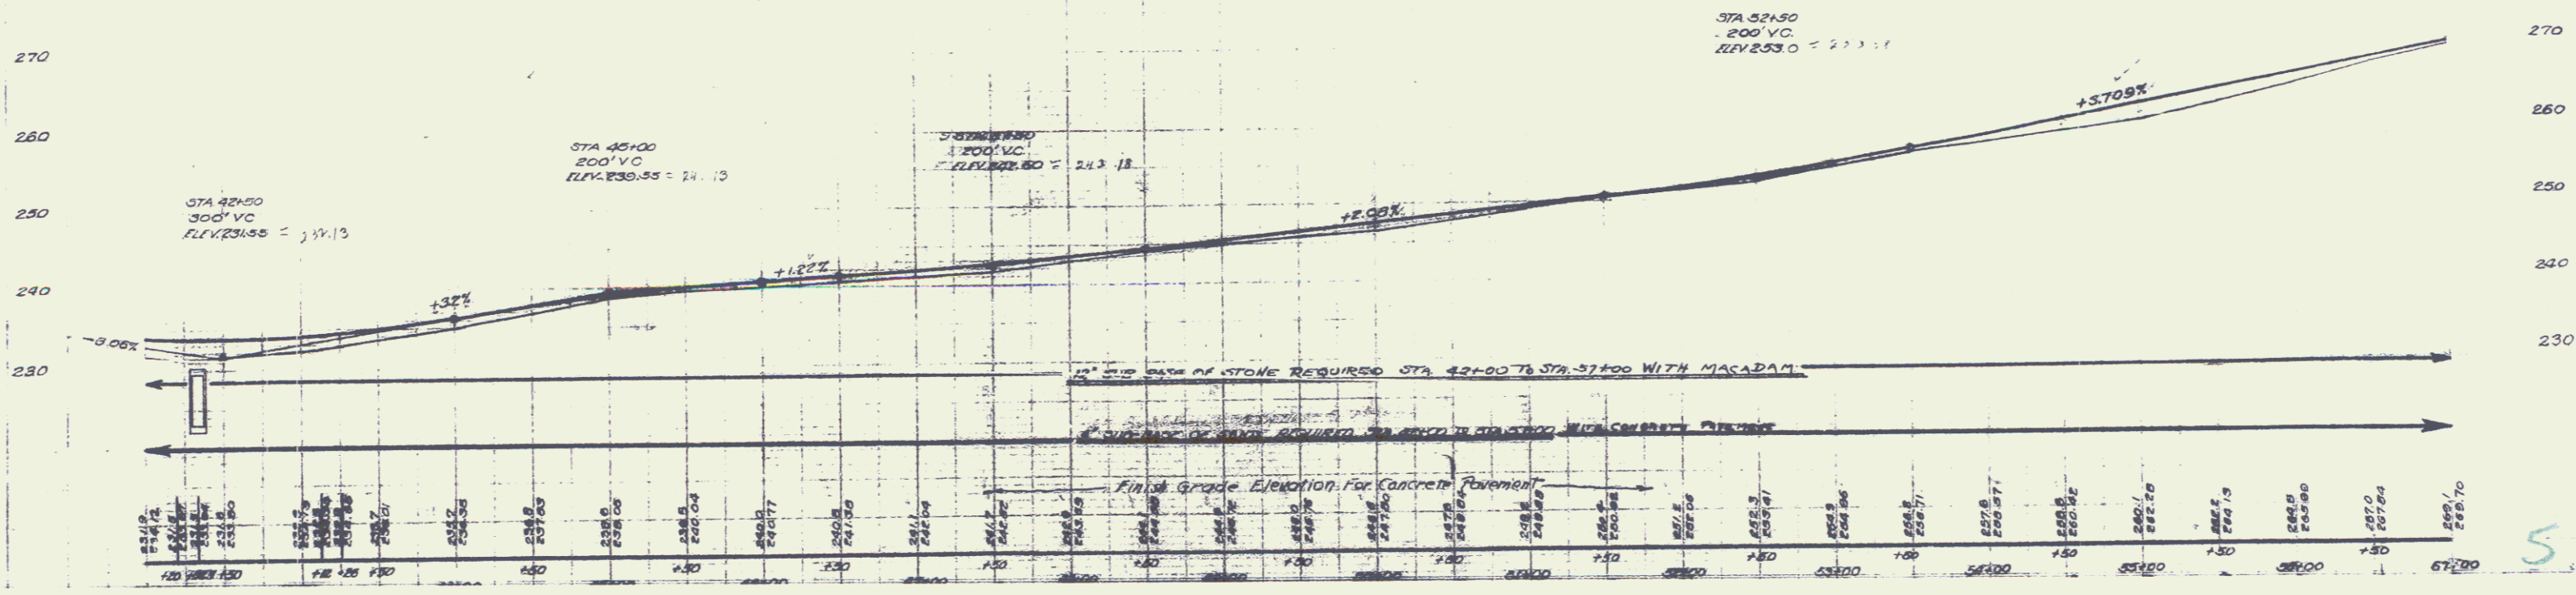

12" SUB-BASE OF STONE REQUIRED STA 42+00 TO STA 47+00 WITH MACADAM

4" SUB-BASE OF STONE REQUIRED STA 42+00 TO STA 47+00 WITH CONCRETE PAVEMENT

Finish Grade Elevation for Concrete Pavement

41+00	41+10	41+20	41+30	41+40	41+50	41+60	41+70	41+80	41+90	42+00	42+10	42+20	42+30	42+40	42+50	42+60	42+70	42+80	42+90	43+00	43+10	43+20	43+30	43+40	43+50	43+60	43+70	43+80	43+90	44+00	44+10	44+20	44+30	44+40	44+50	44+60	44+70	44+80	44+90	45+00	45+10	45+20	45+30	45+40	45+50	45+60	45+70	45+80	45+90	46+00	46+10	46+20	46+30	46+40	46+50	46+60	46+70	46+80	46+90	47+00
-------	-------	
5