
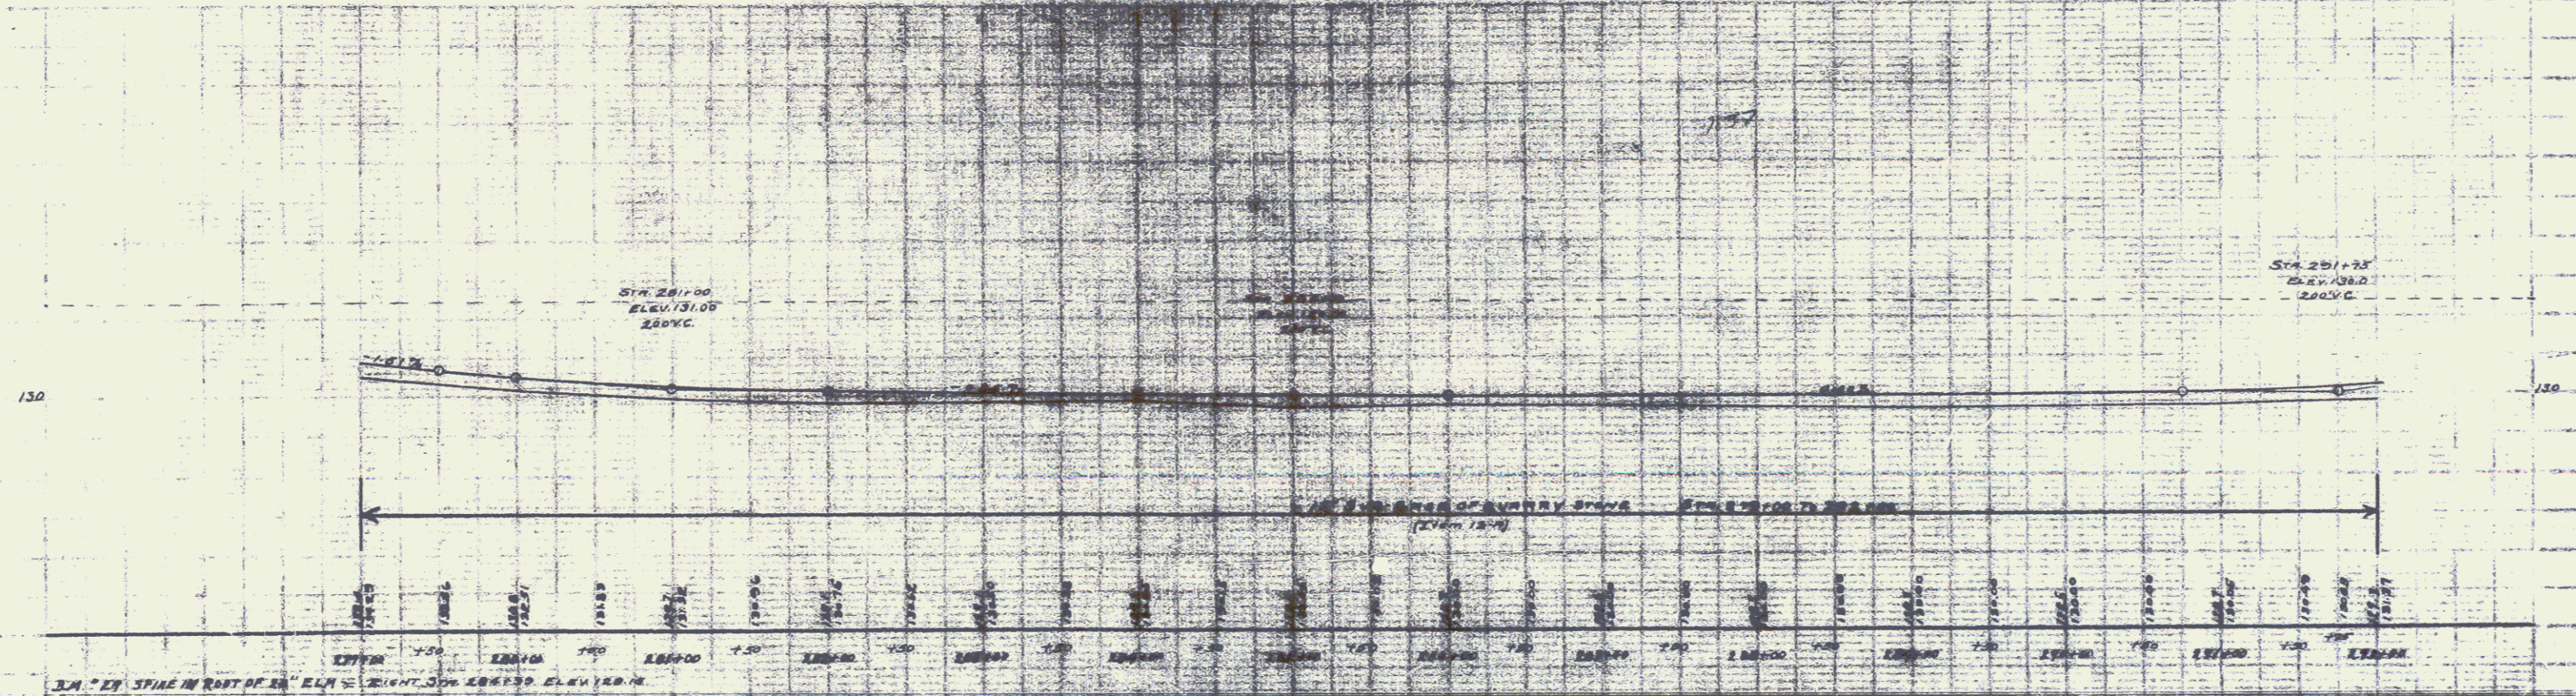


3/4" 200000 ft. 2000 ft. Length 2000
 3/4" 200000 ft. 2000 ft. Length 2000
 3/4" 200000 ft. 2000 ft. Length 2000
 3/4" 200000 ft. 2000 ft. Length 2000

SHEET NO. 67
 TOTAL SHEETS 77
 DATE 10-2-1926

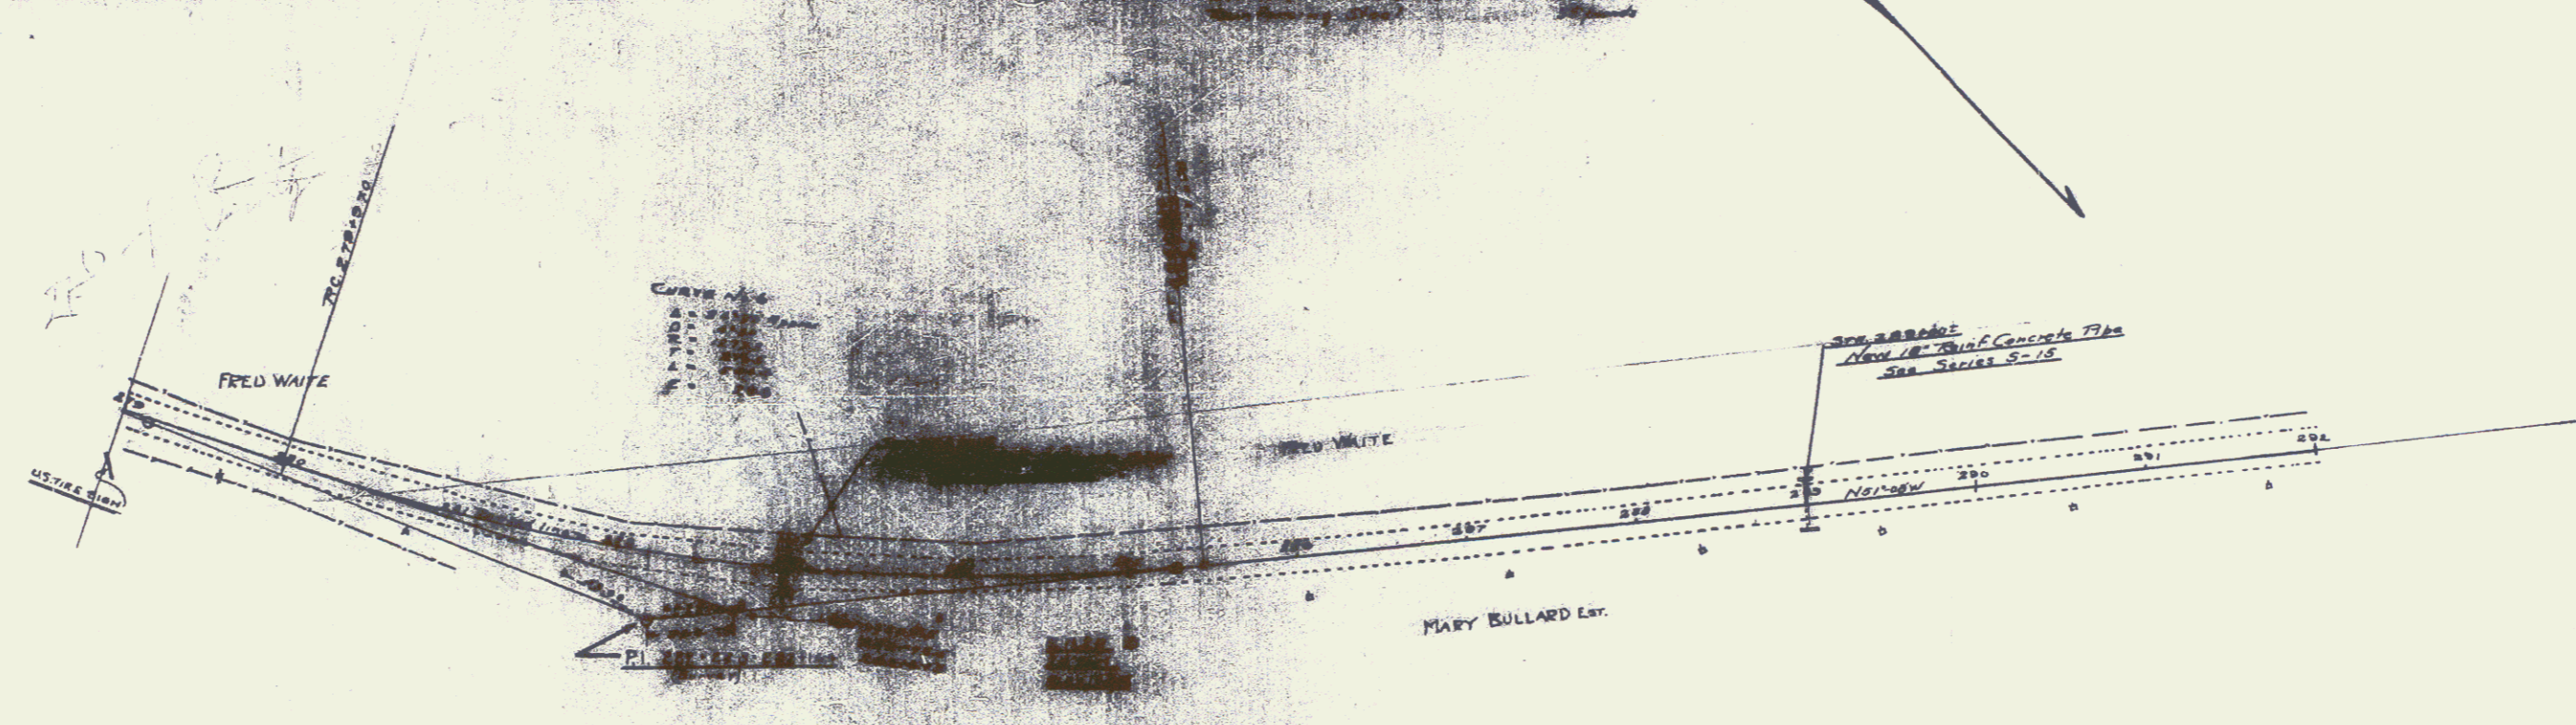

1/4" = 10' VERTICALLY
 1/4" = 10' HORIZONTALLY