
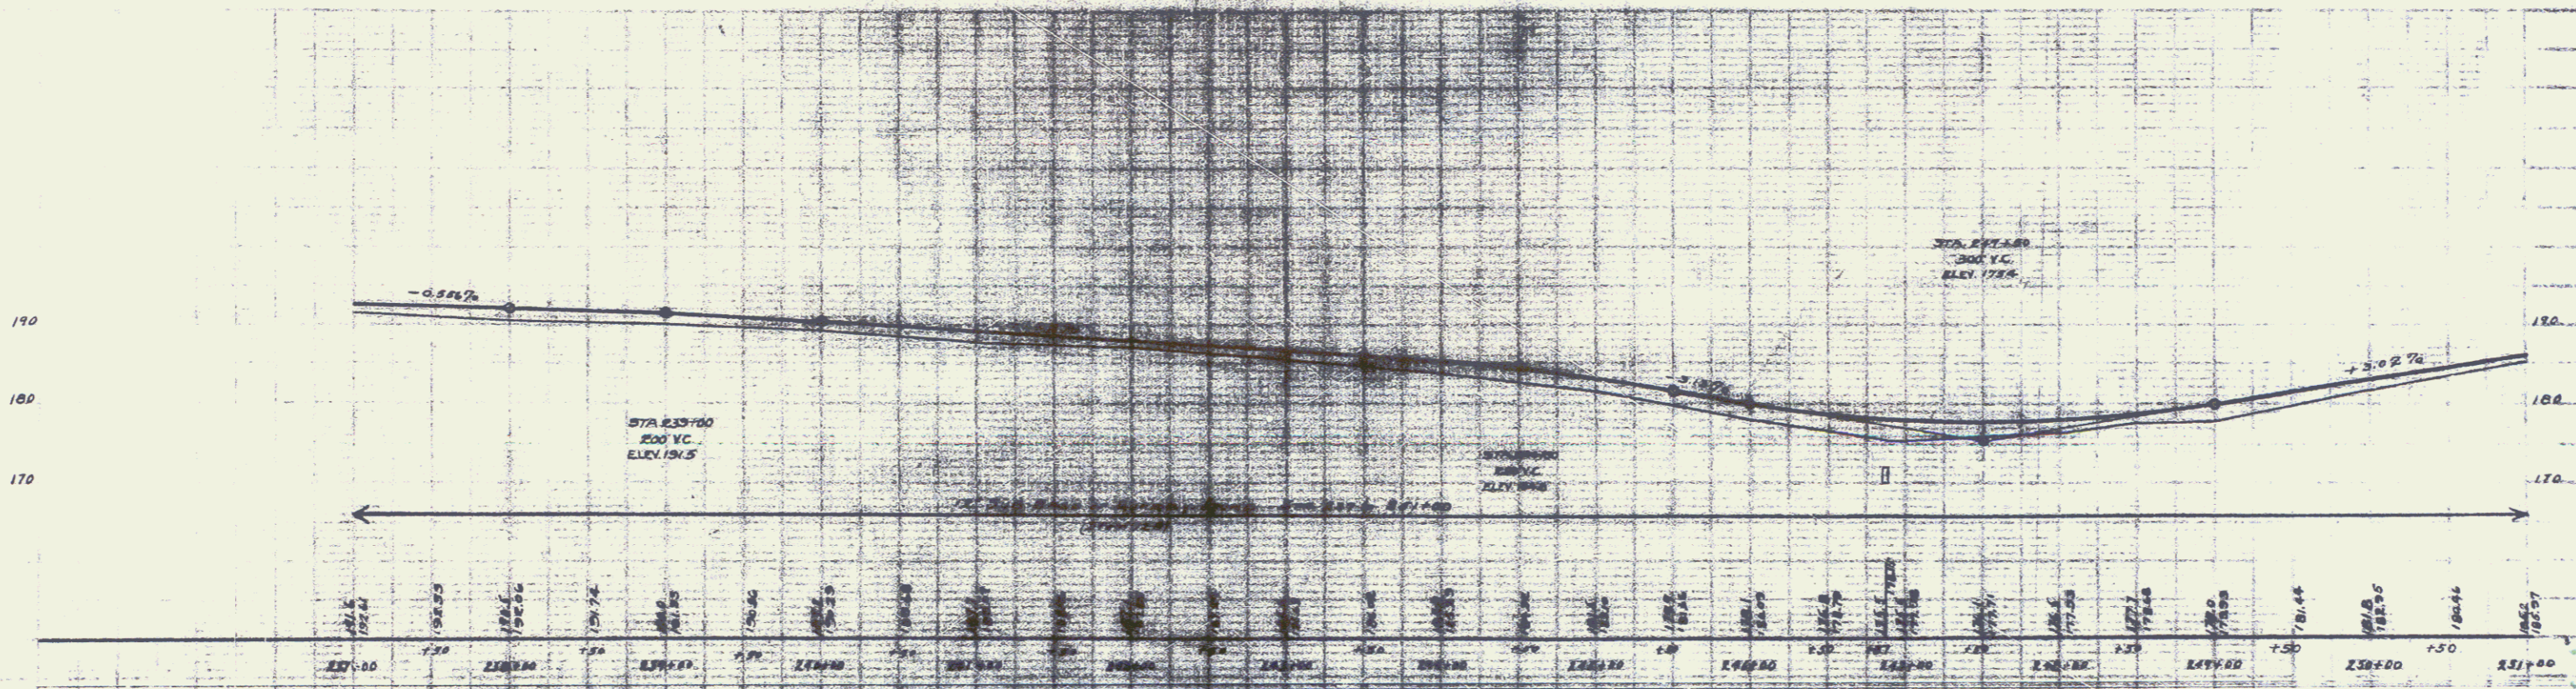




WOOD SHIELD PILE REQUIRED
LEFT
 Sta. 246+75 to 246+88 Length 24 ft

CABLE GUARD PILE REQUIRED
RIGHT
 Sta. 246+70 to 246+90 Length 200 ft

NEW CURBETS REQUIRED
 Sta. 246+87 to 246+90
 Concrete Class II (1-2) of 24" Curbs
 Reinforcing Steel 1500 pounds

PROJECT NO. 102
 SHEET NO. 12
 TOTAL SHEETS 17

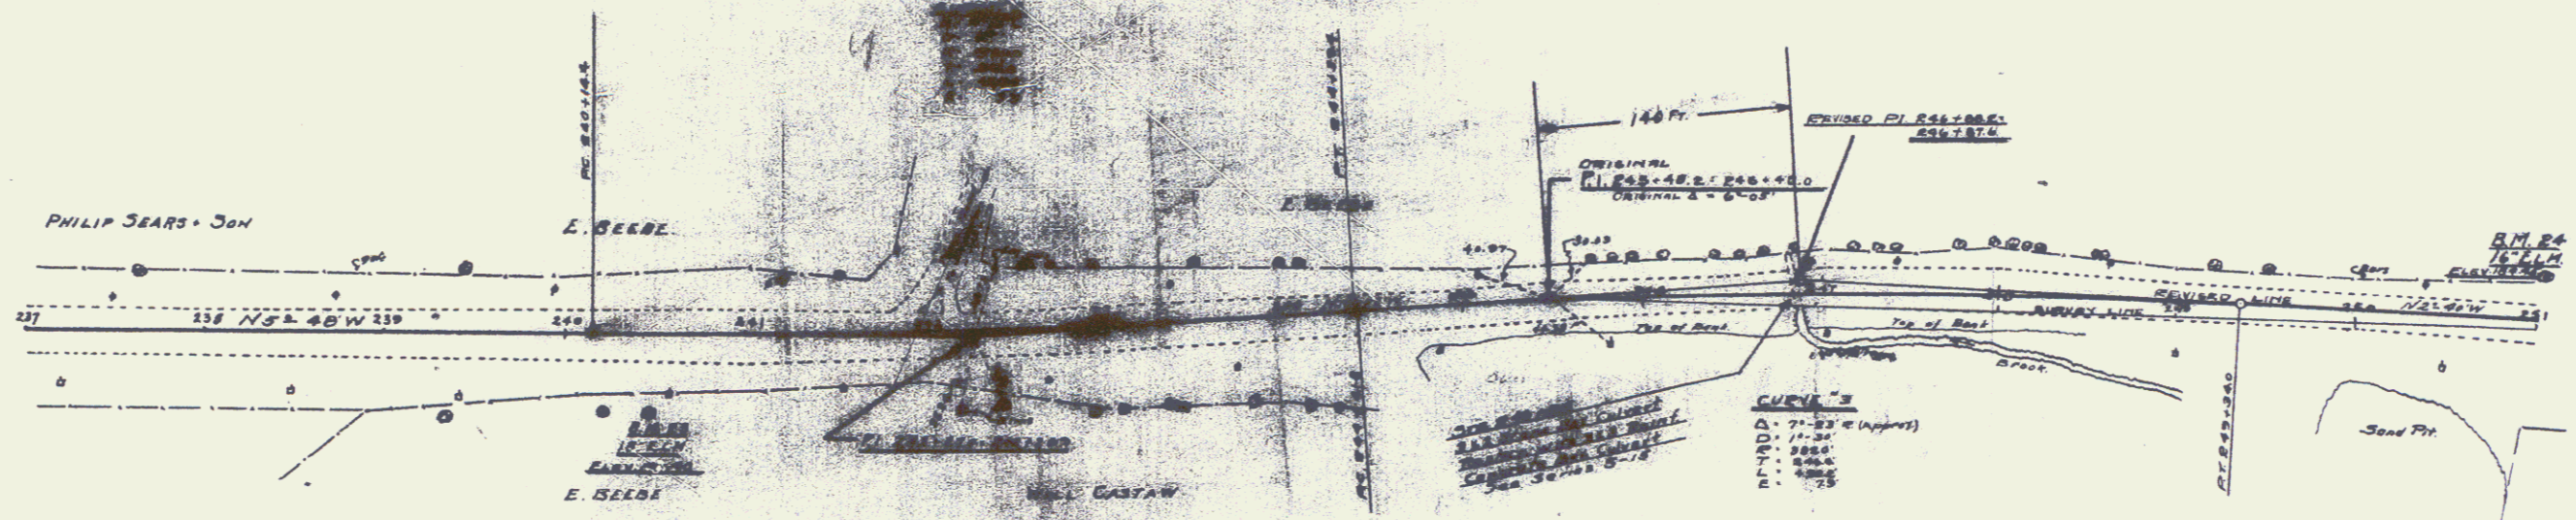

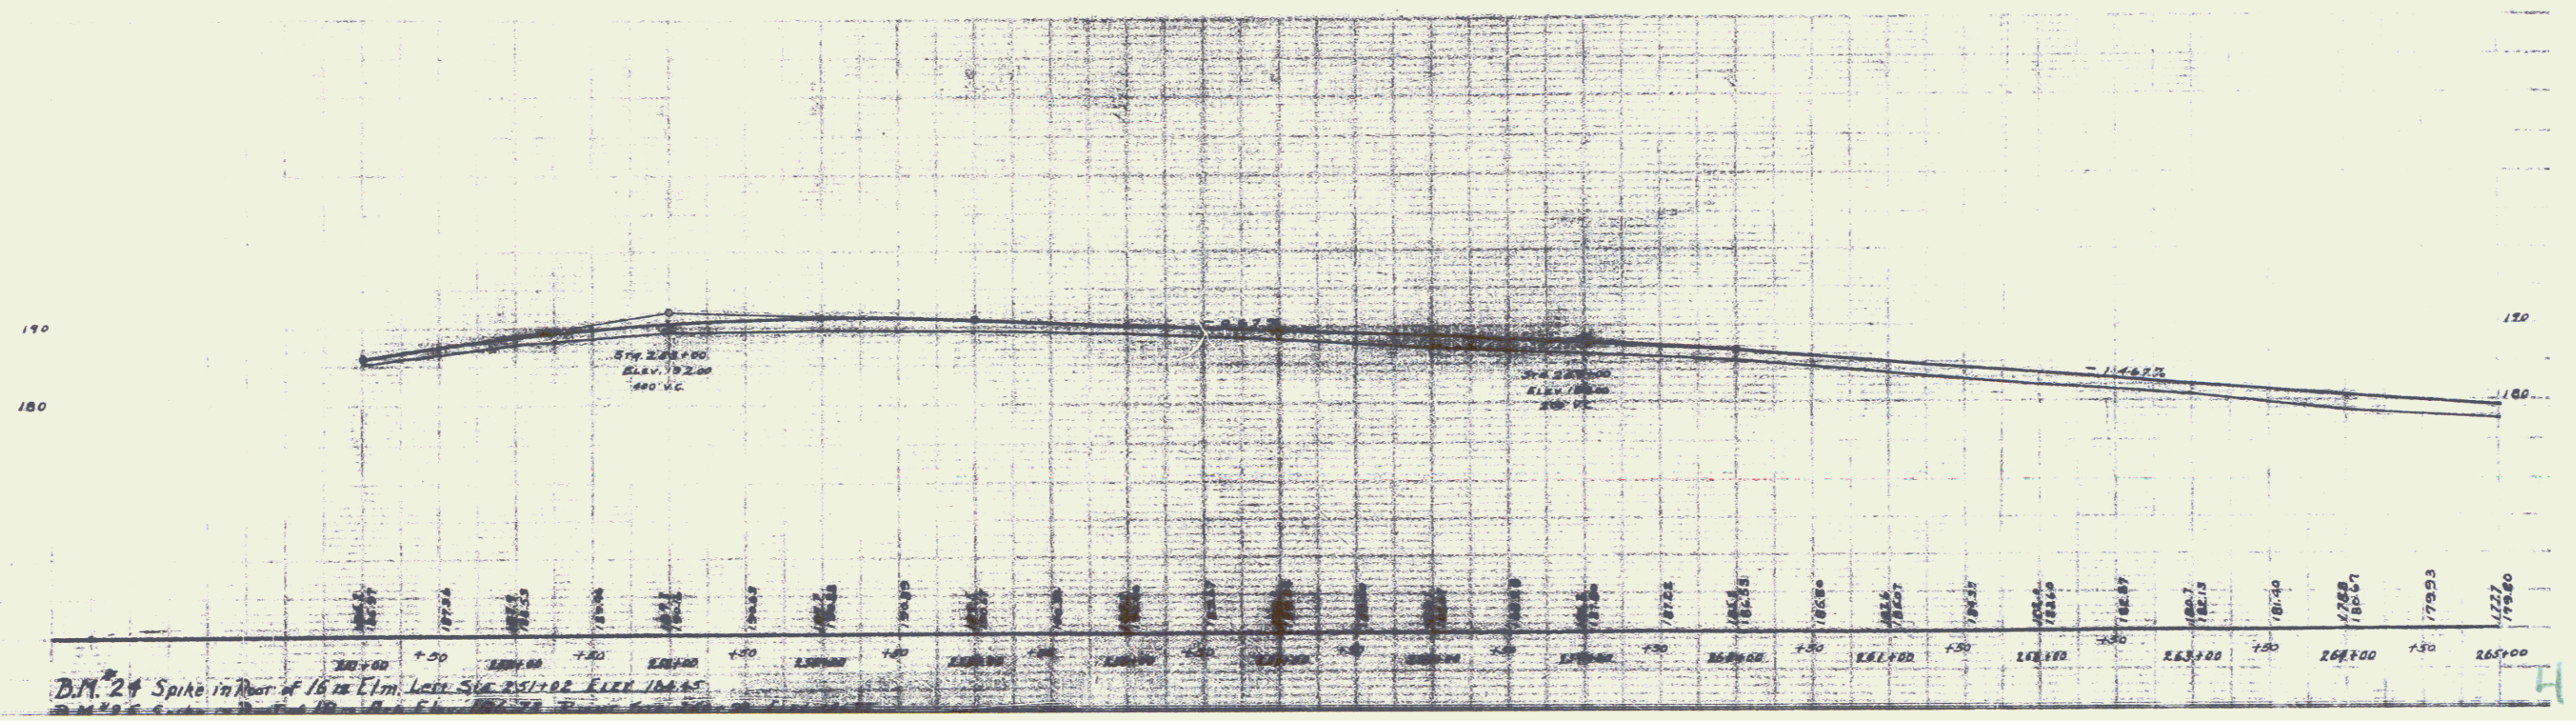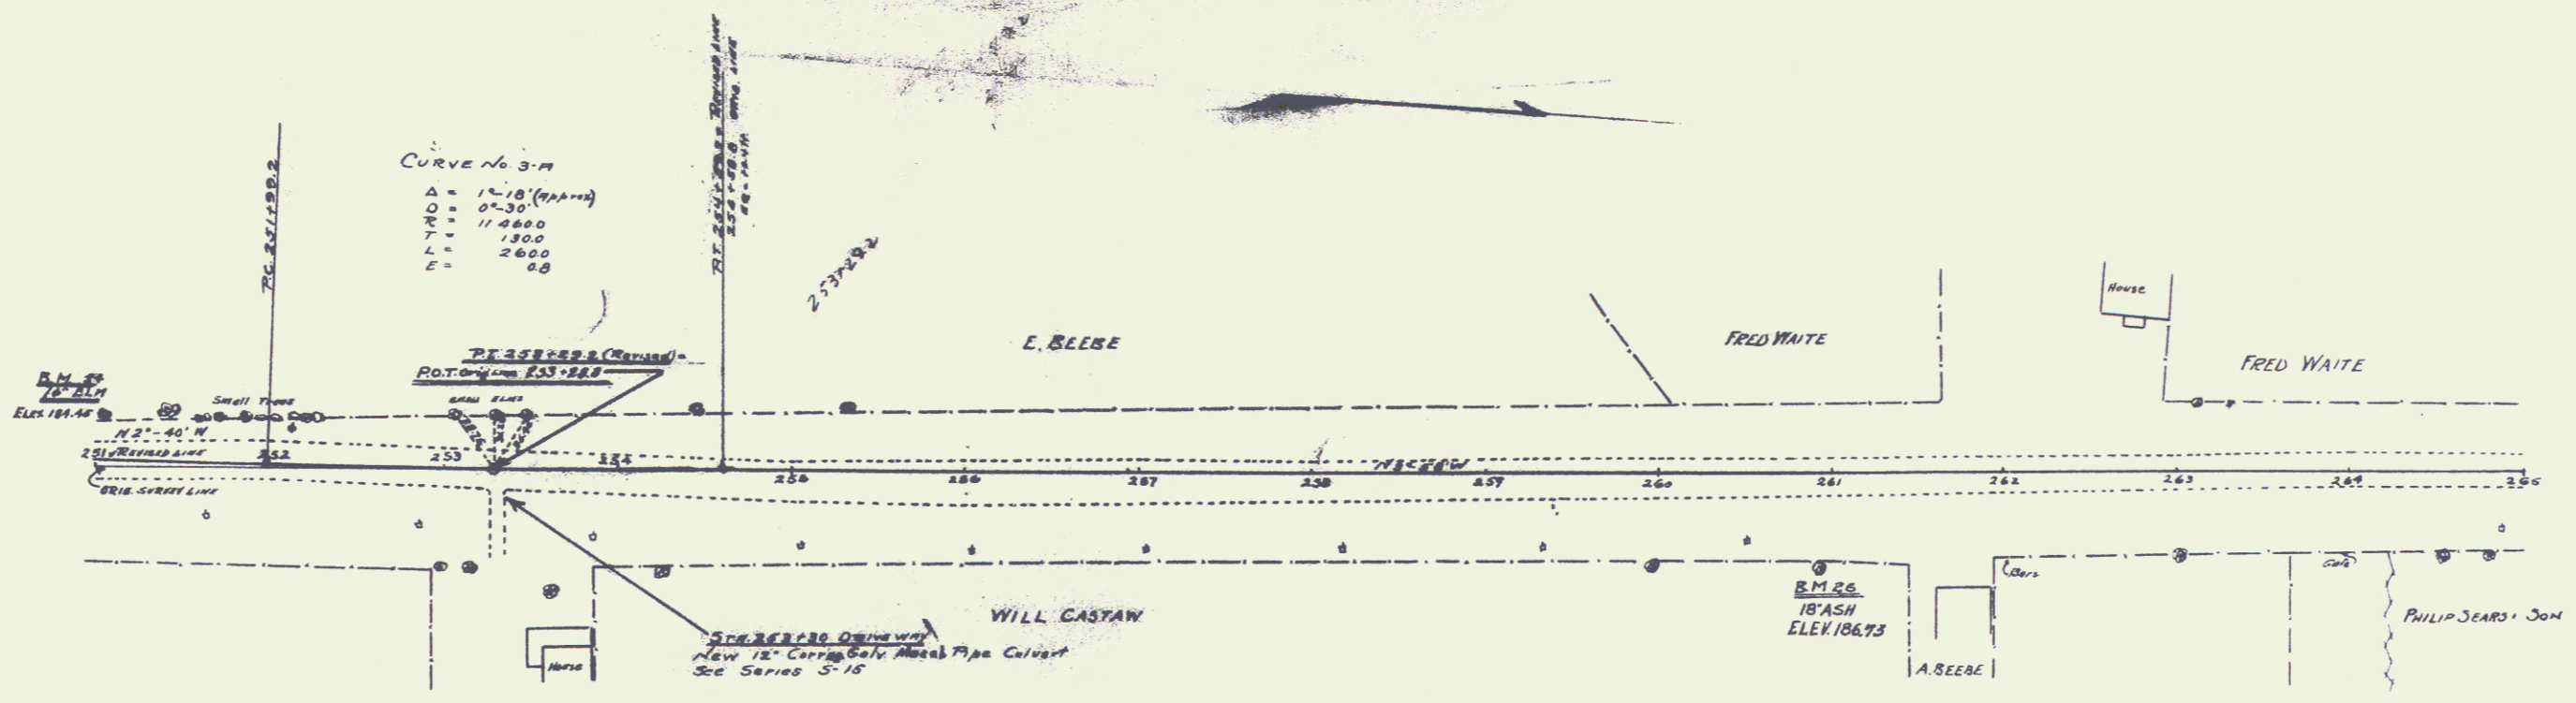

Sta 228+00 to 230+00	Length	200.00
Sta 230+00 to 232+00		200.00
Sta 232+00 to 234+00		200.00
Sta 234+00 to 236+00		200.00

ST. NO. 1123
 W 62-E 1926

