


$\Delta 30-19LT$	$\Delta 50-19LT$
D 4	D 3-45
R 1432.7	R 1528.2
T 672.9	T 717.6
L 1257.9	L 1341.8
E 1501	E 1602

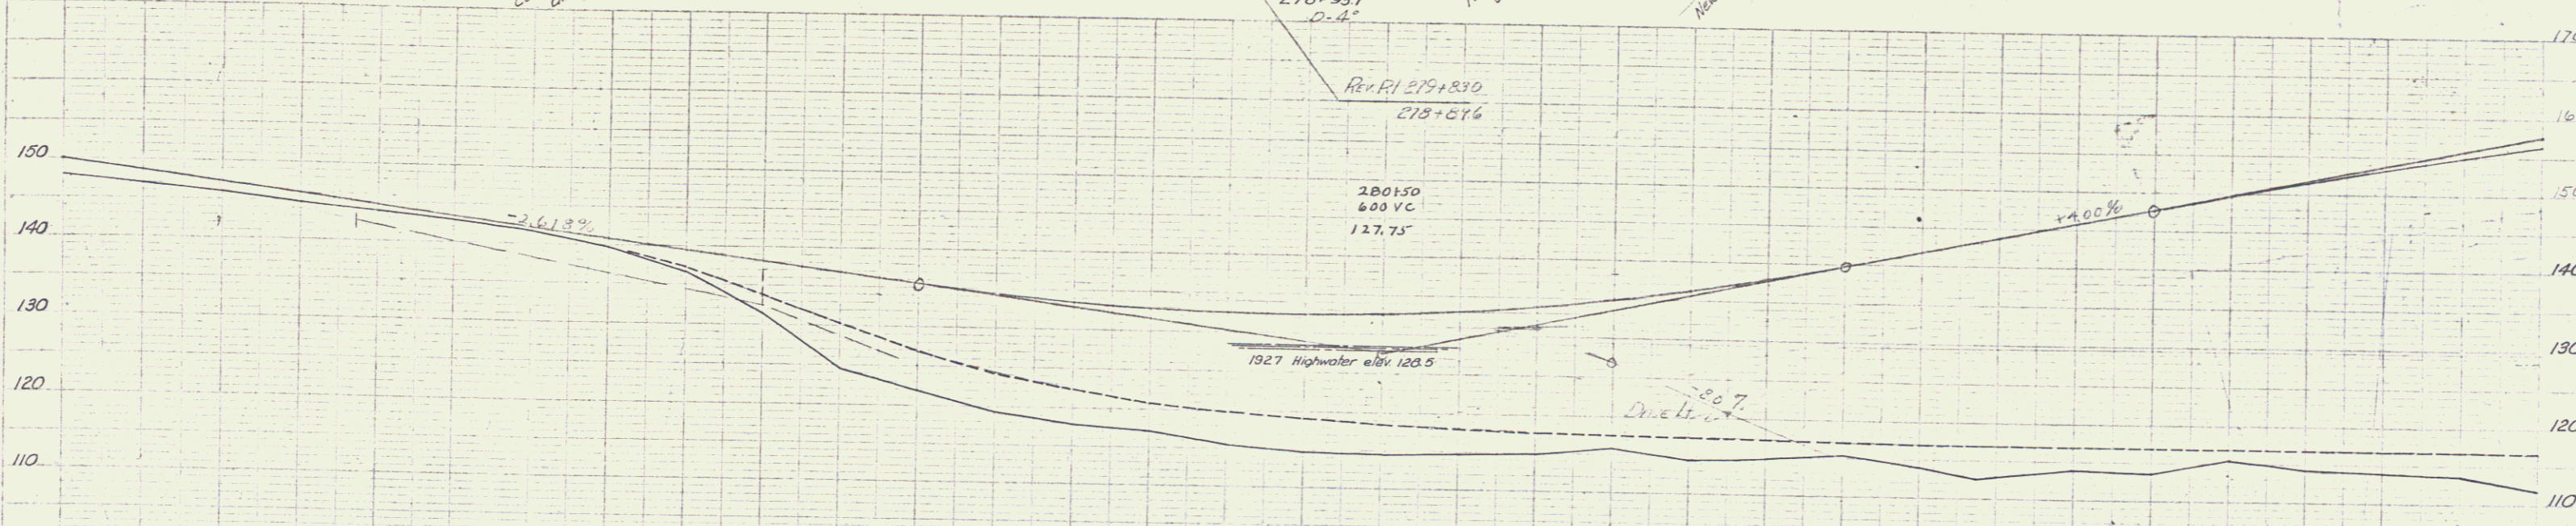

1479	1469	1459	1447	1439	1429	1417	1397	1366	131.3	124.4	122.0	1192	1179	117.1	115.7	114.3	114.7	114.3	114.9	115.9	114.4	114.5	114.5	114.0	112.9	114.0	113.8	115.6	114.2	114.0	113.7	111.9		
272	+50	273	+50	274	+50	275	+50	276	+50	277	+50	278	+50	279	+50	280	+50	281	+50	282	+50	283	+50	284	+50	285	+50	286	+50	287	+50	288	+50	289

B.M. 3 SPIKE IN ROOT 30' ELM 30' LT STA 274+38 ELEV 145.64
 B.M. 4 SPIKE IN 24' STUMP 102' RT STA 277+29 ELEV 133.21
 B.M. 5 SPOT ON HEADWALL 90' RT STA 282+79 ELEV 117.05