

Highgate '26

INDEX OF SHEETS

SHEET NO.	TITLE PAGE
2	TYPICAL CROSS-SECTION OF IMPROVEMENT
3	PLAN AND PROFILE STA. 0+00 - 13+00
4	" " " " 13+00 - 23+00
5	" " " " 23+00 - 45+00
6	" " " " 45+00 - 60+00
7	" " " " 60+00 - 73+00
8	" " " " 73+00 - 91+00
9	" " " " 91+00 - 105+91.6
10-17	Cross Sections

FED. DIST. AL.	STATE	PROJECT NO.	YEAR	SHEET NO.	TOTAL SHEETS
9	Vt	82-A	1926	17	17

STATE OF VERMONT
STATE HIGHWAY DEPARTMENT



PLAN AND PROFILE OF PROPOSED
STATE HIGHWAY
FEDERAL AID PROJECT

TOWN OF HIGHGATE.

Pin# 99R 402

ST. ARMAND ROAD.

BEGINNING 425 FEET SOUTH OF
FIRST RAILROAD CROSSING NORTH OF SWANTON
AND EXTENDING NORTHERLY, 2.01 MILES
TO BEGINNING OF F.A.P. 34.

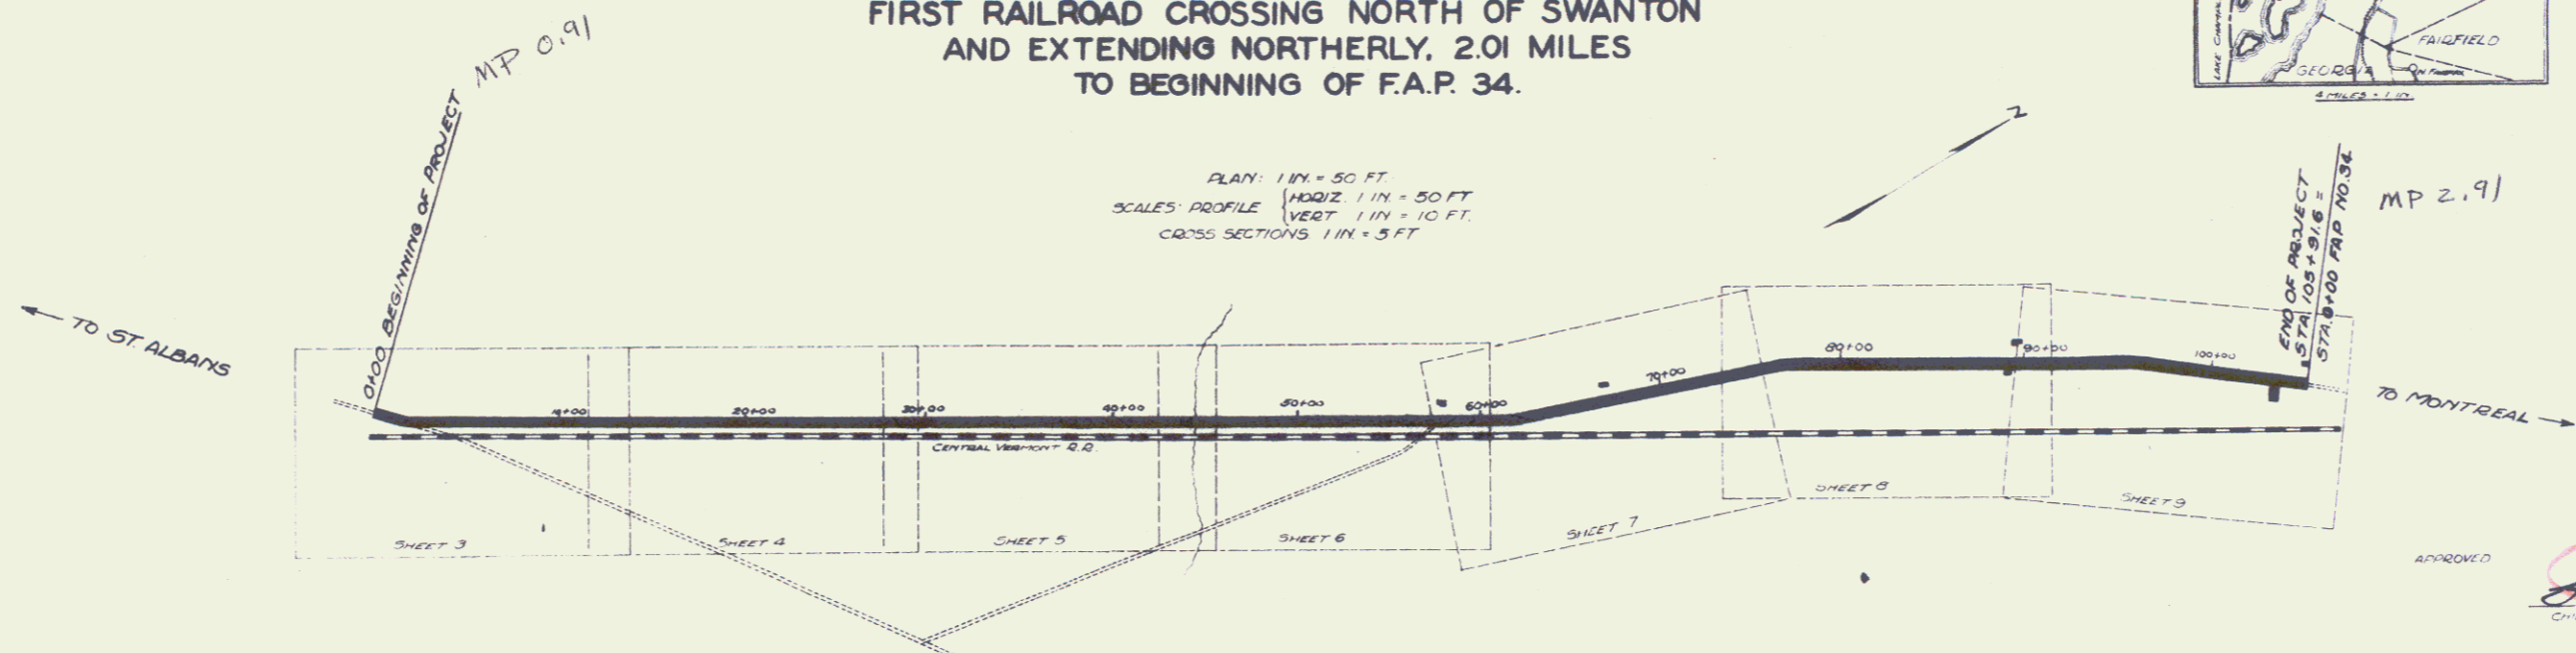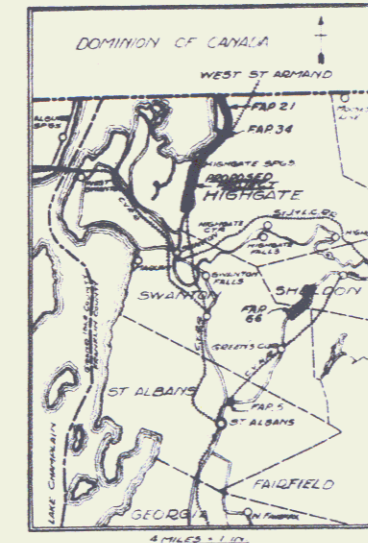

CONVENTIONAL SIGNS

COUNTY LINE	---	GROUND ELEVATION	DATE	LINE
TOWN LINE	---	GRADE ELEVATION	DATE	LINE
FENCE LINE	---			
STONE WALL	---			
UNFENCED PROPERTY	---			
GUARD RAIL	---			
TRAVELED WAY	---			
RAILROAD	---			
RETAINING WALL	---			
CENTER LINE	---			
SURVEY LINE	---			
CURVE DATA				
DEFLECTION ANGLE	Δ			
DEGREE OF CURVE	D			
RADIUS OF CURVE	R			
TANGENT DISTANCE	T			

LAYOUT
1 IN. = 500 FT.

us Rte 17

Project No. F.A.P. 82A

RECORD PLANS

APPROVED
A. S. Shiguet
CHIEF ENGINEER

SUBMITTED BY ORDER OF THE STATE HIGHWAY BOARD
DATE: 1926
A. H. Bates
COMMISSIONER OF HIGHWAYS

RECOMMENDED
DISTRICT ENGINEER
BUREAU OF PUBLIC ROADS
RECOMMENDED FOR APPROVAL
CHIEF ENGINEER
BUREAU OF PUBLIC ROADS
APPROVED