



Highgate '37

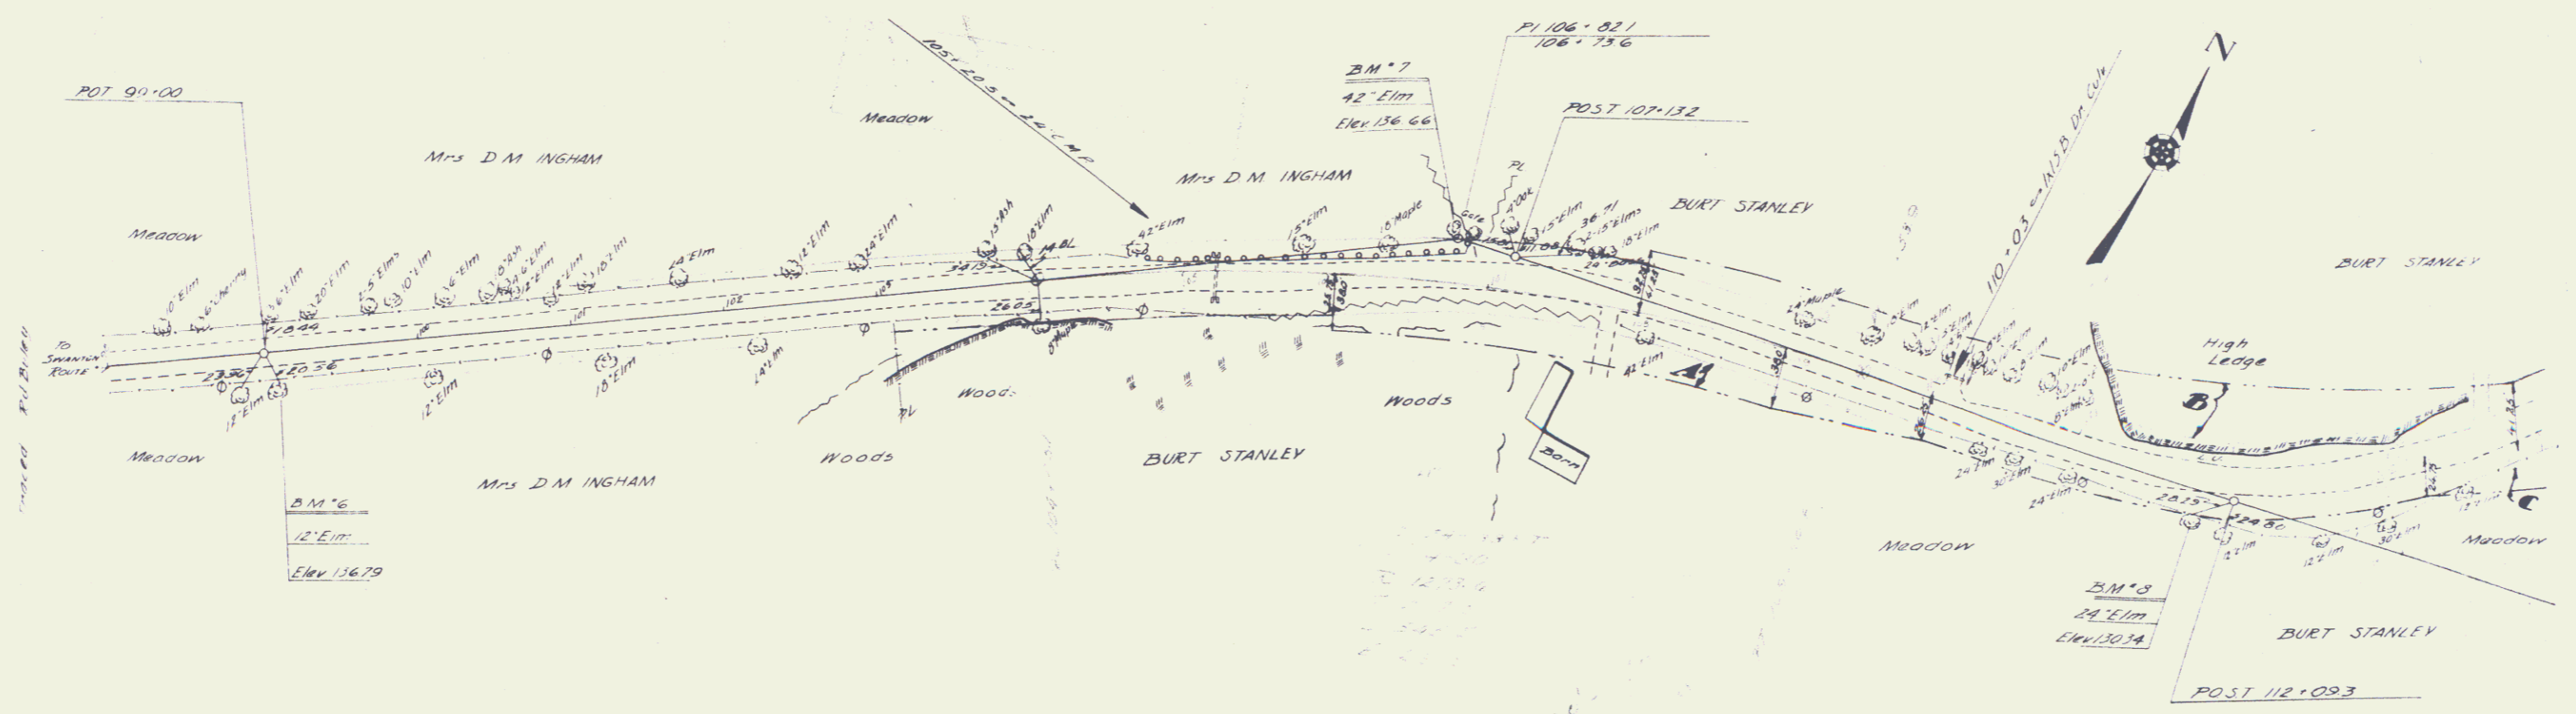

PARCEL	INSTRUMENT	DATE	GRANTOR	GRANTEE	RECORDED	REMARKS
ABC	W.D.	12-8-37	B. STANLEY	STANLEY	895 45	895 45 60-7 12-25-37

Town: Highgate
 Route: 45
 Project: FAP21, ST21L
 Pin # 99R405

1/1/36

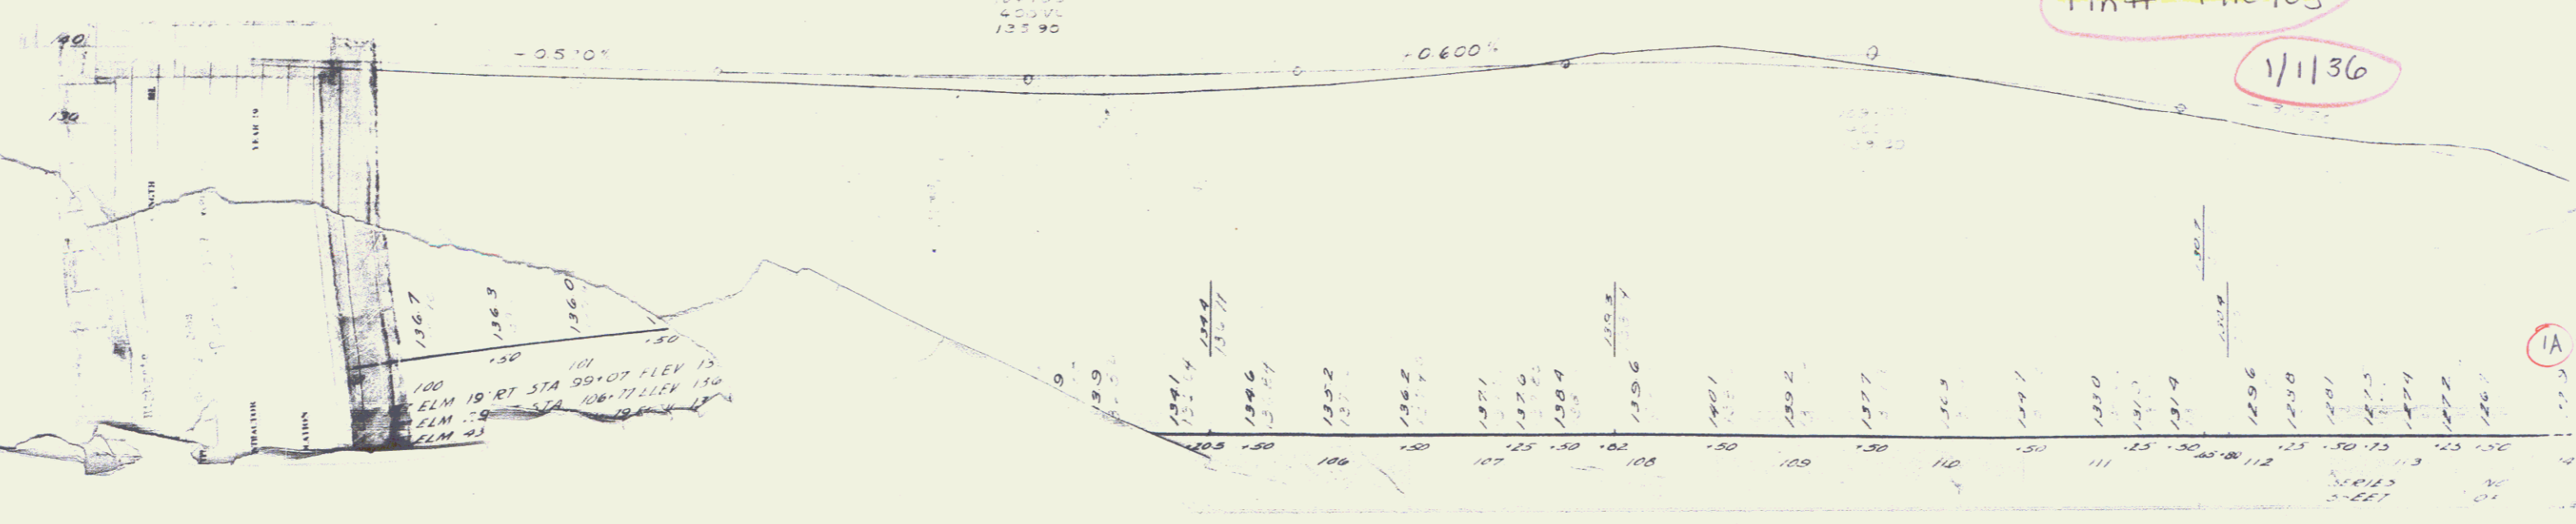

1A