


PARALLEL TO DATE OF
 INSPECTION
 AS N.B. 14-37 R.M. ° F.E. DEAL R.M. 49544-5 2-5-37

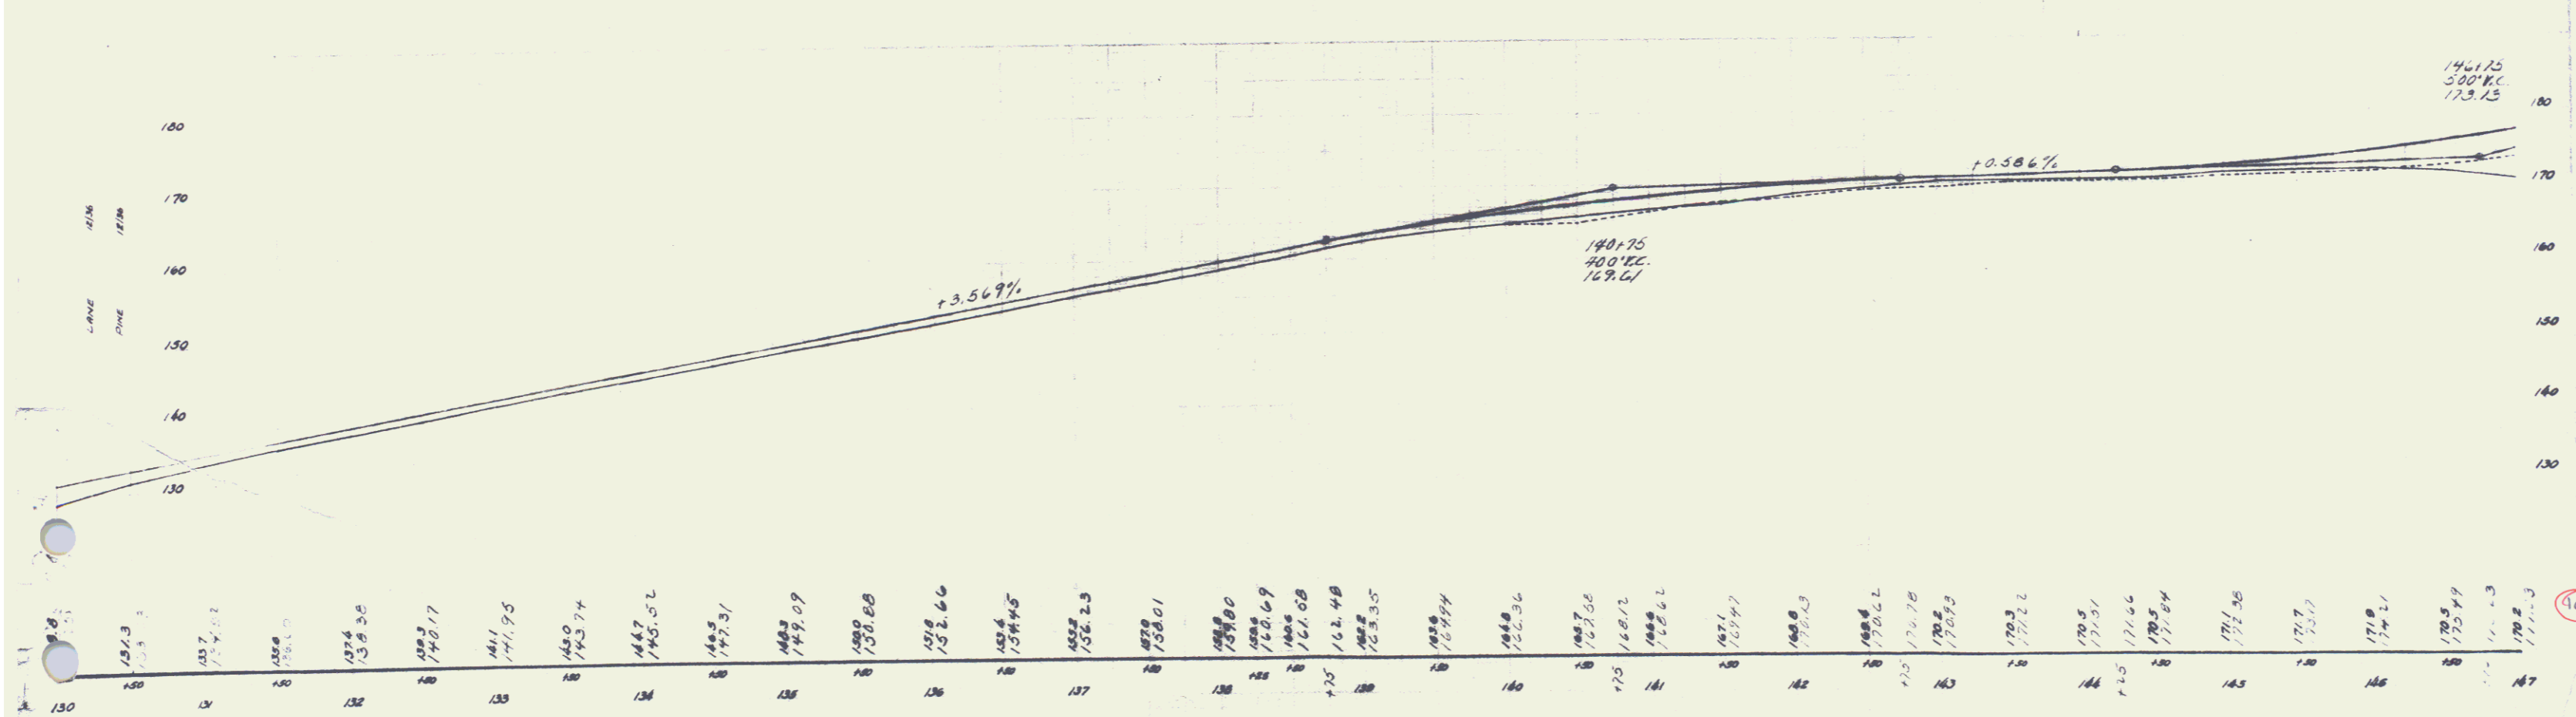

B.M. #1 SPIKE IN POST 6' ELM 3/4 FT LY - 378 132+00 ELEV. 141.80
 IN GROUND 6' - - - - - 137+85 ELEV. 168.20

SERIES 1.0
 SHEET 4 of 5 SHEETS

12
 3