


REV. CURVE
 10' 20'
 24.43
 4.49
 92.17
 37.5

ORIGINAL KIND OF DATE OF SURVEY INSTRUMENT SAMPLE SAMPLE RECORDED REMARKS
 10 N.O. 1-11-37 RUBY DEAL ST. Vt. # 544-5 2-5-37
 11 N.O. 2-10-37 CHARLES & FLOYD (BAGY) # 548-9 2-15-37

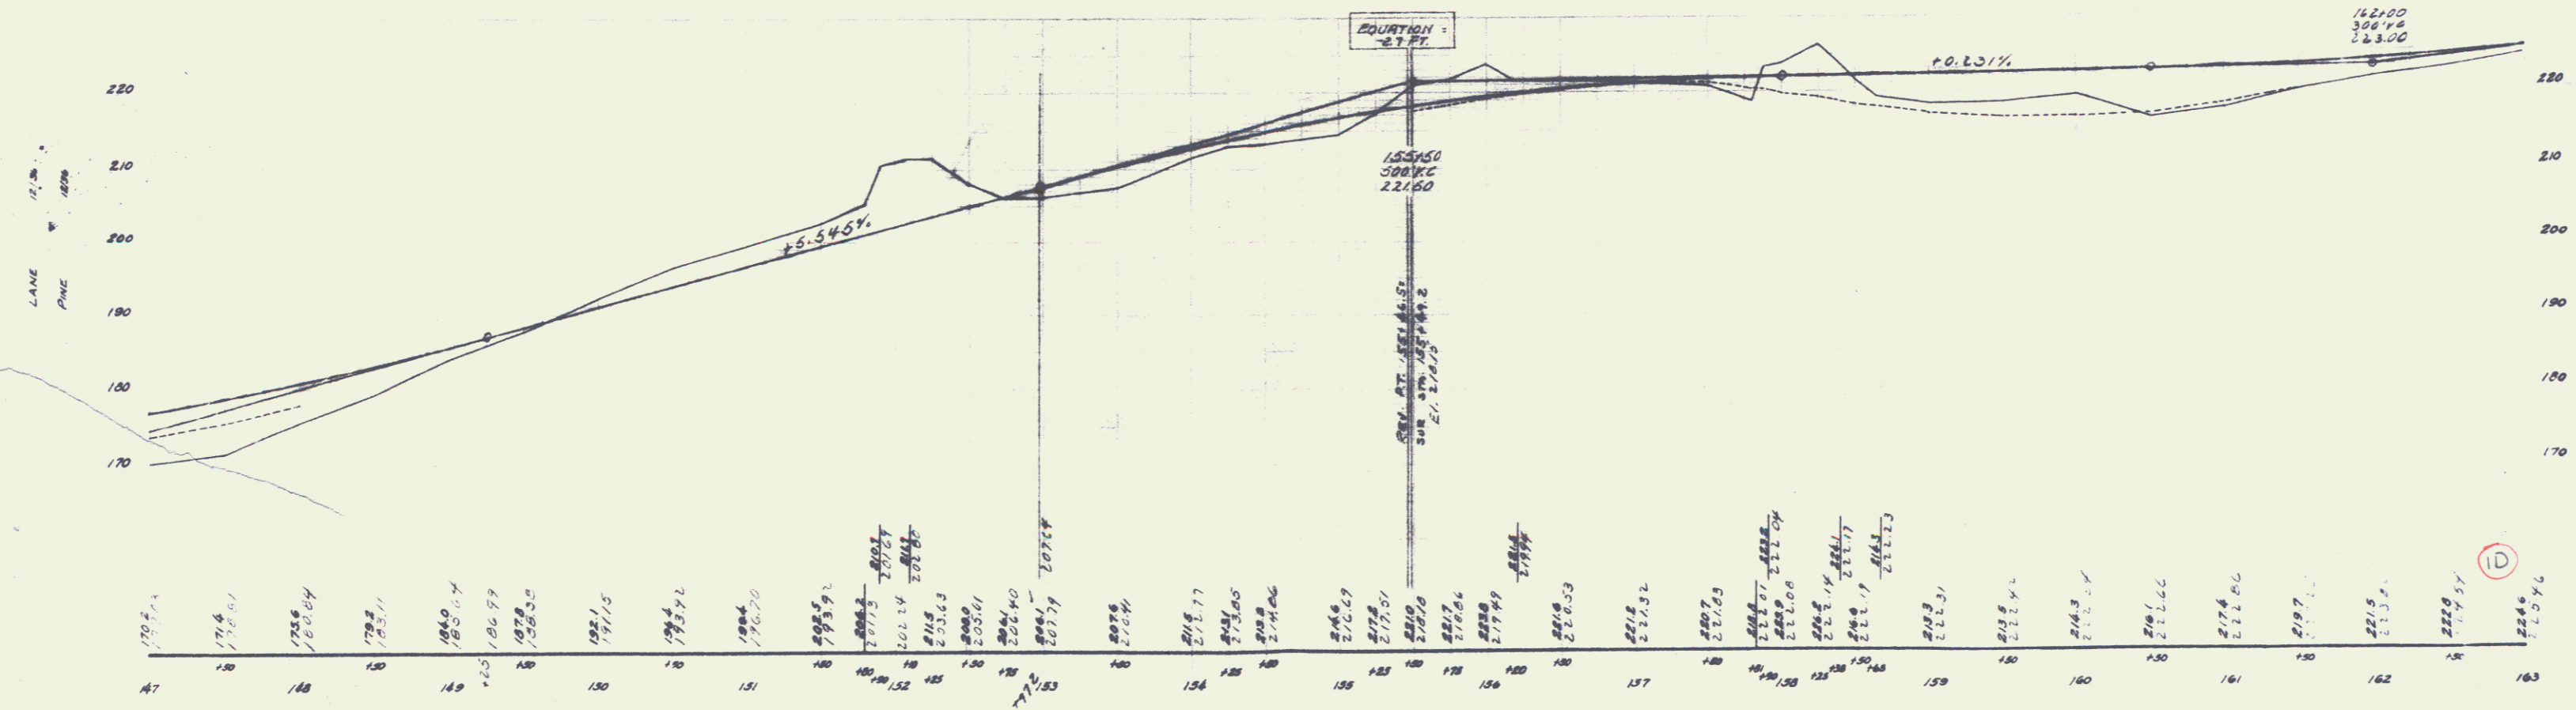

BM #3 SPIKE IN ROOT 18' OLM 30.5 FT. LT. STA 148+10 ELEV 177.95
 BM #4 " " " 36' APPLE 38 " RT. " 152+10 ELEV 207.76
 BM #5 " " " 15' OLM 40 " RT. " 157+72 ELEV 222.66

SERIES NO
 SHEET OF SHEETS 4