

WOOD GUARD RAIL REQUIRED

STATIONS	LEFT	RIGHT
66+38	24'	24'
70+09	24'	—

CABLE GUARD RAIL REQUIRED

STATIONS	LEFT	RIGHT
68+73-75+21	—	64B
77+25-78+00	—	75

NEW REINFORCED CONCRETE PIPE CULVERTS REQUIRED


STATIONS	DIA.	LENGTH	CONC. A	CONC. B	REIN. STEEL
66+38	18"	40'	—	3.0x	33 lbs
73+09	18"	48'	1.8x	—	34 lbs

GRADED COBBLE CUTTER REQUIRED

STATIONS	TYPE	WIDTH	LENGTH	AREA
68+60-69+00	R	4'-0"	30'	232 sq. yds.
70+00-73+50	L	4'-0"	350'	1533 sq. yds.
75+75-78+00	L	4'-0"	225'	1003 sq. yds.
73+30-73+75	L	4'-0"	25'	11 sq. yds.

PLAN SHEET S.F.A. 102-C (REV. 8) 48

NOTE
 THE SAND SLOPES ON THE LEFT ARE TO BE PROTECTED BY THE USE OF A BRUSH MAT WITH WOVEN WIRE FENCING THOROUGHLY STAKED DOWN. IF CONDITIONS AT TIME OF CONSTRUCTION OF THIS PROTECTION MAKE IT ADVISABLE, LOAM IS TO BE ADDED ON TOP OF THE BRUSH AND THE SAME SEEDED DOWN. THIS PROTECTION IS NOT INCLUDED AS PART OF THE CONTRACT BUT IS TO BE PERFORMED BY STATE FORCE ACCOUNT.

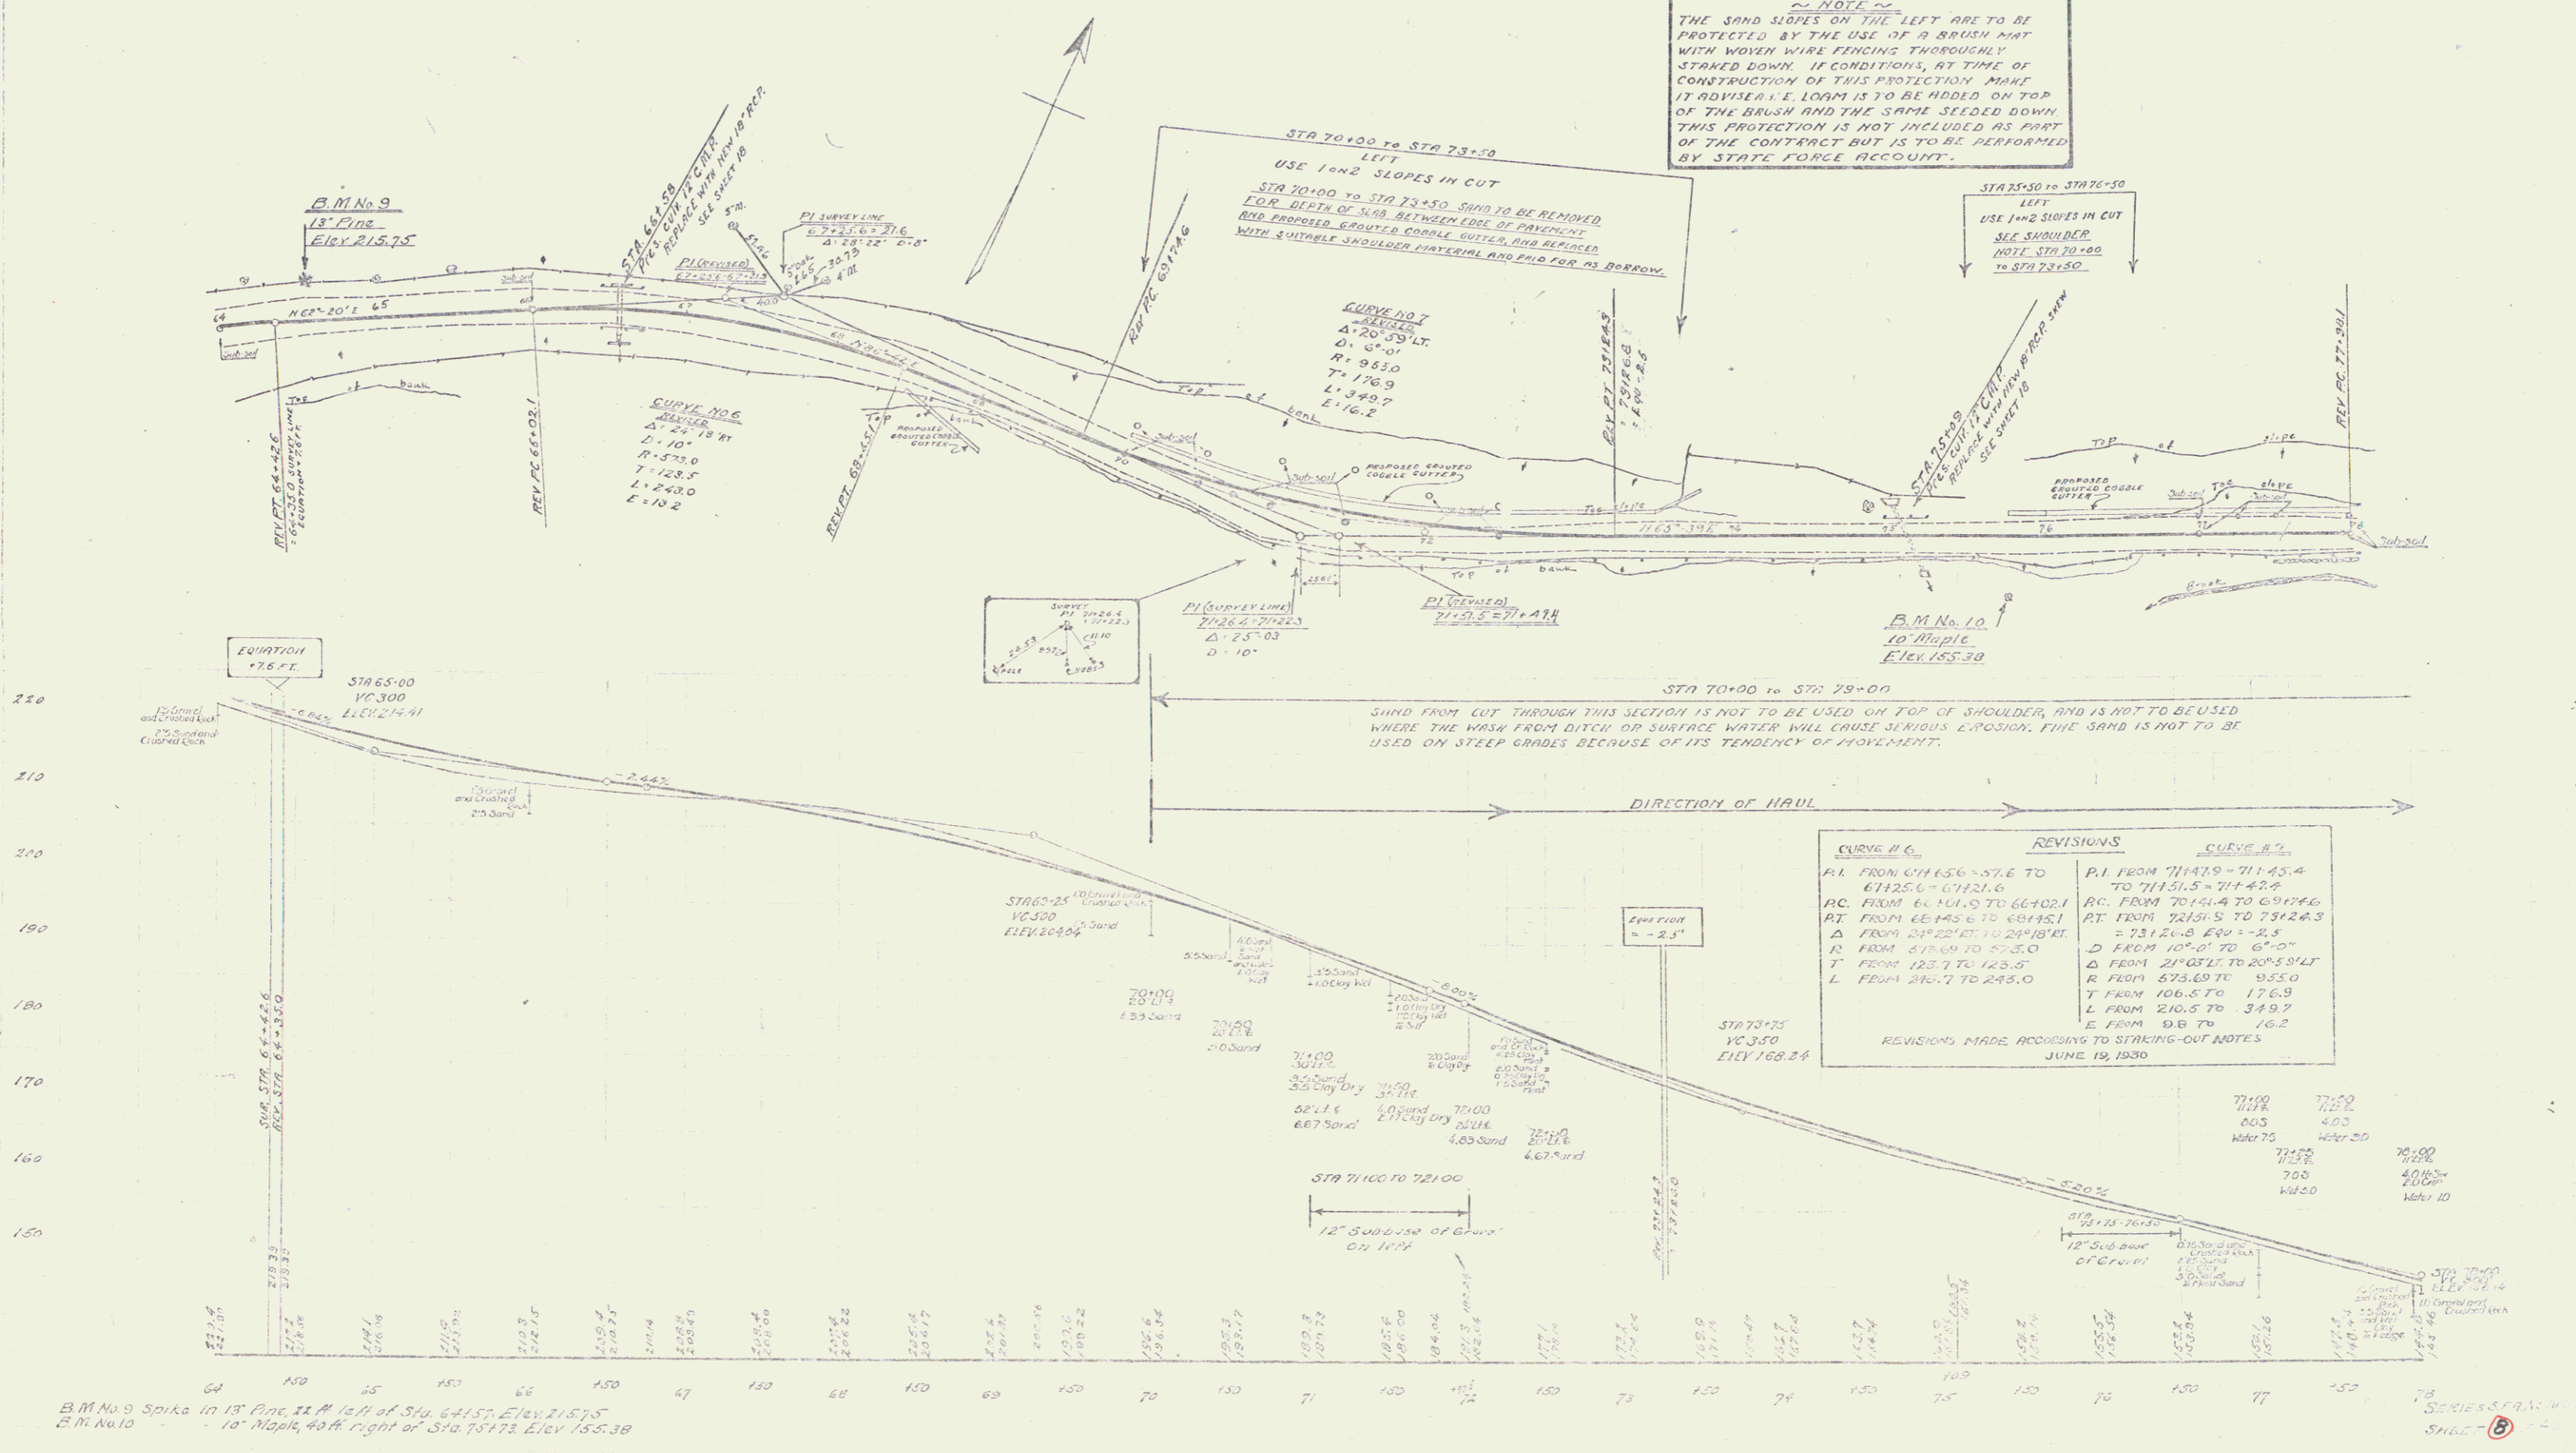

1928
 1929
 1930
B.M. No. 9 Spike in 13" Pine 21 ft. left of Sta. 64+57 Elev. 218.75
 B.M. No. 10 10" Maple 40 ft. right of Sta. 70+78 Elev. 156.38

SHEET 6