
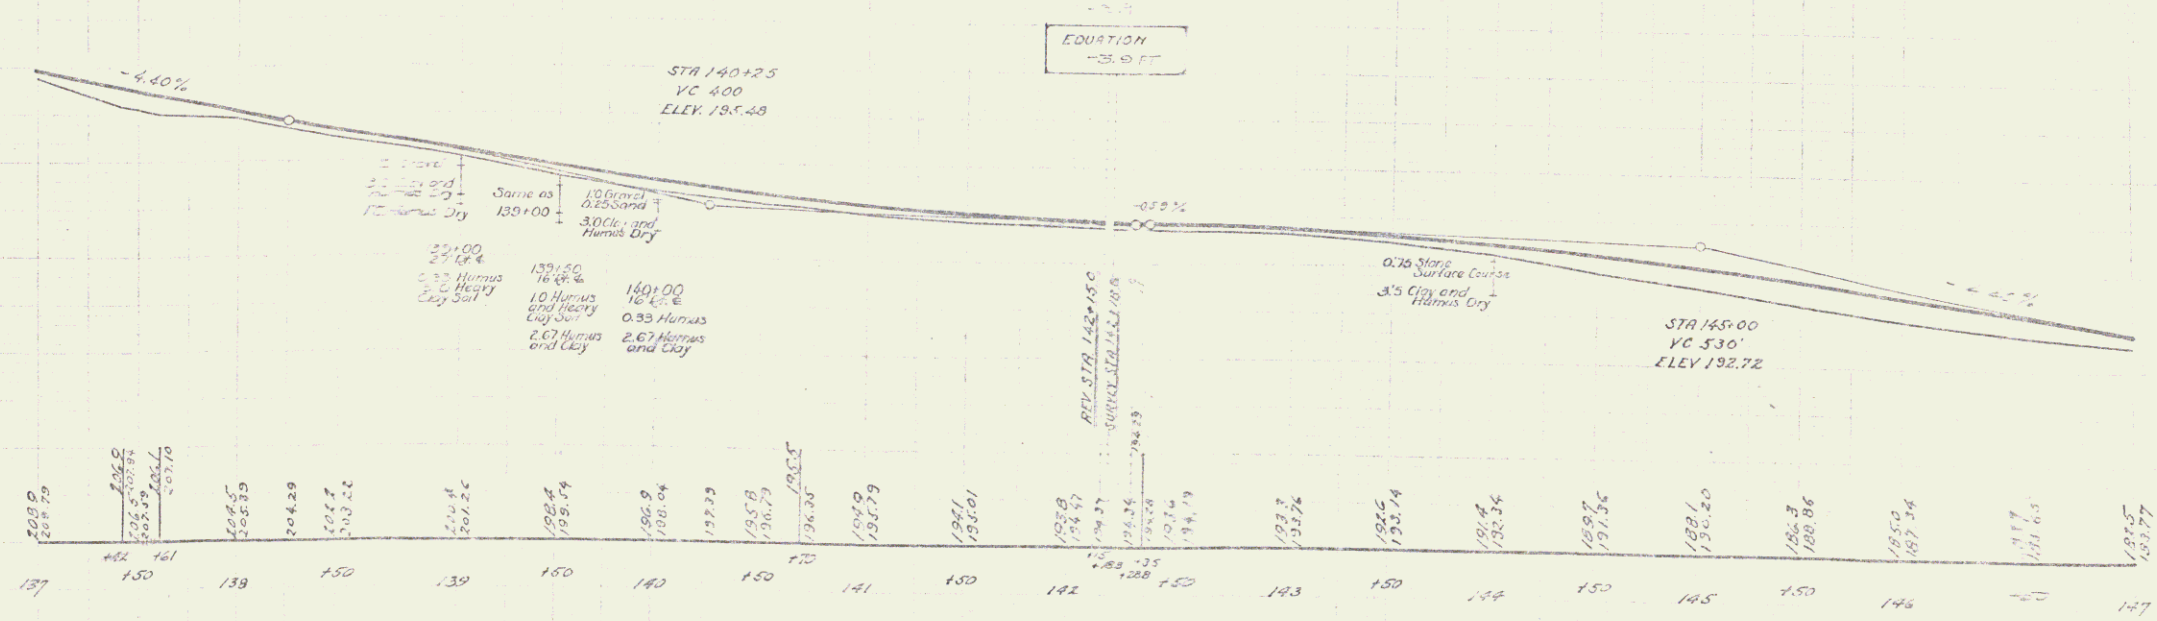


WOOD GUARD RAIL REQUIRED
 140+30 24' 10"

CABLE GUARD RAIL REQUIRED
 138+02-140+58 56'

NEW R/C CONCRETE PIPE CULVERTS REQUIRED
 140+30 18' 40' 30' 33' 45'

NO.	DATE	BY	CHKD.	APP'D.
1	10-2-58	J.S.	J.S.	J.S.

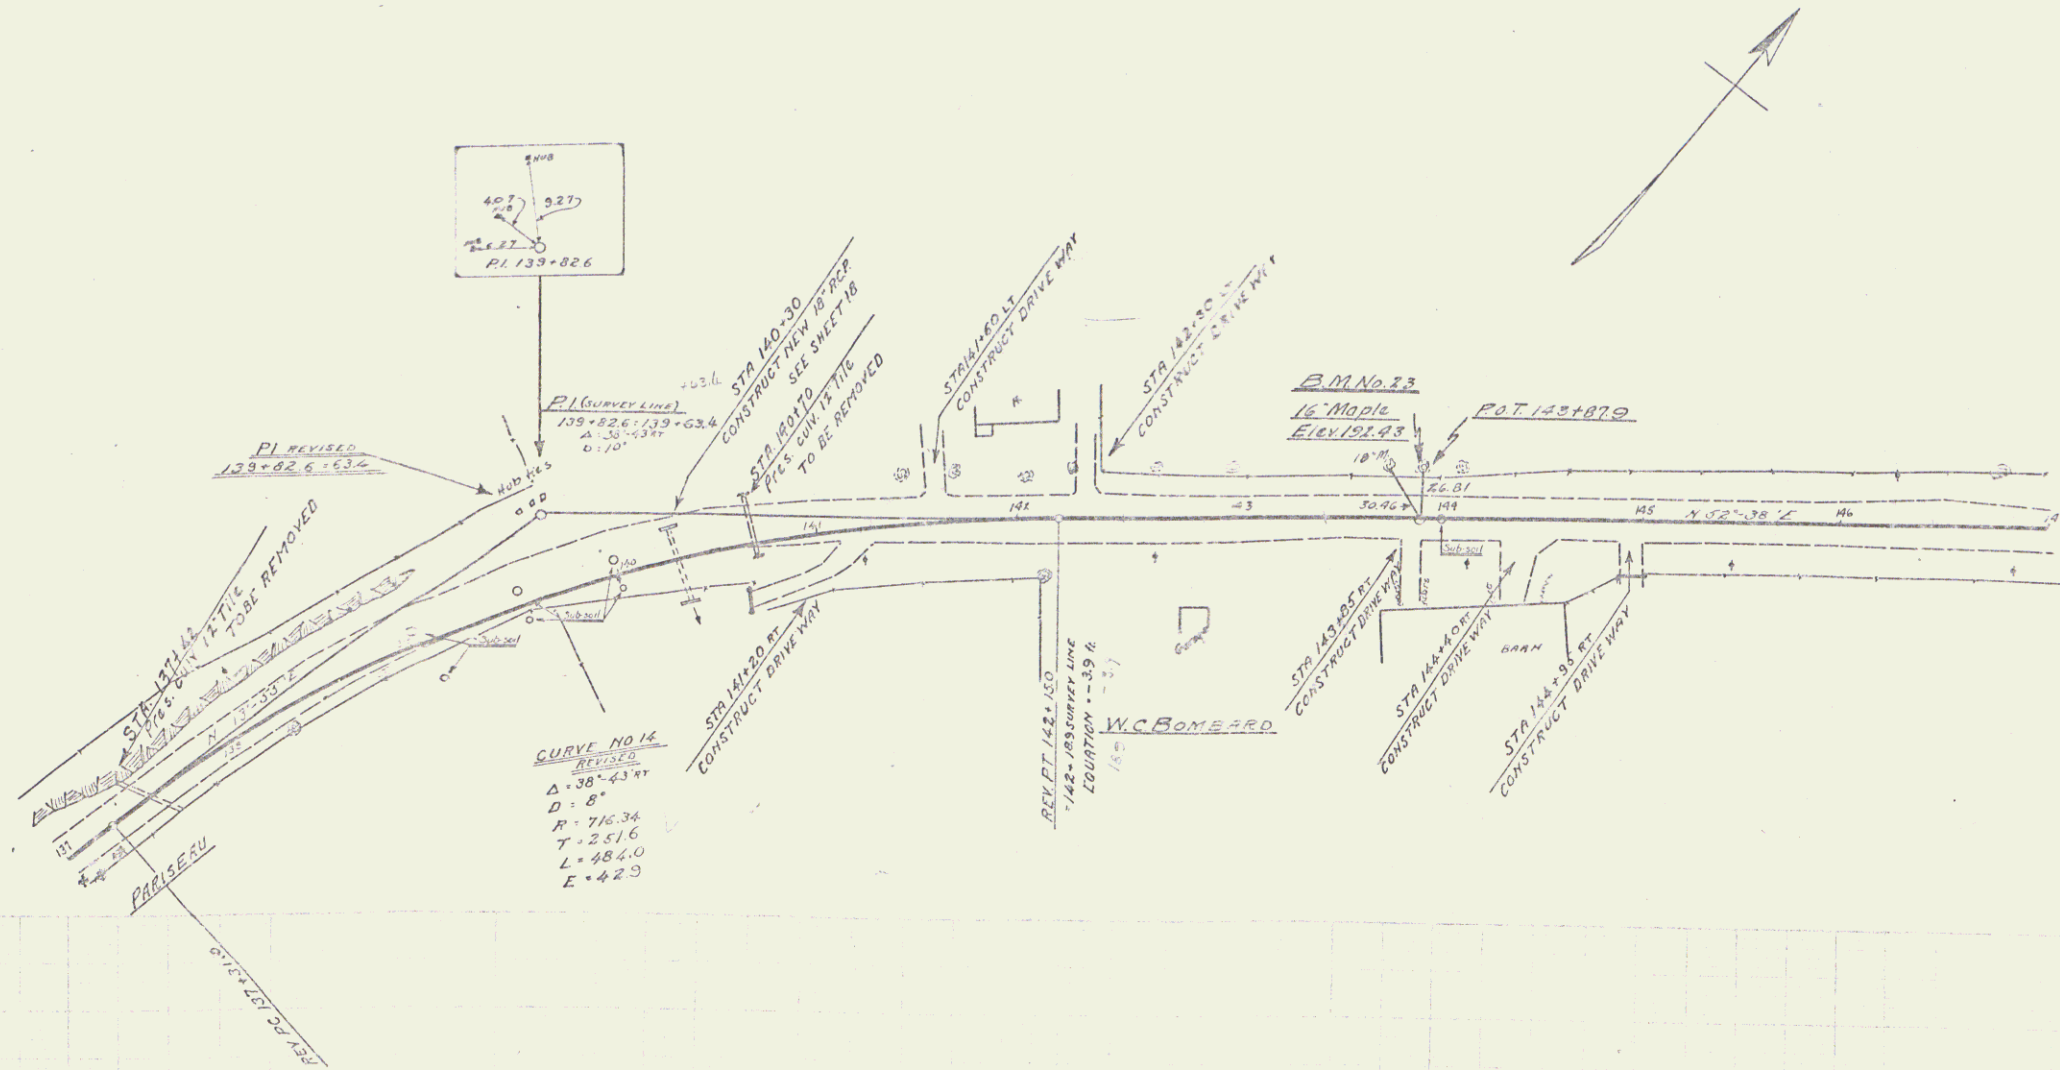

11 of Sta 143+93 ELEV 191.43