



ED. ROAD	STATE	FILE NO.	PROJECT	SHEET

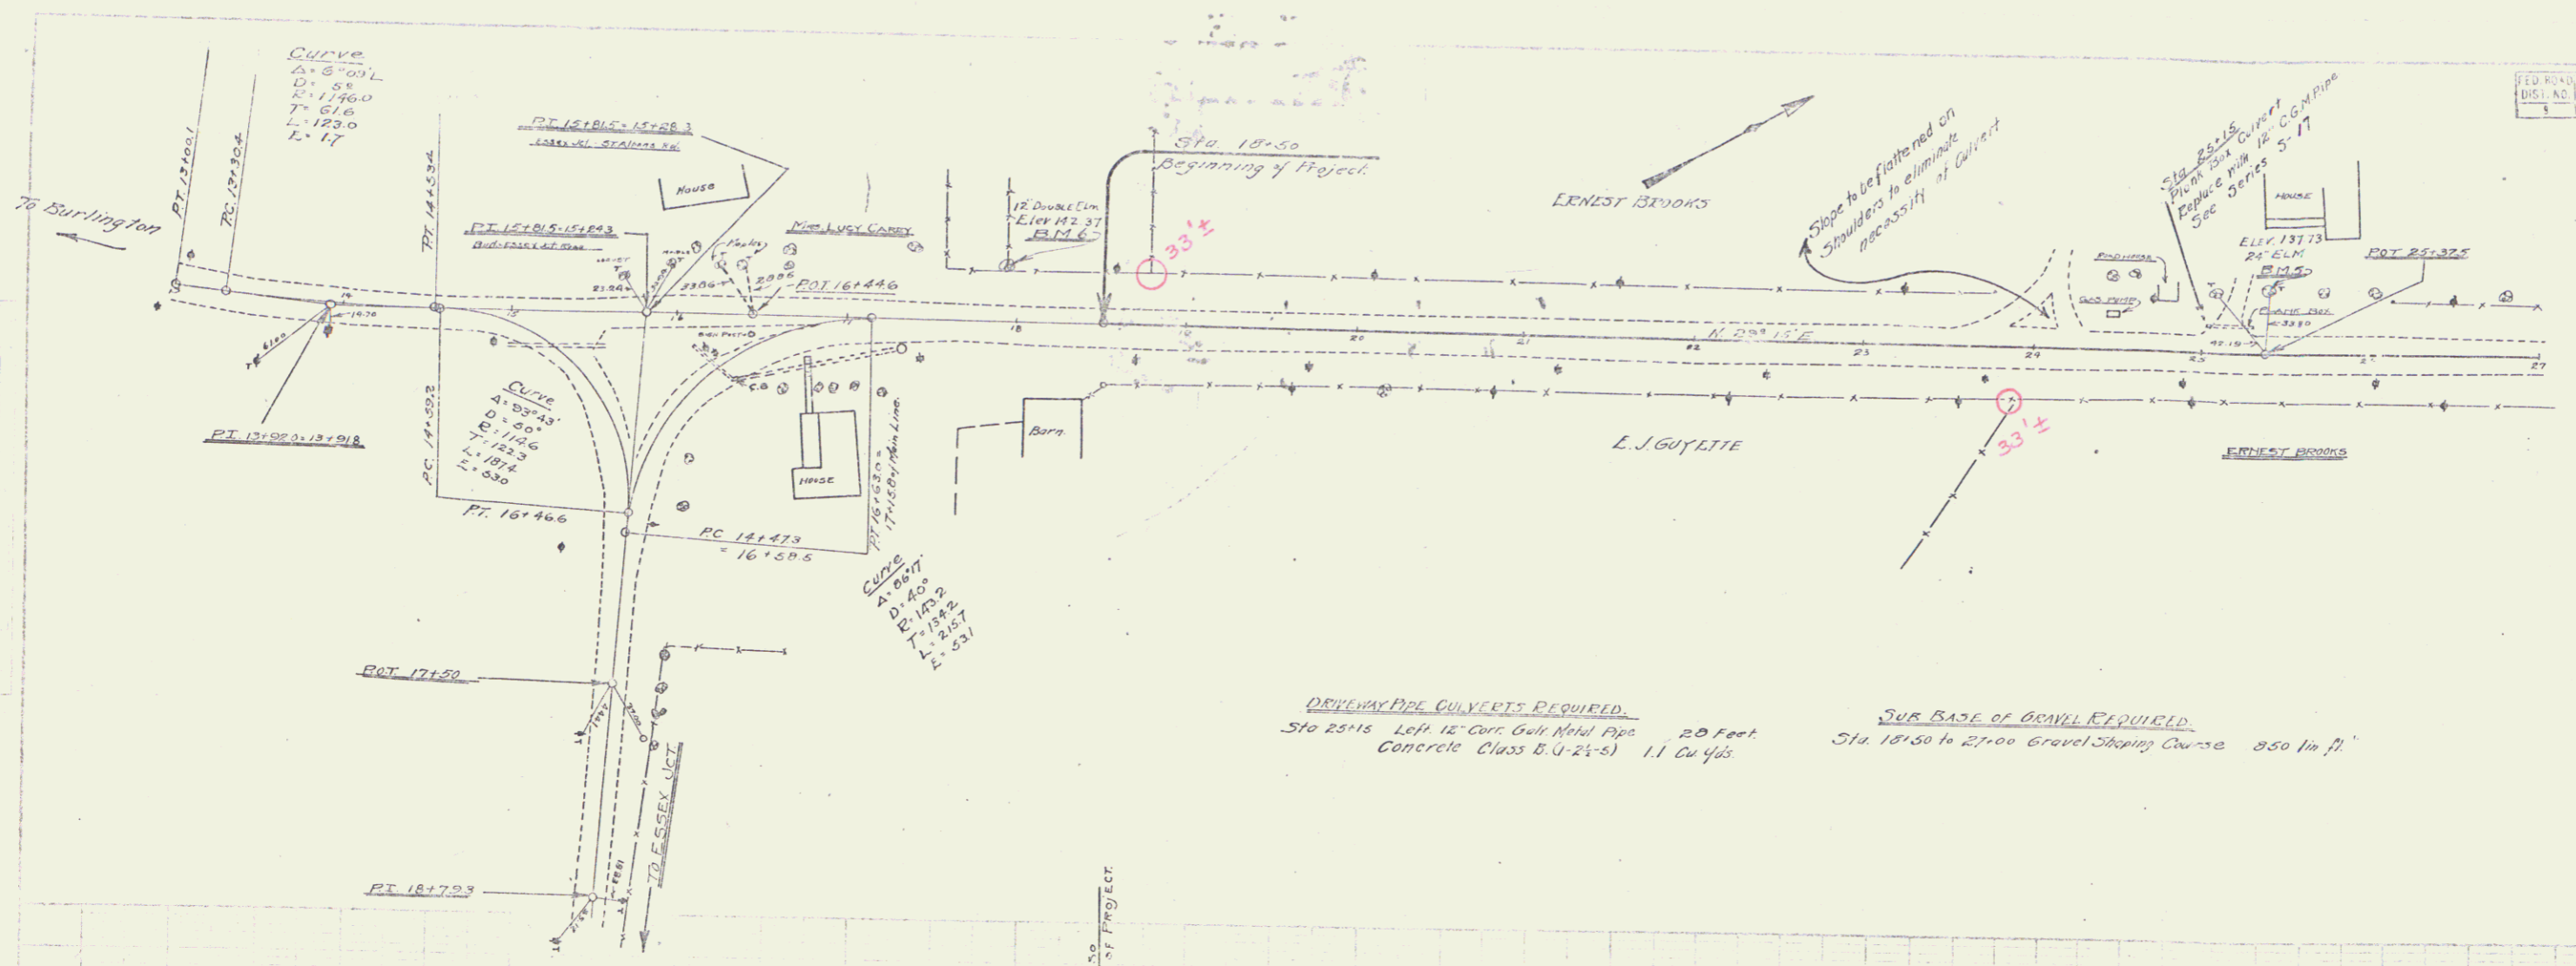

DRIVEWAY PIPE CULVERTS REQUIRED.
Sta 25+15 Left 12" corr. Galv. Metal pipe 20 Feet
Concrete Class B.C. (2'-8") 1.1 Cu Yds.

SUB-BASE OF GRAVEL REQUIRED.
Sta. 18+50 to 27+00 Gravel Shaping Course 350 Cu Yds.

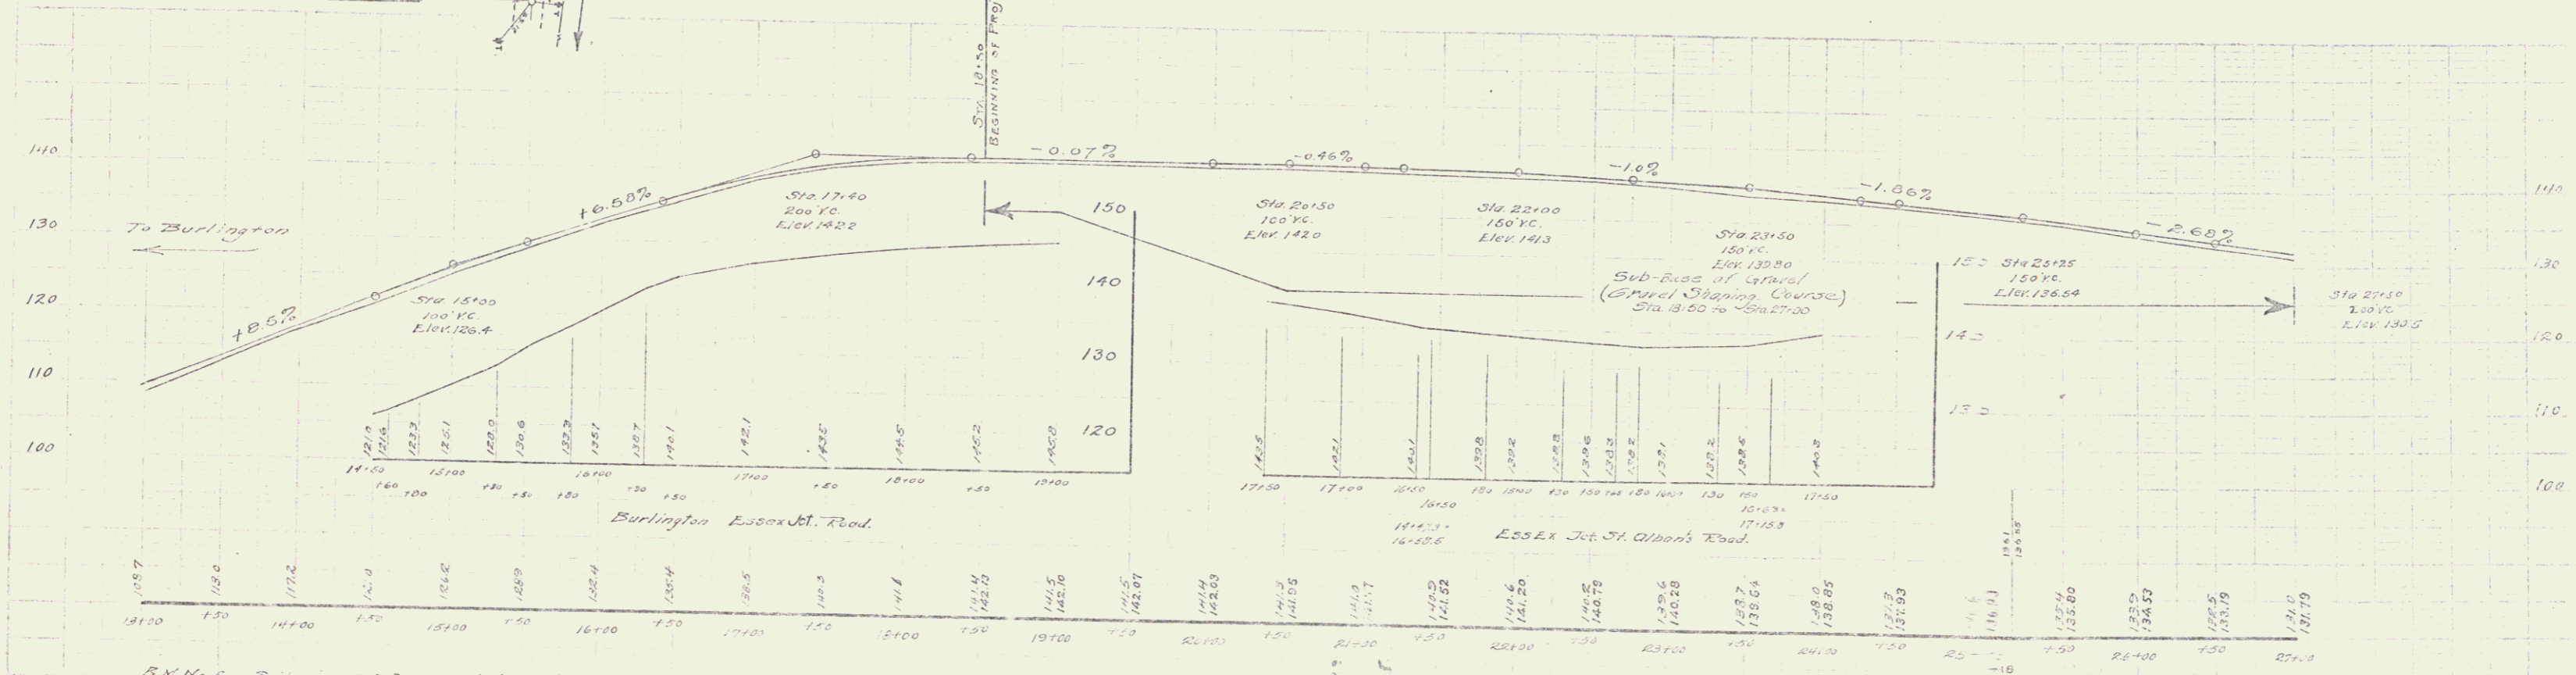

B.M. No 5 Spite in 24' Elm on left of Sta. 25+35 Elev. 137.73
B.M. No 6 Spite in 12" Double Elm on left of Sta. 17+34 Elev. 142.57

Series No 1-24
Sheet 5 of 20