
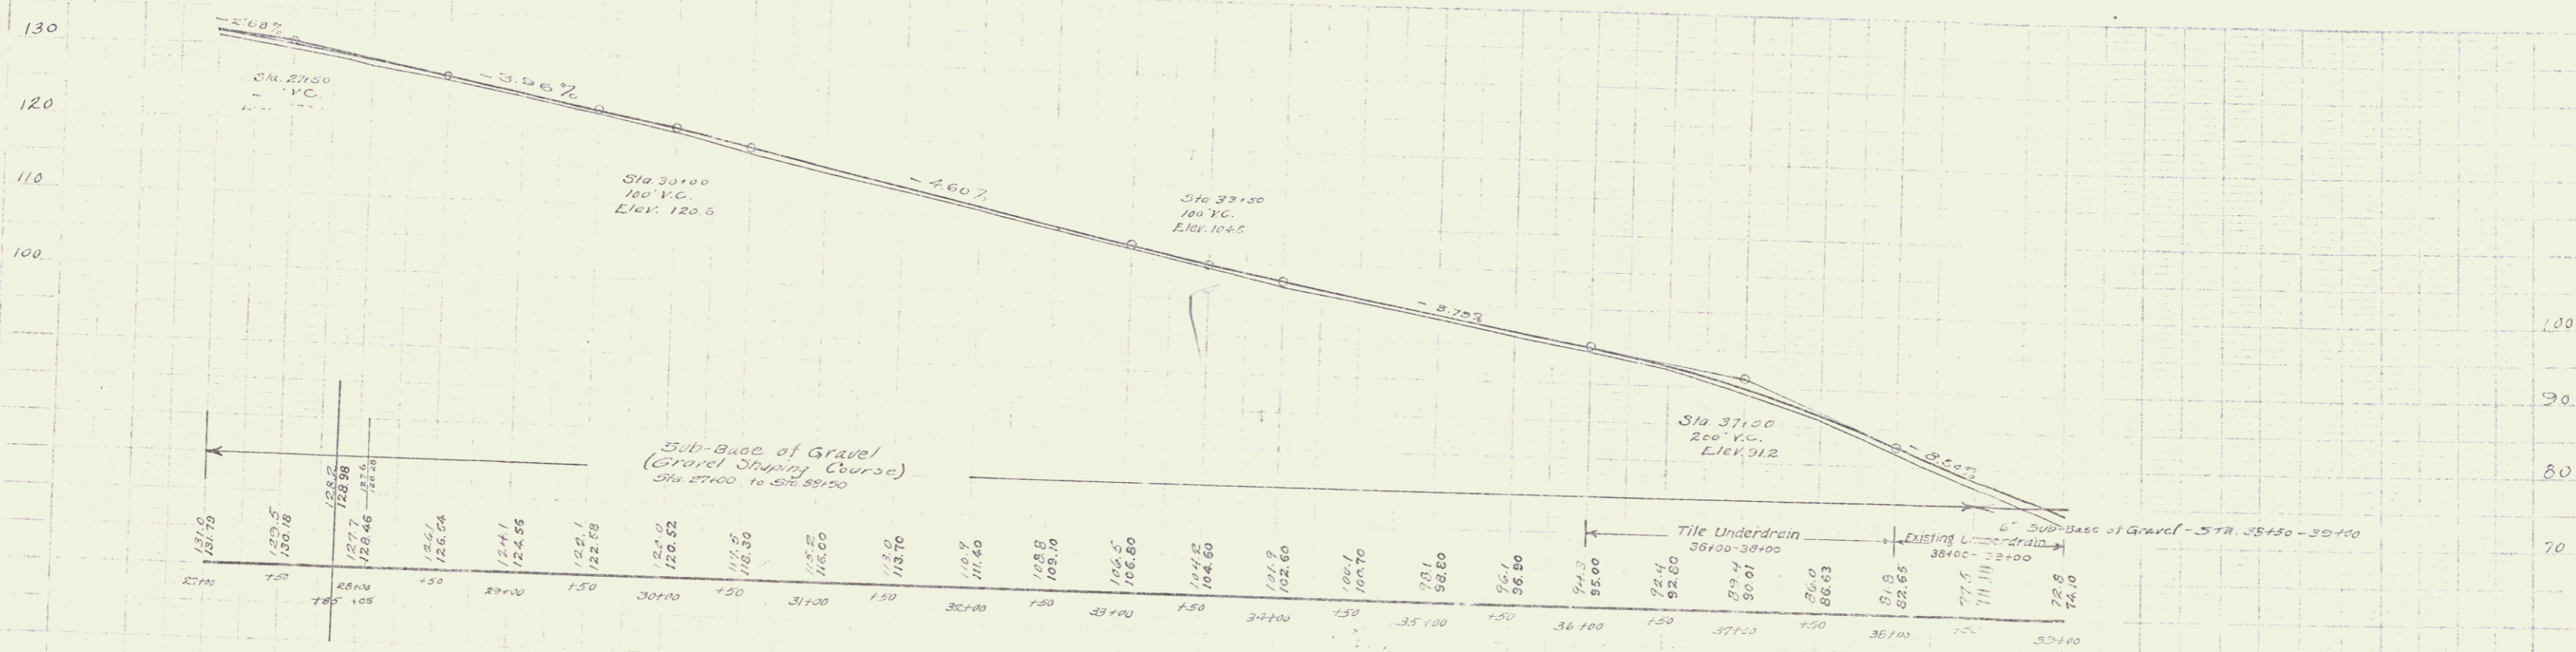


DRIVEWAY PIPE CULVERTS REQUIRED
 STA 35+35 EIGHT 12" CONCRETE PIPE 20' Lx 11"
 Concrete Class 5 (1-2-5) 11 cu yds.

SUB-BASE OF GRAVEL REQUIRED
 STA 2700 to STA 38+50 (Gravel Shaping Course) 1150 Lx 7"

TILE UNDERDRAIN REQUIRED
 UNDER CENTER OF ROADWAY
 STA 36+00 - 38+00 LENGTH 200 Lin Ft

FED. ROAD DIST. NO.	STATE	FILE NO.	TISCA	SHEET NO.	OF NO.
1	VA	1024	1928	4	5

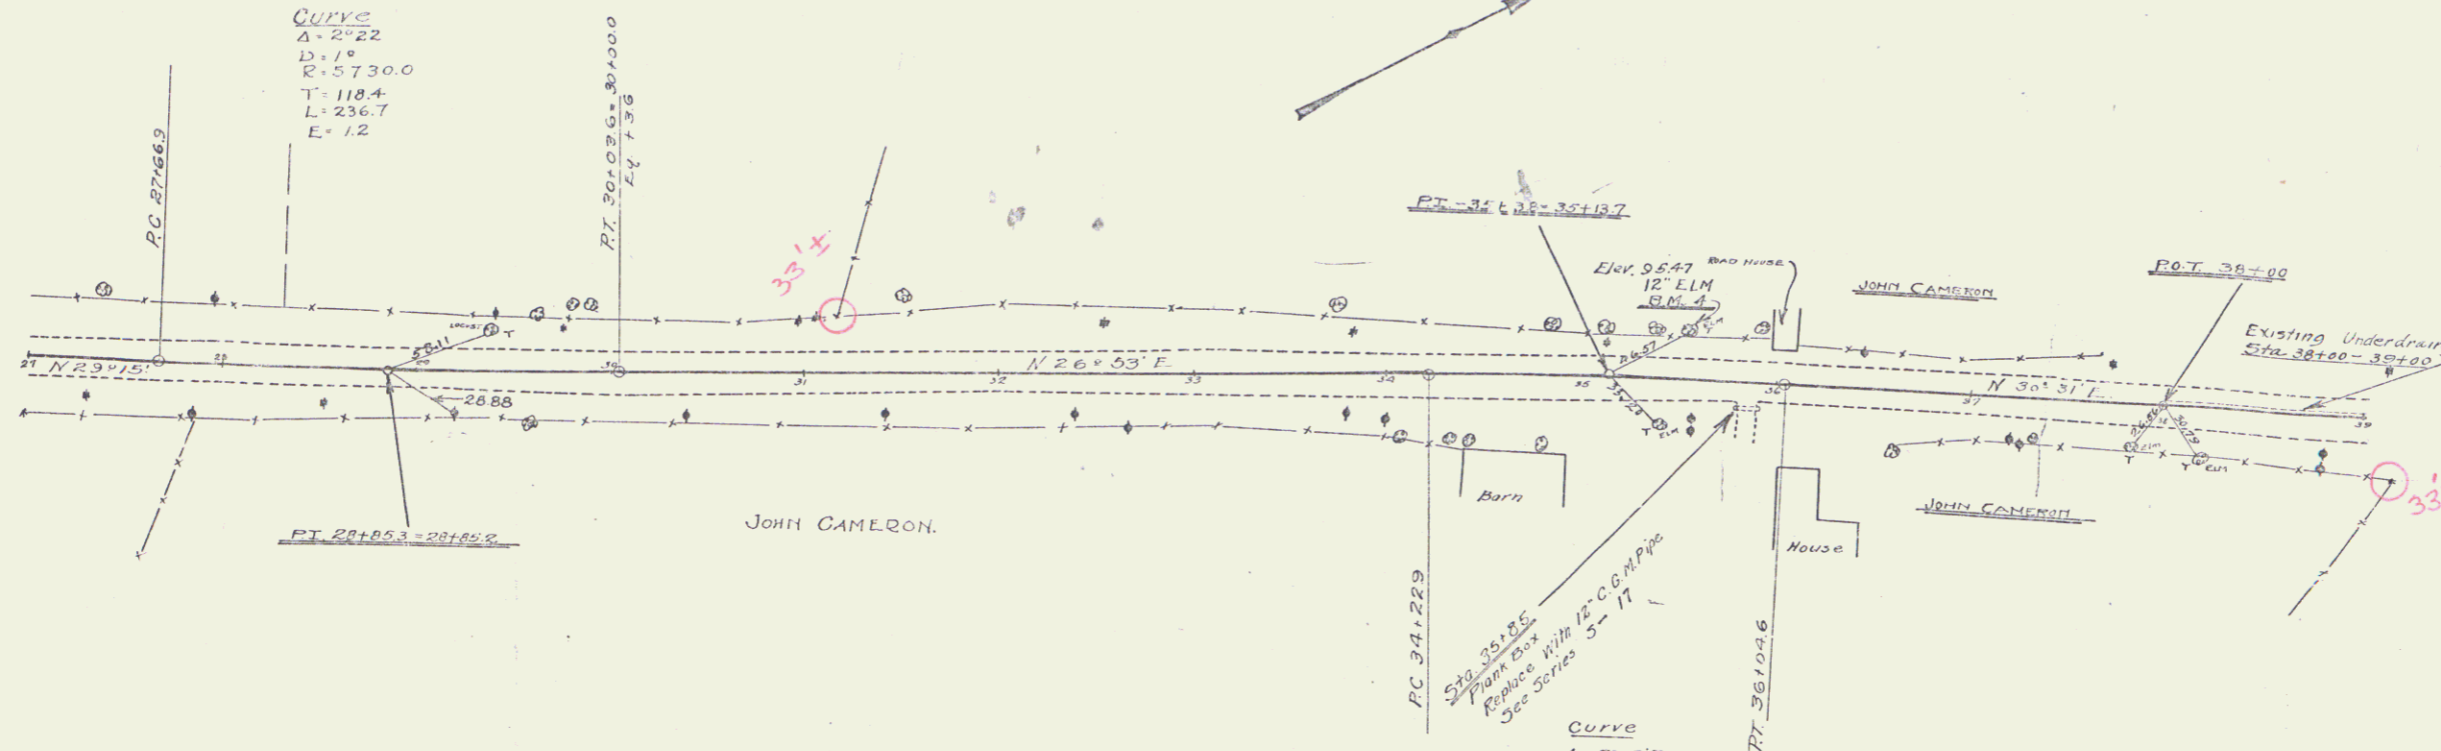

B.M. No. 4 Spike in 12" Limb, left of Sta. 35+37 Elev. 95.47

Series 1 No. 1024 Sheet 4 of 5