
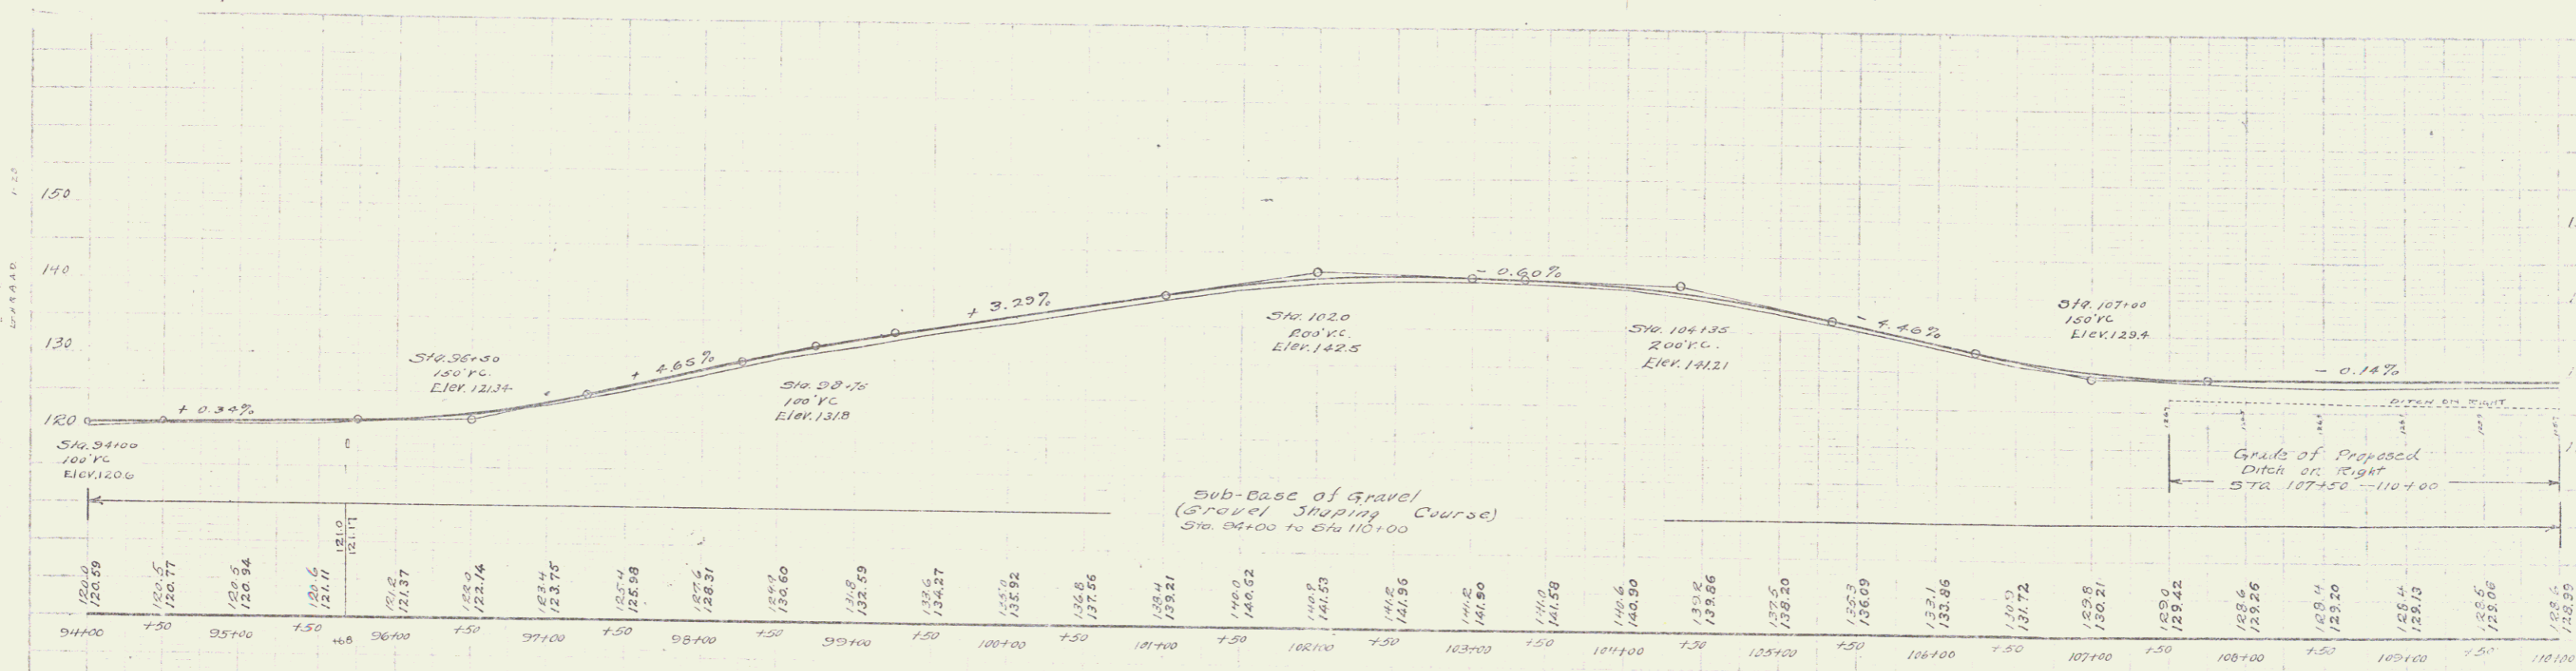


WOOD GUARD RAIL REQUIRED
LEFT
 Sta 95150 to 95160 Length 24 ft
RIGHT
 Sta 95160 to 95170 Length 24 ft
TOTAL THIS SHEET → 48 ft

NEW CULVERTS REQUIRED
 Sta 95160 24" Rein. Concrete Pipe Culvert 32 Lin. ft.
 Concrete Class B (4-2 1/2") 4.1 Cu. yds.
 Reinforcing Steel 33 Pounds.

SUB-BASE OF GRAVEL REQUIRED
 Sta 94100 to 110100 Gravel Shaping Course 1600 Lin. ft.

FED. ROAD DIST. NO.	FED. AC. YEAR	SHEET NO.	TOTAL SHEETS
9	1928	7	20

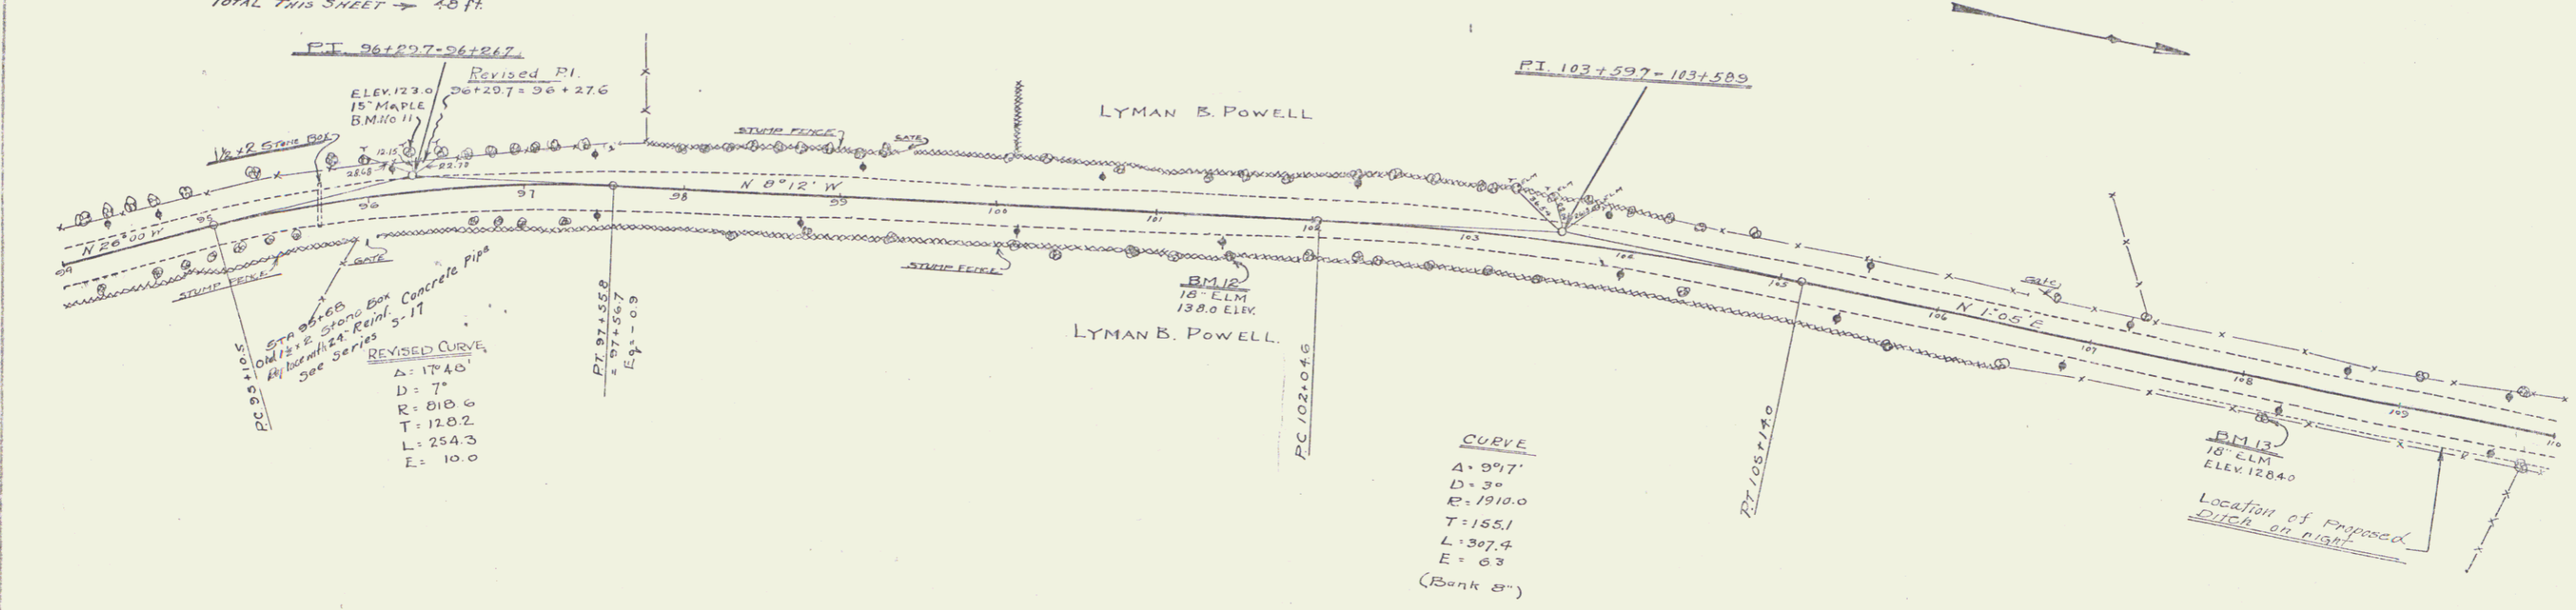

B.M. No. 11 Spike in 15" Maple Left of Sta. 96120 Elev. 123.00
 B.M. No. 12 " " 18" Elm Right of Sta. 101107 " 130.00
 B.M. No. 13 " " 18" Elm " 100110 " 128.40

Series F. No. 102A
 Sheet 7 of 20