

INDEX OF SHEETS	
SHEET NO. 1	TITLE PAGE
2	TYPICAL CROSS-SECTION OF IMPROVEMENT
3	BANKING AND WIDENING TABLES
4	PLAN AND PROFILE

FED. ROAD DIST. NO.	STATE	FED. AID PROJ. NO.	FISCAL YEAR	SHEET NO.	TOTAL SHEETS
9	Vt.				

STATE OF VERMONT
STATE HIGHWAY DEPARTMENT

PLAN AND PROFILE OF PROPOSED
STATE HIGHWAY
FEDERAL AID PROJECT



TOWN OF COLCHESTER

U.S. ROUTES 2 & 7 Pin # 99R420

CHIMNEY CORNER INTERSECTION

BEGINNING AT A POINT MILES SOUTHERLY FROM THE PRESENT INTERSECTION OF U.S. ROUTES 2 & 7 AND EXTENDING NORTHERLY MILES ON U.S. 7; FROM THE INTERSECTION OF U.S. ROUTES 7 & 2 NORTH-WESTERLY MILES; AND CONNECTING LINE US ROUTE 7 TO US ROUTE 2.

LENGTH	U.S. 7	FT.	MI.
LENGTH	U.S. 2	FT.	MI.
LENGTH	U.S. 7 TO U.S. 2	FT.	MI.
LENGTH	OF PROJECT	FT.	MI.

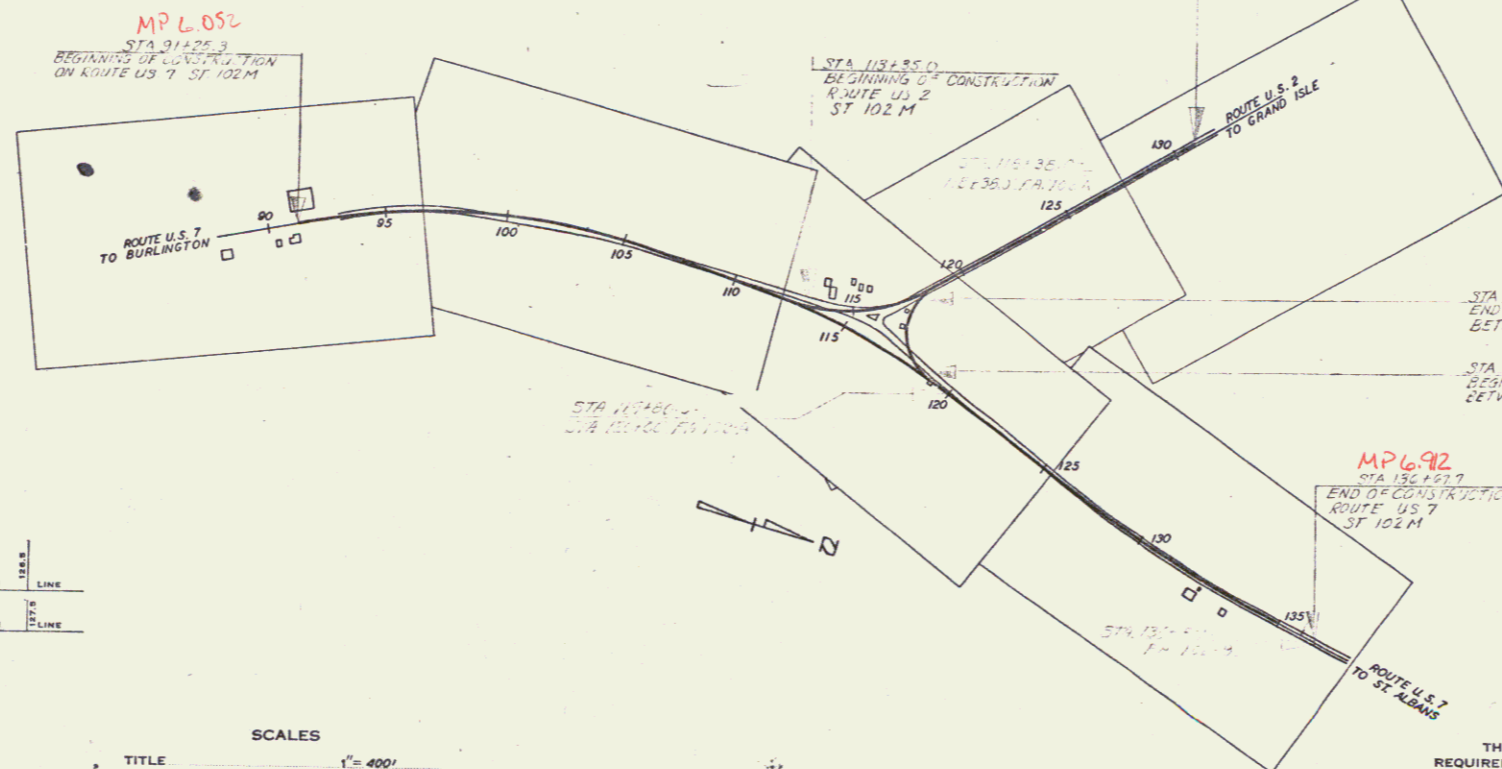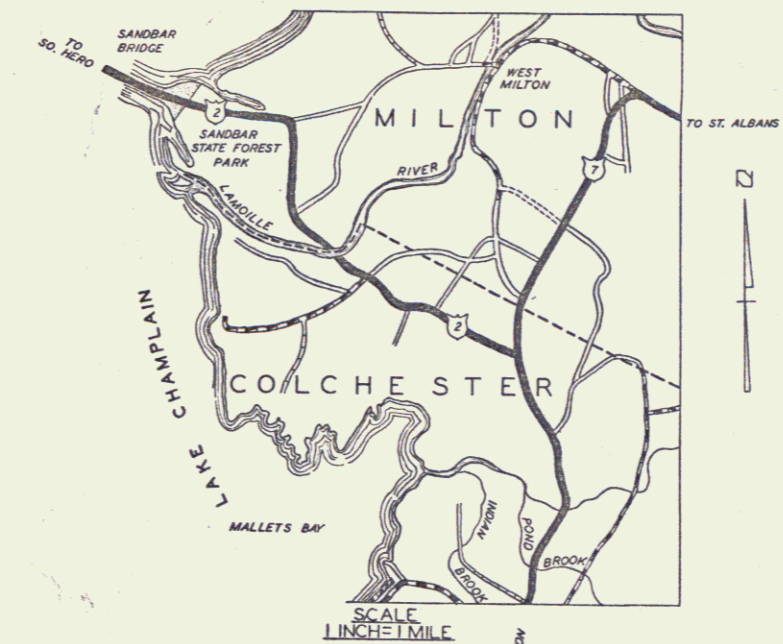

Historical
M P 6.35±
RIGHT-OF-WAY DIVISION
TOWN FILE
PERPETUAL
Town of US7
[To Be Returned To R.O.W. Division]

GROUND ELEVATION	DATUM	LINE
.....
GRADE ELEVATION	DATUM	LINE
.....

CURVE DATA	
DEFLECTION ANGLE.....	Δ
DEGREE OF CURVE.....	D
RADIUS OF CURVE.....	R
TANGENT DISTANCE.....	T
LENGTH OF CURVE.....	L
EXTERNAL DISTANCE.....	E
POINT OF INTERSECTION.....	P. I.
POINT OF CURVE.....	P. C.
POINT OF TANGENT.....	P. T.
POINT ON TANGENT.....	P. O. T.

SCALES	
TITLE	1" = 400'
TYPICAL	1" = 20'
PLAN	1" = 50'
PROFILE HORIZONTAL	1" = 50'
PROFILE VERTICAL	1" = 10'
CROSS SECTIONS	1" = 5'

THESE PLANS ARE SUBJECT TO SUCH REVISIONS AS MAY BE REQUIRED BY THE PUBLIC ROADS ADMINISTRATION OR THE COMMISSIONER OF HIGHWAYS.
CONSTRUCTION IS TO BE CARRIED ON IN ACCORDANCE WITH THE PLANS AND THE STANDARD ROAD AND BRIDGE SPECIFICATIONS OF 1936, AS APPROVED DECEMBER 29TH, 1936 BY THE PUBLIC ROADS ADMINISTRATION, INCLUDING ALL SUBSEQUENT APPROVED REVISIONS AND SUCH REVISED SPECIFICATIONS AND SPECIAL PROVISIONS AS ARE SUBMITTED WITH THE PLANS.

Project No. ST 102 M

APPROVED: _____
COMMISSIONER OF HIGHWAYS
SUBMITTED BY ORDER OF THE STATE HIGHWAY BOARD

RECOMMENDED FOR APPROVAL
DISTRICT ENGINEER
PUBLIC ROADS ADMINISTRATION
FEDERAL WORKS AGENCY
APPROVED
COMMISSIONER OF HIGHWAYS
PUBLIC ROADS ADMINISTRATION
FEDERAL WORKS AGENCY

APPROVED	APPROVED	SERIES F NO.	FILED
_____	_____	_____	_____
ROAD ENGINEER	DISTRICT HIGHWAY COMMISSIONER	SHEET 1	OF 1

DIST. # 5 PLANS