



PLAN
 QUANTITY BY
 CHECKED BY
 DATE
 NO.

PROFILE
 QUANTITY BY
 CHECKED BY
 DATE
 NO.

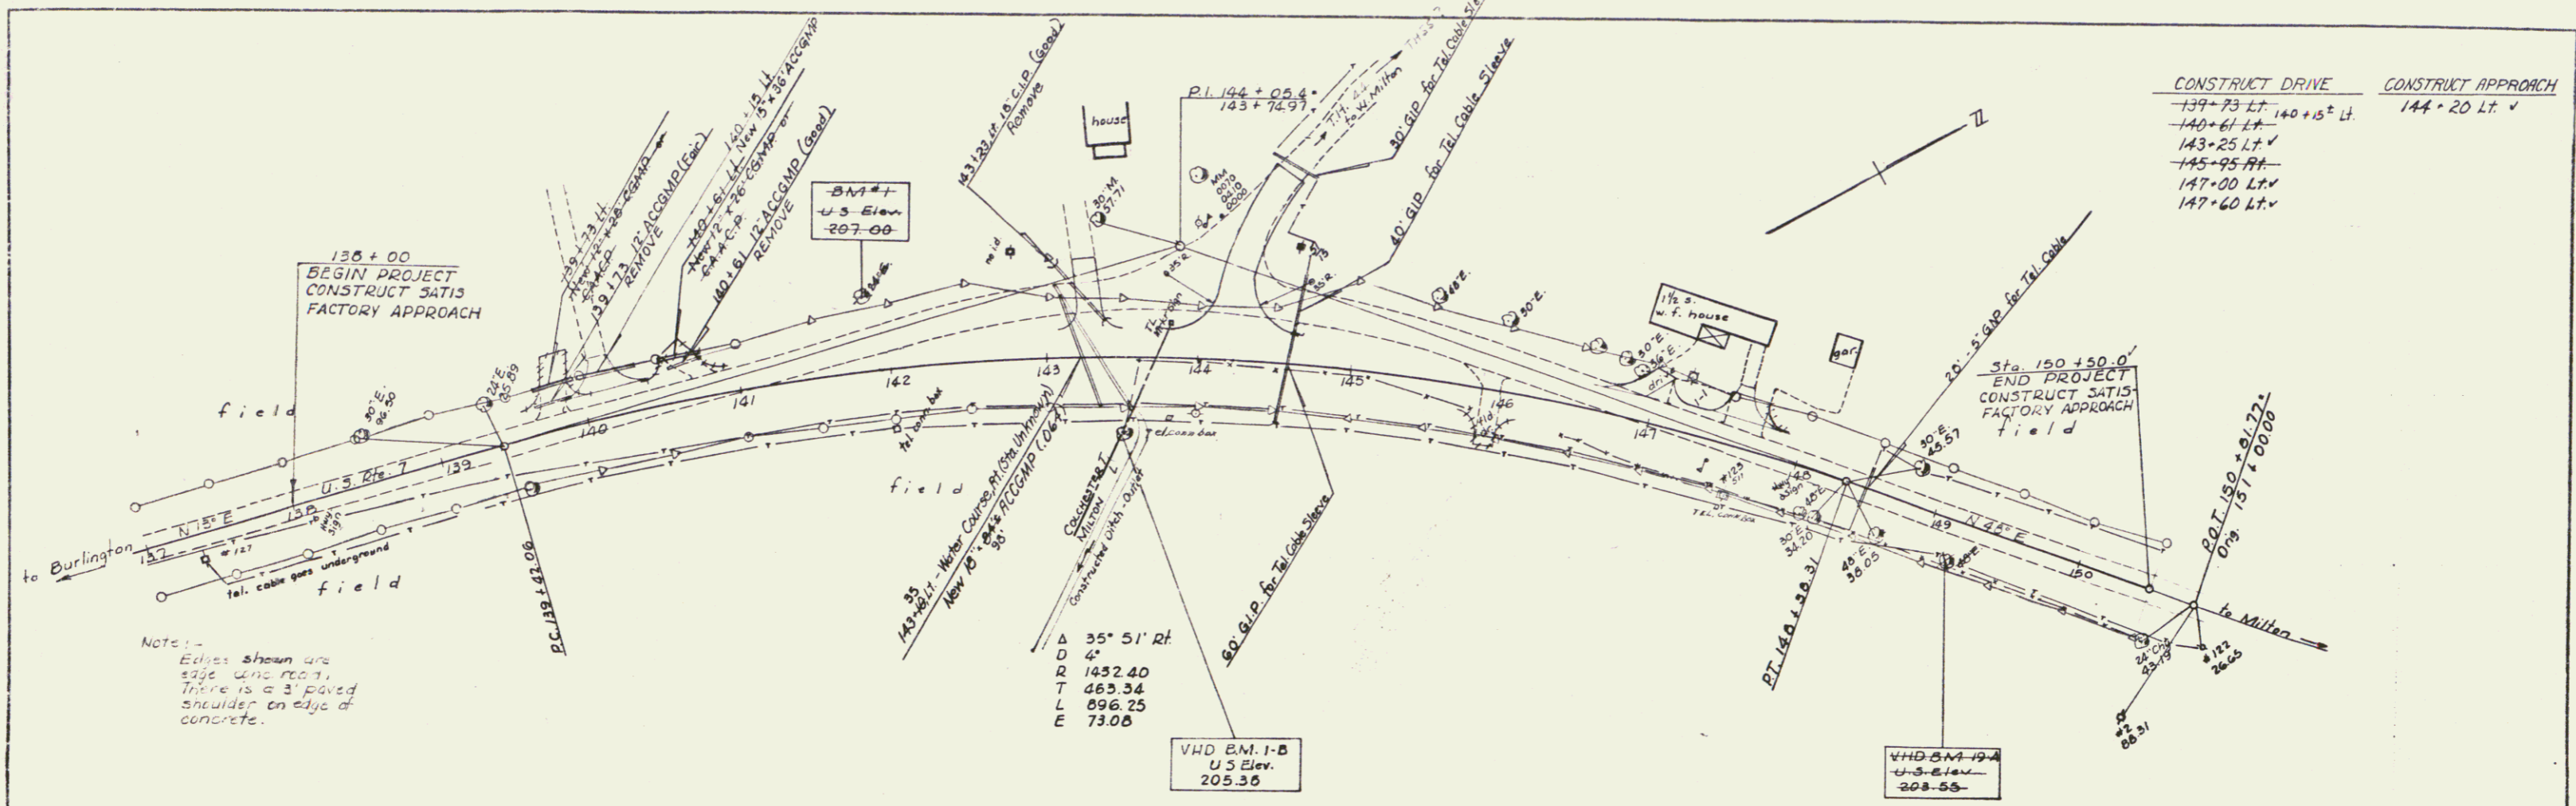

Note: -
 Edges shown are
 edge and road.
 There is a 3' paved
 shoulder on edge of
 concrete.

CONSTRUCT DRIVE	CONSTRUCT APPROACH
139+73 Lt	144+20 Lt ✓
140+61 Lt	
143+25 Lt ✓	
145+95 Rt ✓	
147+00 Lt ✓	
147+60 Lt ✓	

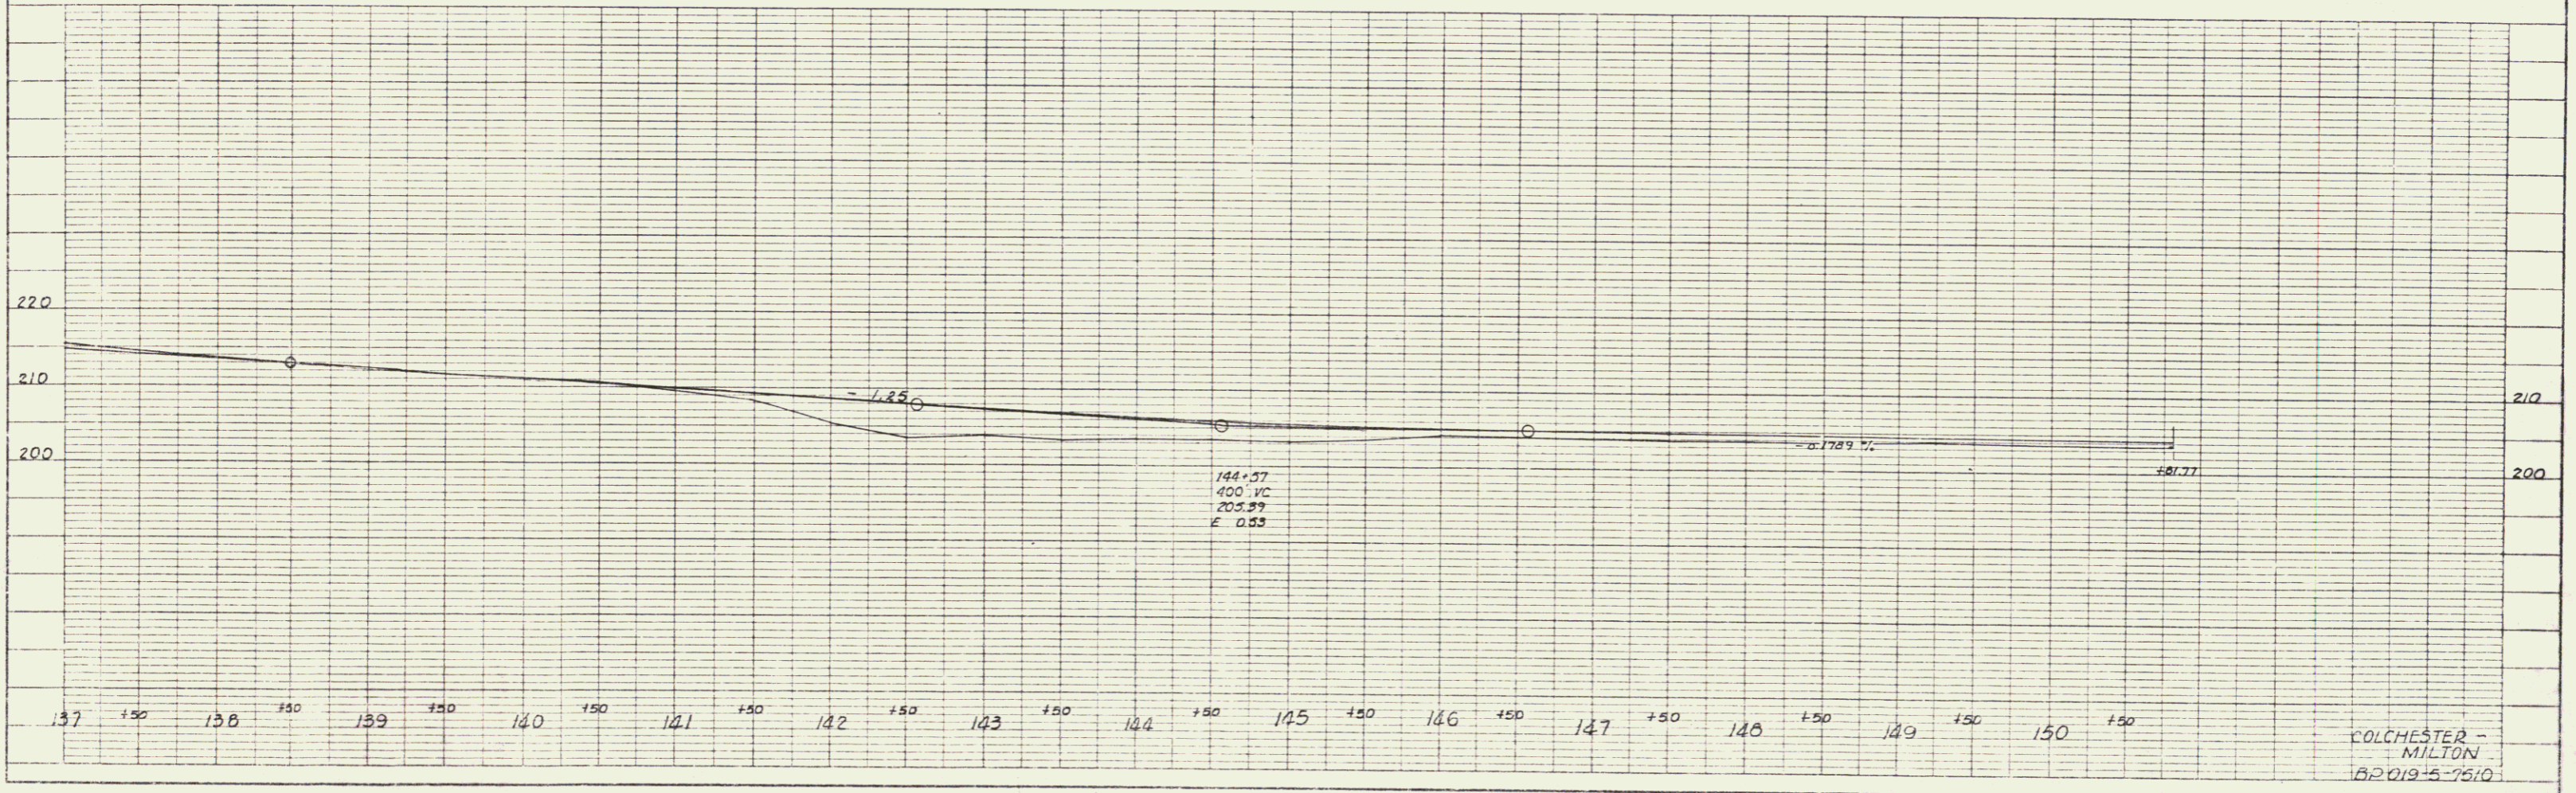

K&E PLATE 1, PLAN PROFILE
 KELP & EISE CO.

COLCHESTER -
 MILTON
 182019-6-75:10