



PLAN  
 QUANTITY  
 DISTRICT  
 PROJECT  
 SHEET NO.  
 DATE

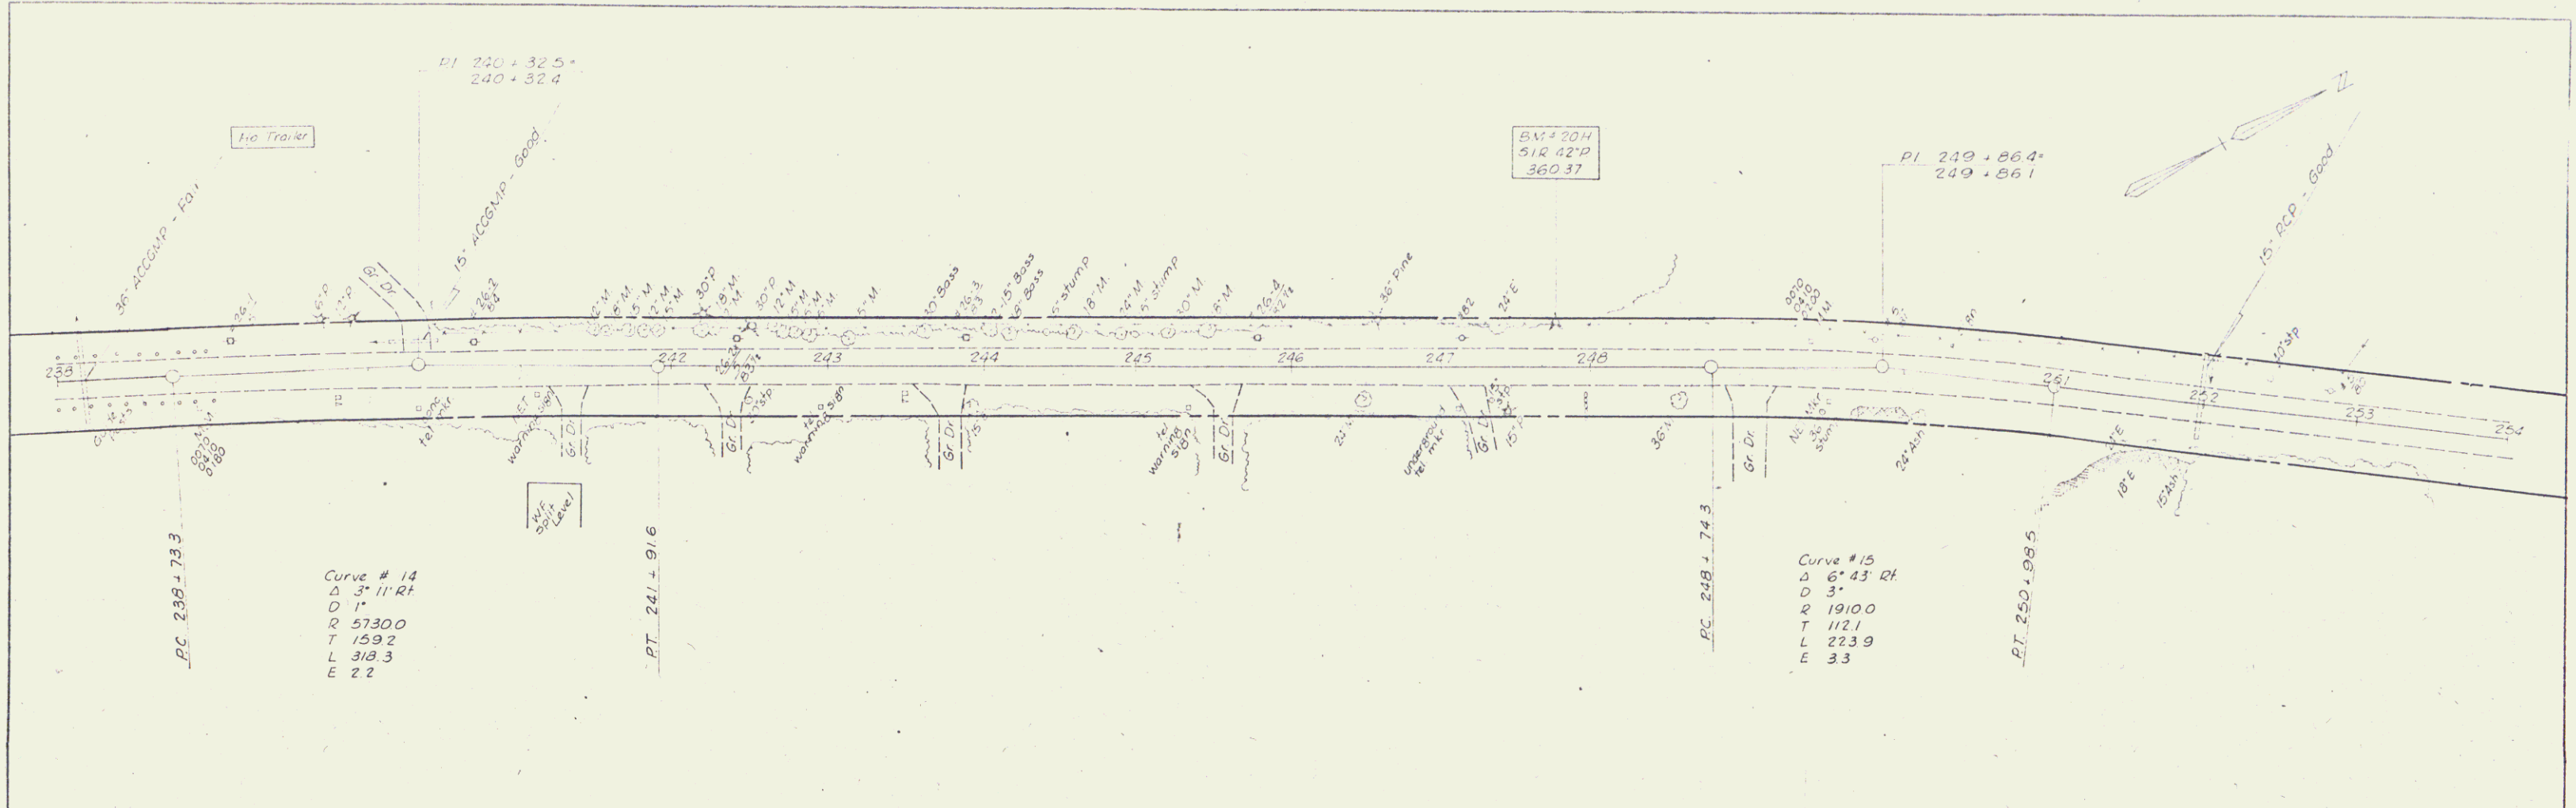

PROFILE  
 QUANTITY  
 DISTRICT  
 PROJECT  
 SHEET NO.  
 DATE

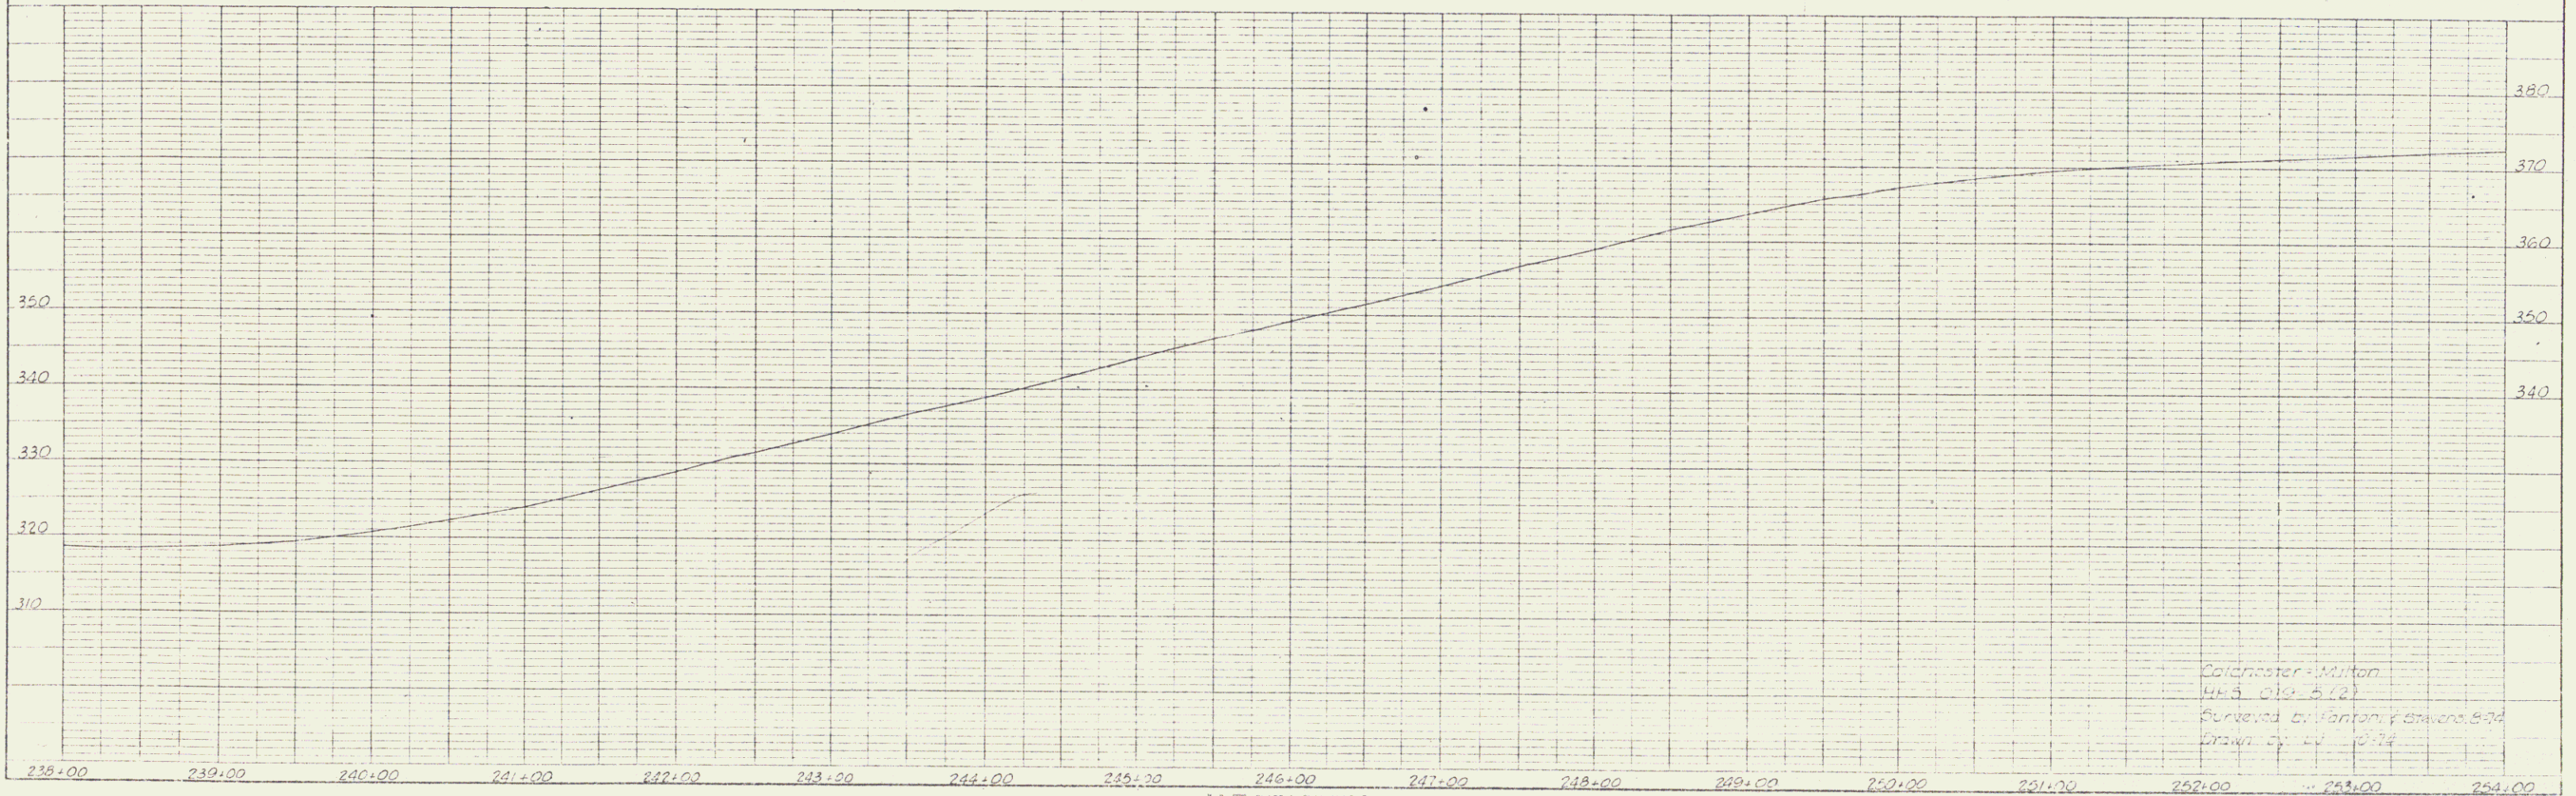

Dolanston - Milton  
 1/4 S. 101 S. 127  
 Surveyed by Stanton & Swaine, 1934  
 Drawn by L. W. 1936