
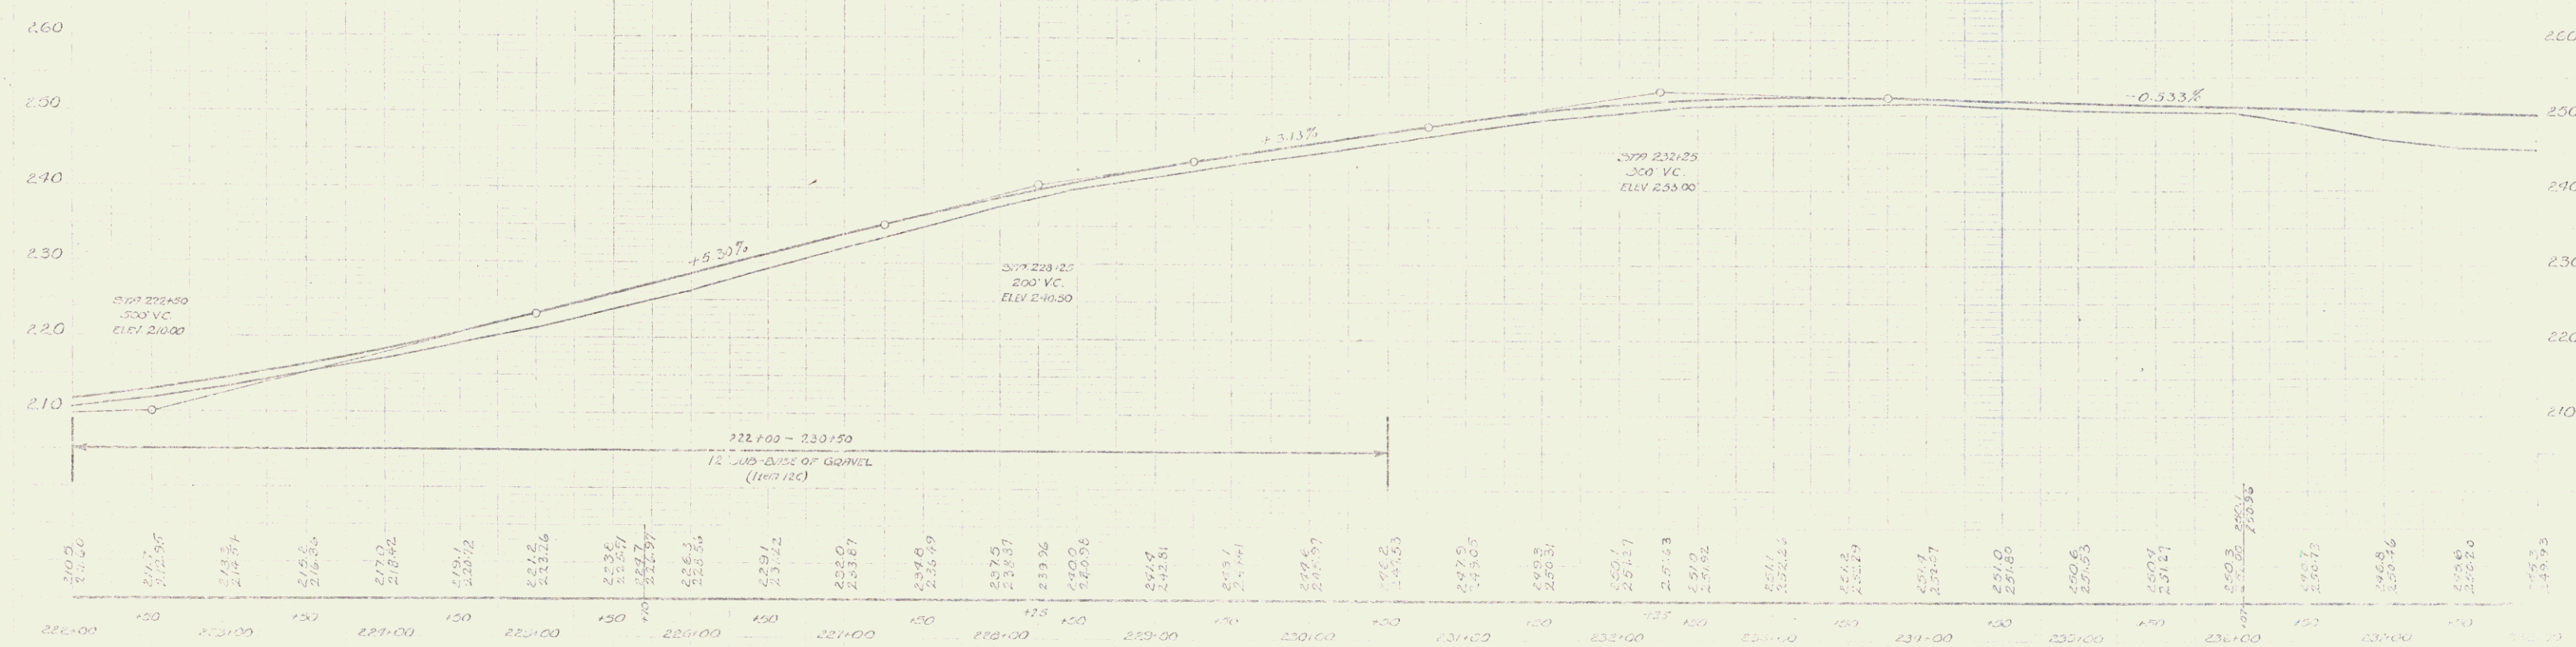


WOOD GUARD RAIL REQUIRED
 Stations L.R. Right
 229+30 - 229+62 24 ft. 24 ft.
 235+13 - 235+37 24 ft. 24 ft.

CABLE GUARD RAIL REQUIRED
 Stations L.R. Right
 237+94 - 238+00 6 ft. 6 ft.

NEW CAST IRON PIPE CULVERTS REQUIRED
 Station Diagram Lengths Right Cor. 3. 3m
 238+50 16' 30" 3.0 3.4 33"
 239+25 13' 42" 3.0 3.4 33"

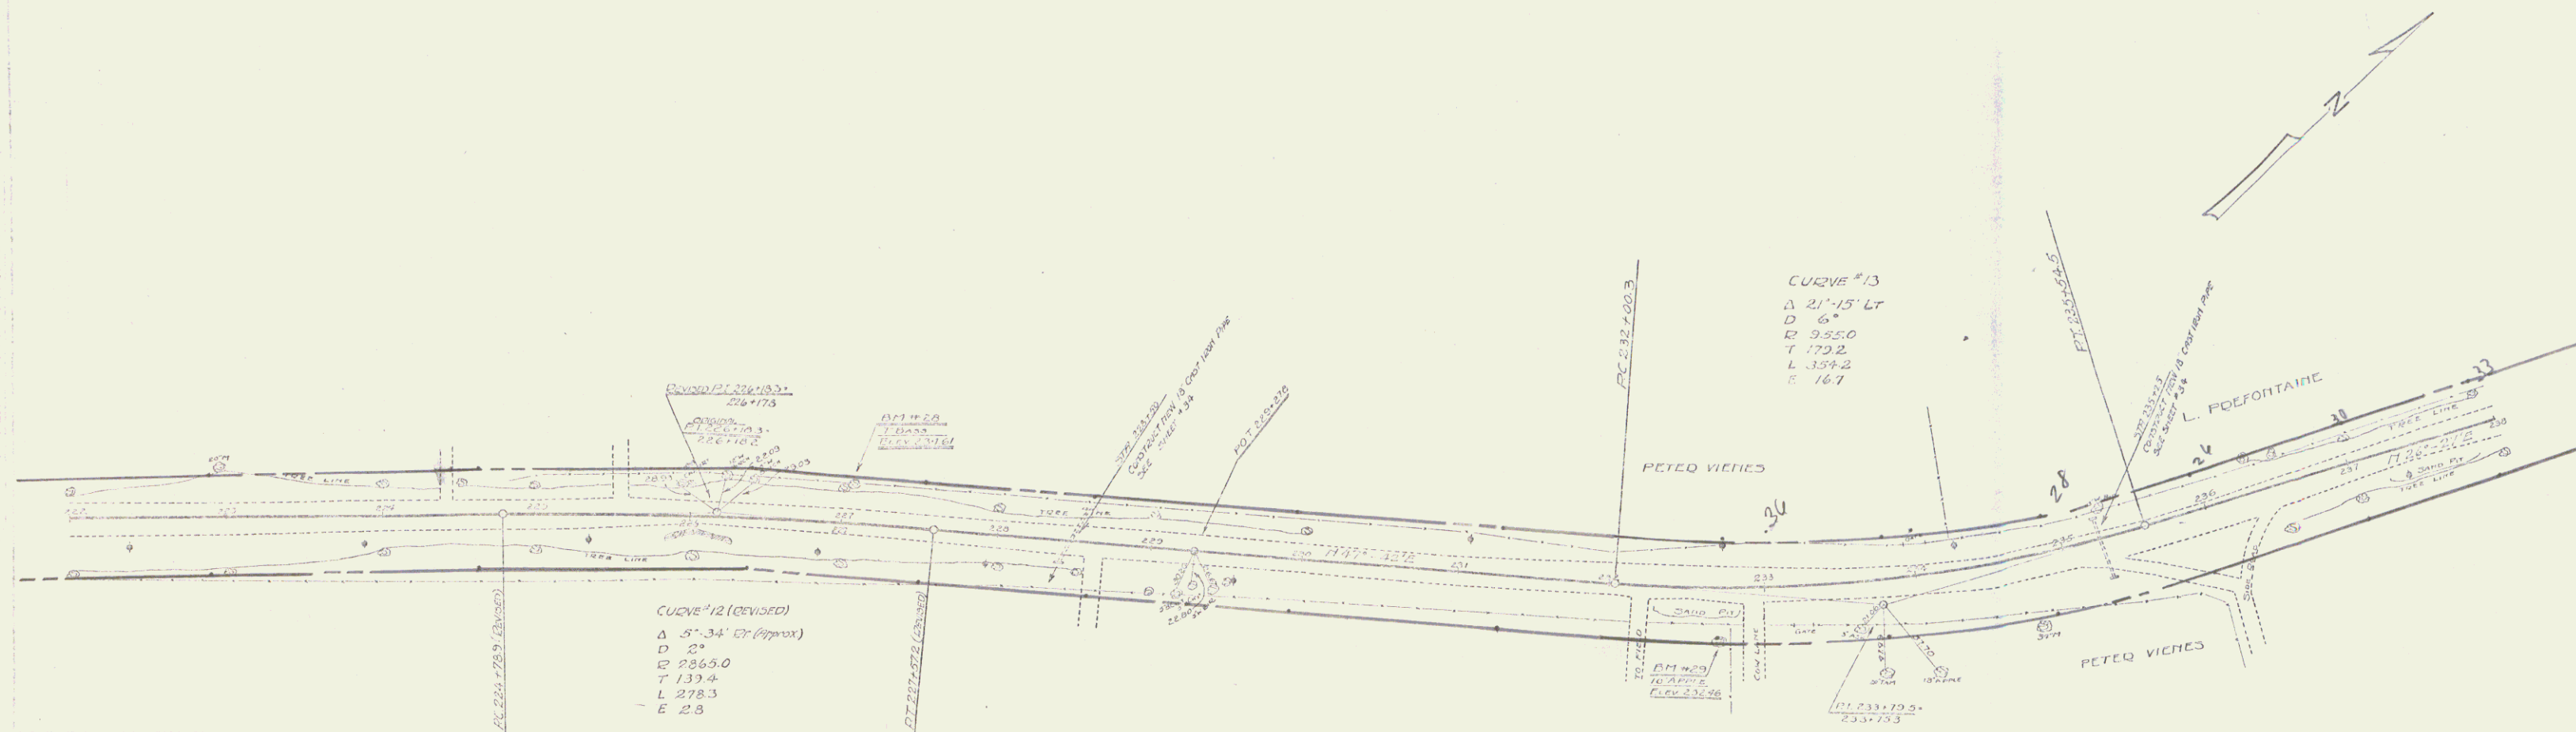

BM #28 SPIKE IN TOWER 1" BASS LT STA 227+04 - ELEV 239.61
 BM #29 SPIKE IN TOWER 10" APPLE R STA 232+70 - ELEV 252.46

SERIES F 171923
 SHEET 11 OF 84