
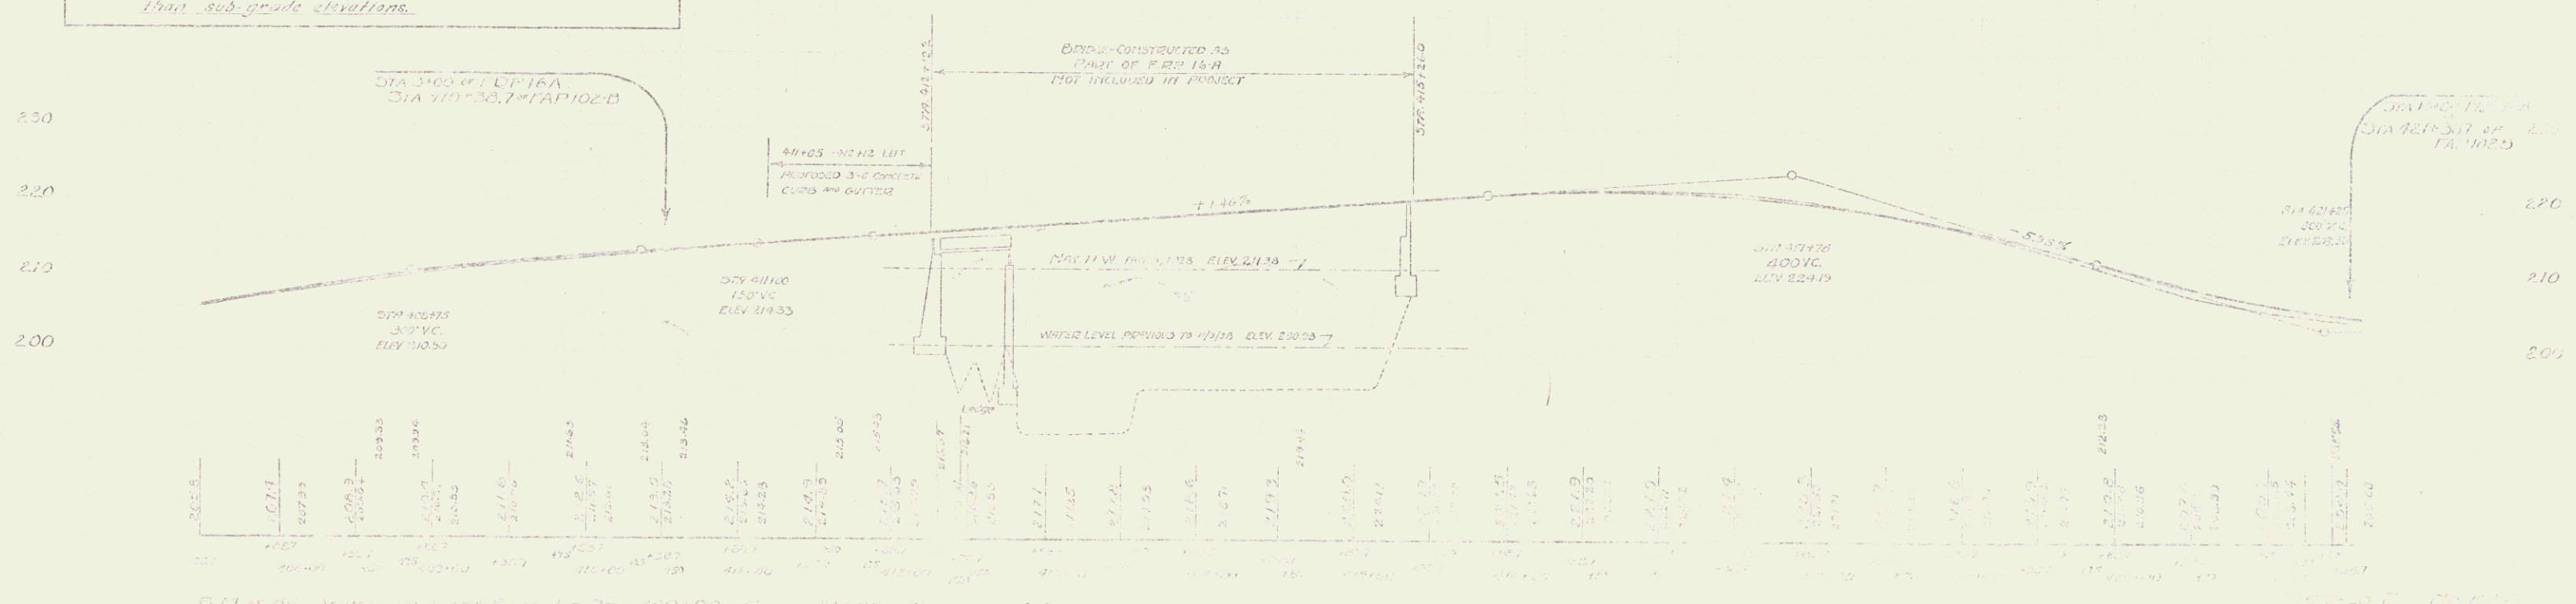


ALSO SEE
PLAN 100

ALSO SEE
PLAN 100
PLAN 101

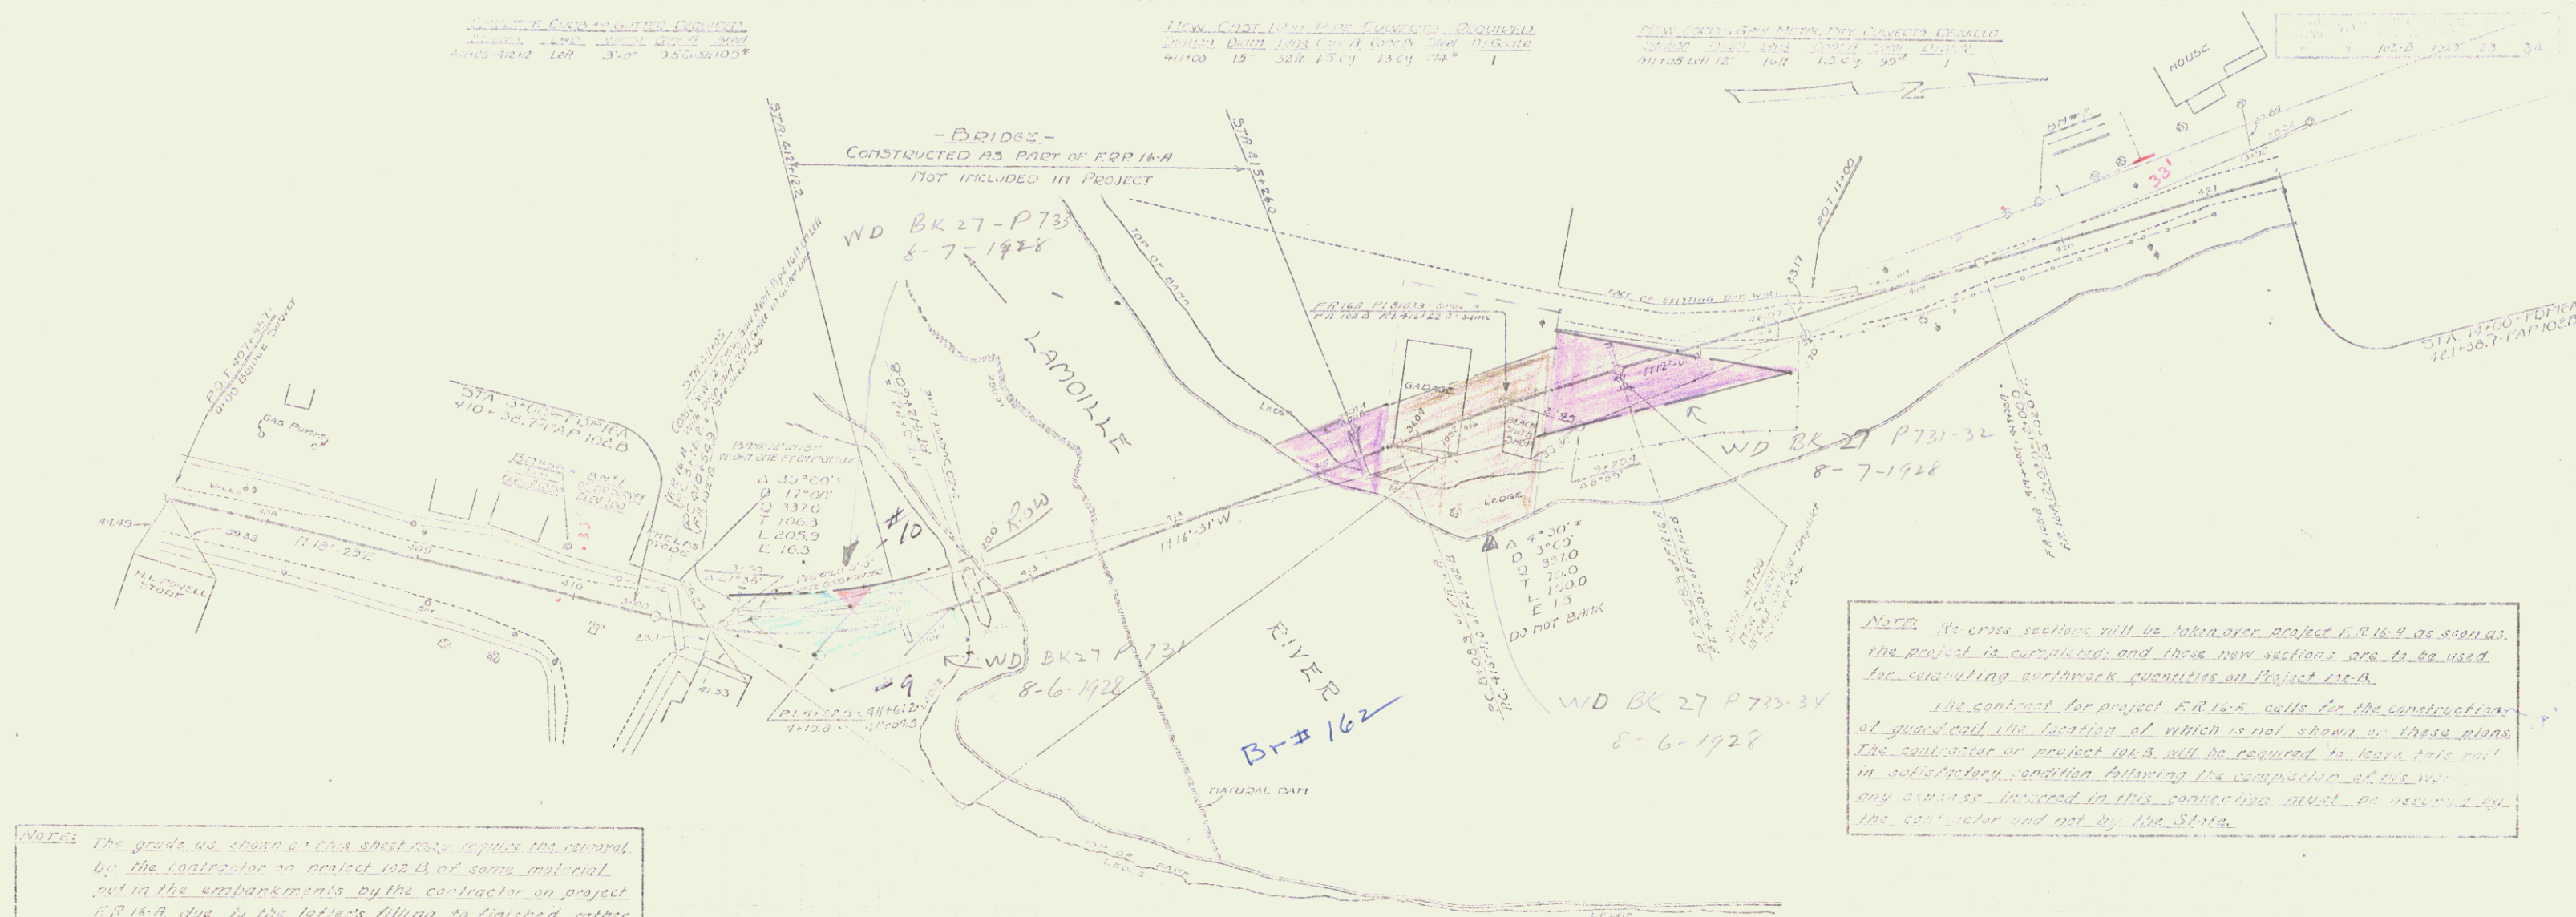

DATA FOR SHORE IN 1900 ELEV. LE STA 400+00 - ELEV. 213.30 - (SEE DATA OF THIS PROJECT)

PLAN 100
PLAN 101
PLAN 102