

FED. ROAD DIST. NO.	STATE	FED. AID PROJ. NO.	FINAL SHEET NO.	TOTAL SHEETS
9	Vt.	52A	24	19

INDEX OF SHEETS



SHEET NO.	TITLE PAGE
2	TYPICAL CROSS-SECTION OF IMPROVEMENT
3	PLAN AND PROFILE STATION 0+00 TO STATION 12+00
4	15+00 31+00
5	31+00 47+00
6	47+00 63+00
7	63+00 79+78.12
8	79+78.12 83+00
9	83+00 109+00
10	109+00 112+00
11 TO 19	CROSS SECTIONS

STATE OF VERMONT
STATE HIGHWAY DEPARTMENT

PLAN AND PROFILE OF PROPOSED
STATE HIGHWAY
FEDERAL AID PROJECT

TOWN OF GEORGIA Pin# 99R426
MILTON-ST. ALBANS ROAD US Rte. 7
FROM MILTON TOWN LINE TO W. C. CLARK'S PLACE

SCALES
PLAN 1" = 60'
PROFILE, HOR. 1" = 50', VERT. 1" = 10'
CROSS SECTIONS 1" = 3'

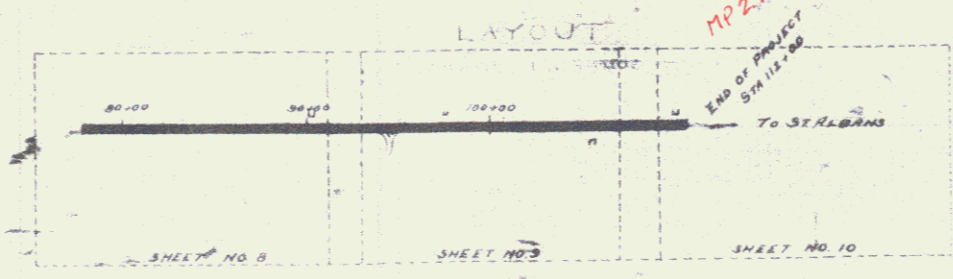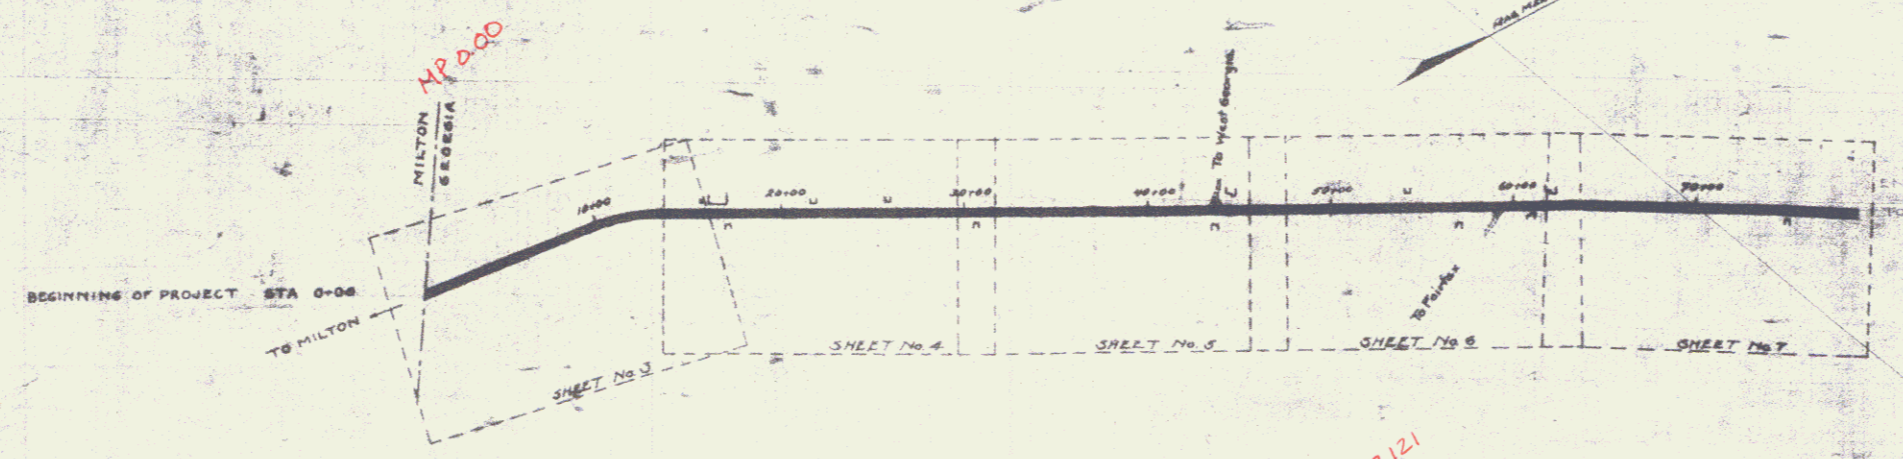

CONVENTIONAL SIGNS

- GROUND ELEVATION
- GRADE ELEVATION
- CURVE DATA
- DEFLECTION ANGLE Δ
- DEGREE OF CURVE D
- RADIUS OF CURVE R
- TANGENT DISTANCE T
- LENGTH OF CURVE L
- EXTERNAL DISTANCE E
- POINT OF INTERSECTION P.I.
- POINT OF CURVE P.C.
- POINT OF TANGENT P.T.

LAYOUT
SCALE 1" = 500 FEET

RECORD PLANS

RIGHT-OF-WAY DIVISION
TOWN FILE
PROJECT
LOCATION
DATE 0-2-57
US 7
(To Be Returned to R.O.W. Division)

Project No. F 52A

1/1/22

SUBMITTED BY ORDER OF THE STATE HIGHWAY BOARD
DISTRICT ENGINEER
CHIEF ENGINEER - BUREAU OF PUBLIC ROADS
DIRECTOR - BUREAU OF PUBLIC ROADS
Series F No. 52A File
Sheet 0 of 3