

GUARD RAIL REQUIRED
 ON CURVE
 500' SHARP TO 50' BOUND LENGTHENED
 ON CURVE
 500' SHARP TO 50' BOUND LENGTHENED
 TOTAL THIS SHEET 400'

NEW COLLETS REQUIRED
 ON CURVE
 50' SHARP TO 50' BOUND LENGTHENED
 ON CURVE
 500' SHARP TO 50' BOUND LENGTHENED
 TOTAL THIS SHEET 400'

505 BASE REQUIRED
 ON CURVE TO 50' BOUND LENGTHENED
 ON CURVE TO 50' BOUND LENGTHENED
 TOTAL THIS SHEET 400'



COUNTY	STATE	PROJECT	DATE	SHEET	TOTAL
3	VT	524	1922	6	9

PLAN

PROJECT	DATE
NO. 1	NO. 1

PROFILE

PROJECT	DATE
NO. 1	NO. 1

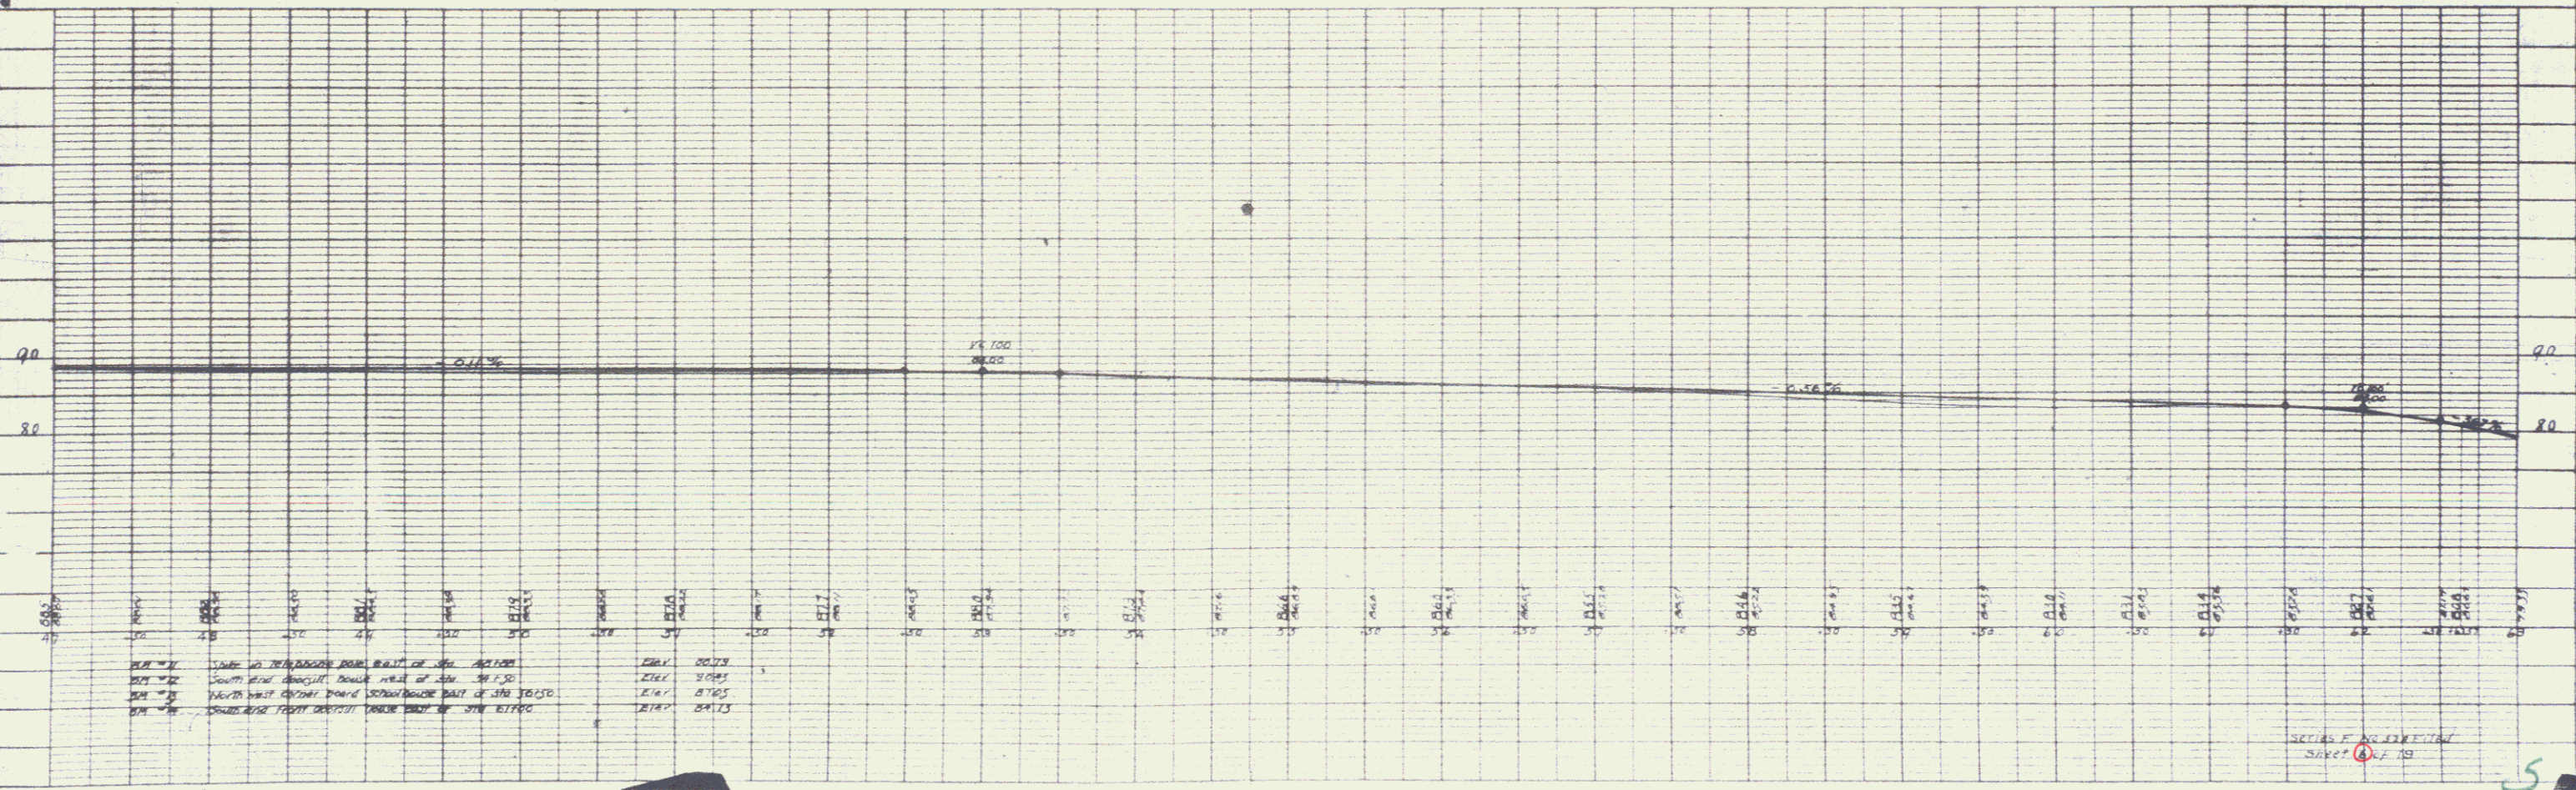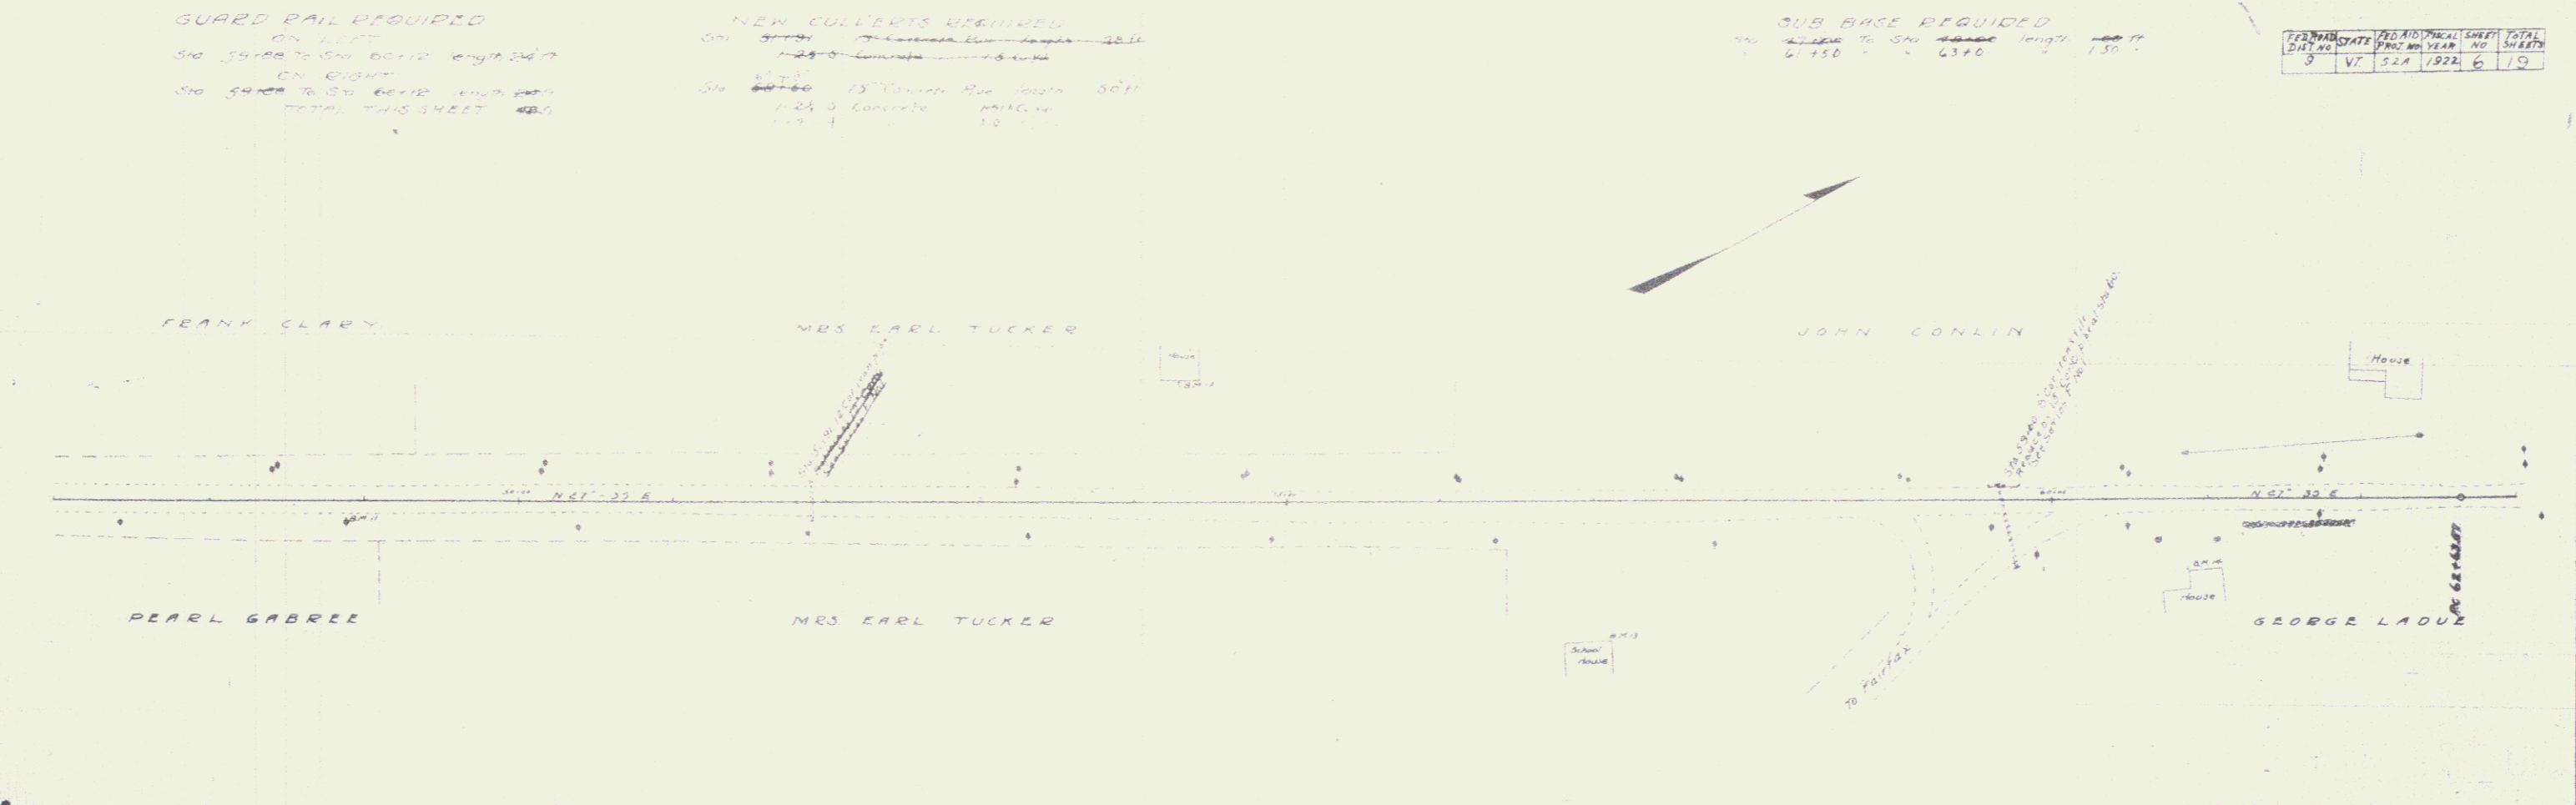

CLASH LINE
 50' SHARP TO 50' BOUND LENGTHENED
 ON CURVE TO 50' BOUND LENGTHENED
 TOTAL THIS SHEET 400'

SECTION 5
 SCALE 1" = 40'

5