

GUARD RAIL REQUIRED

14 ON LEFT

Sta 65+00 to Sta 65+40 length 40ft
 70+0000 - 70+0012 - 2ft
 75+9710 - 70+0044 - 2ft

16 ON RIGHT

Sta 65+00 to Sta 66+10 length 110ft
 70+0000 - 70+0032 - 2ft
 70+0032 - 75+0056 - 2ft

TOTAL THIS SHEET 200ft

NEW CULVERTS REQUIRED

Sta 65+30 2'x2' Concrete Box Reinforced
 1-2-4 Concrete 4-#35yd
 Reinforcing Steel 30' @ Earth Escor. 26 Cu Yds

Sta 70+00 2'x2' Concrete Box Reinforced
 1-2-4 Concrete 6-#35yd
 Reinforcing Steel 111' @ Earth Escor. 51 Cu Yds

Sta 75+00 18" Concrete Pipe length 33.30 ft
 1-2-4 Concrete 15 Cu Yds

SUB-BASE REQUIRED

Sta 63+00 to Sta 71+00 length 800ft
 72+75 - 74+34 - 161ft


DATE	SCALE	BY	CHECKED
9/19/24	1" = 40'	VF	VF

PLAN

DATE	SCALE	BY	CHECKED
9/19/24	1" = 40'	VF	VF

PROFILE

DATE	SCALE	BY	CHECKED
9/19/24	1" = 40'	VF	VF

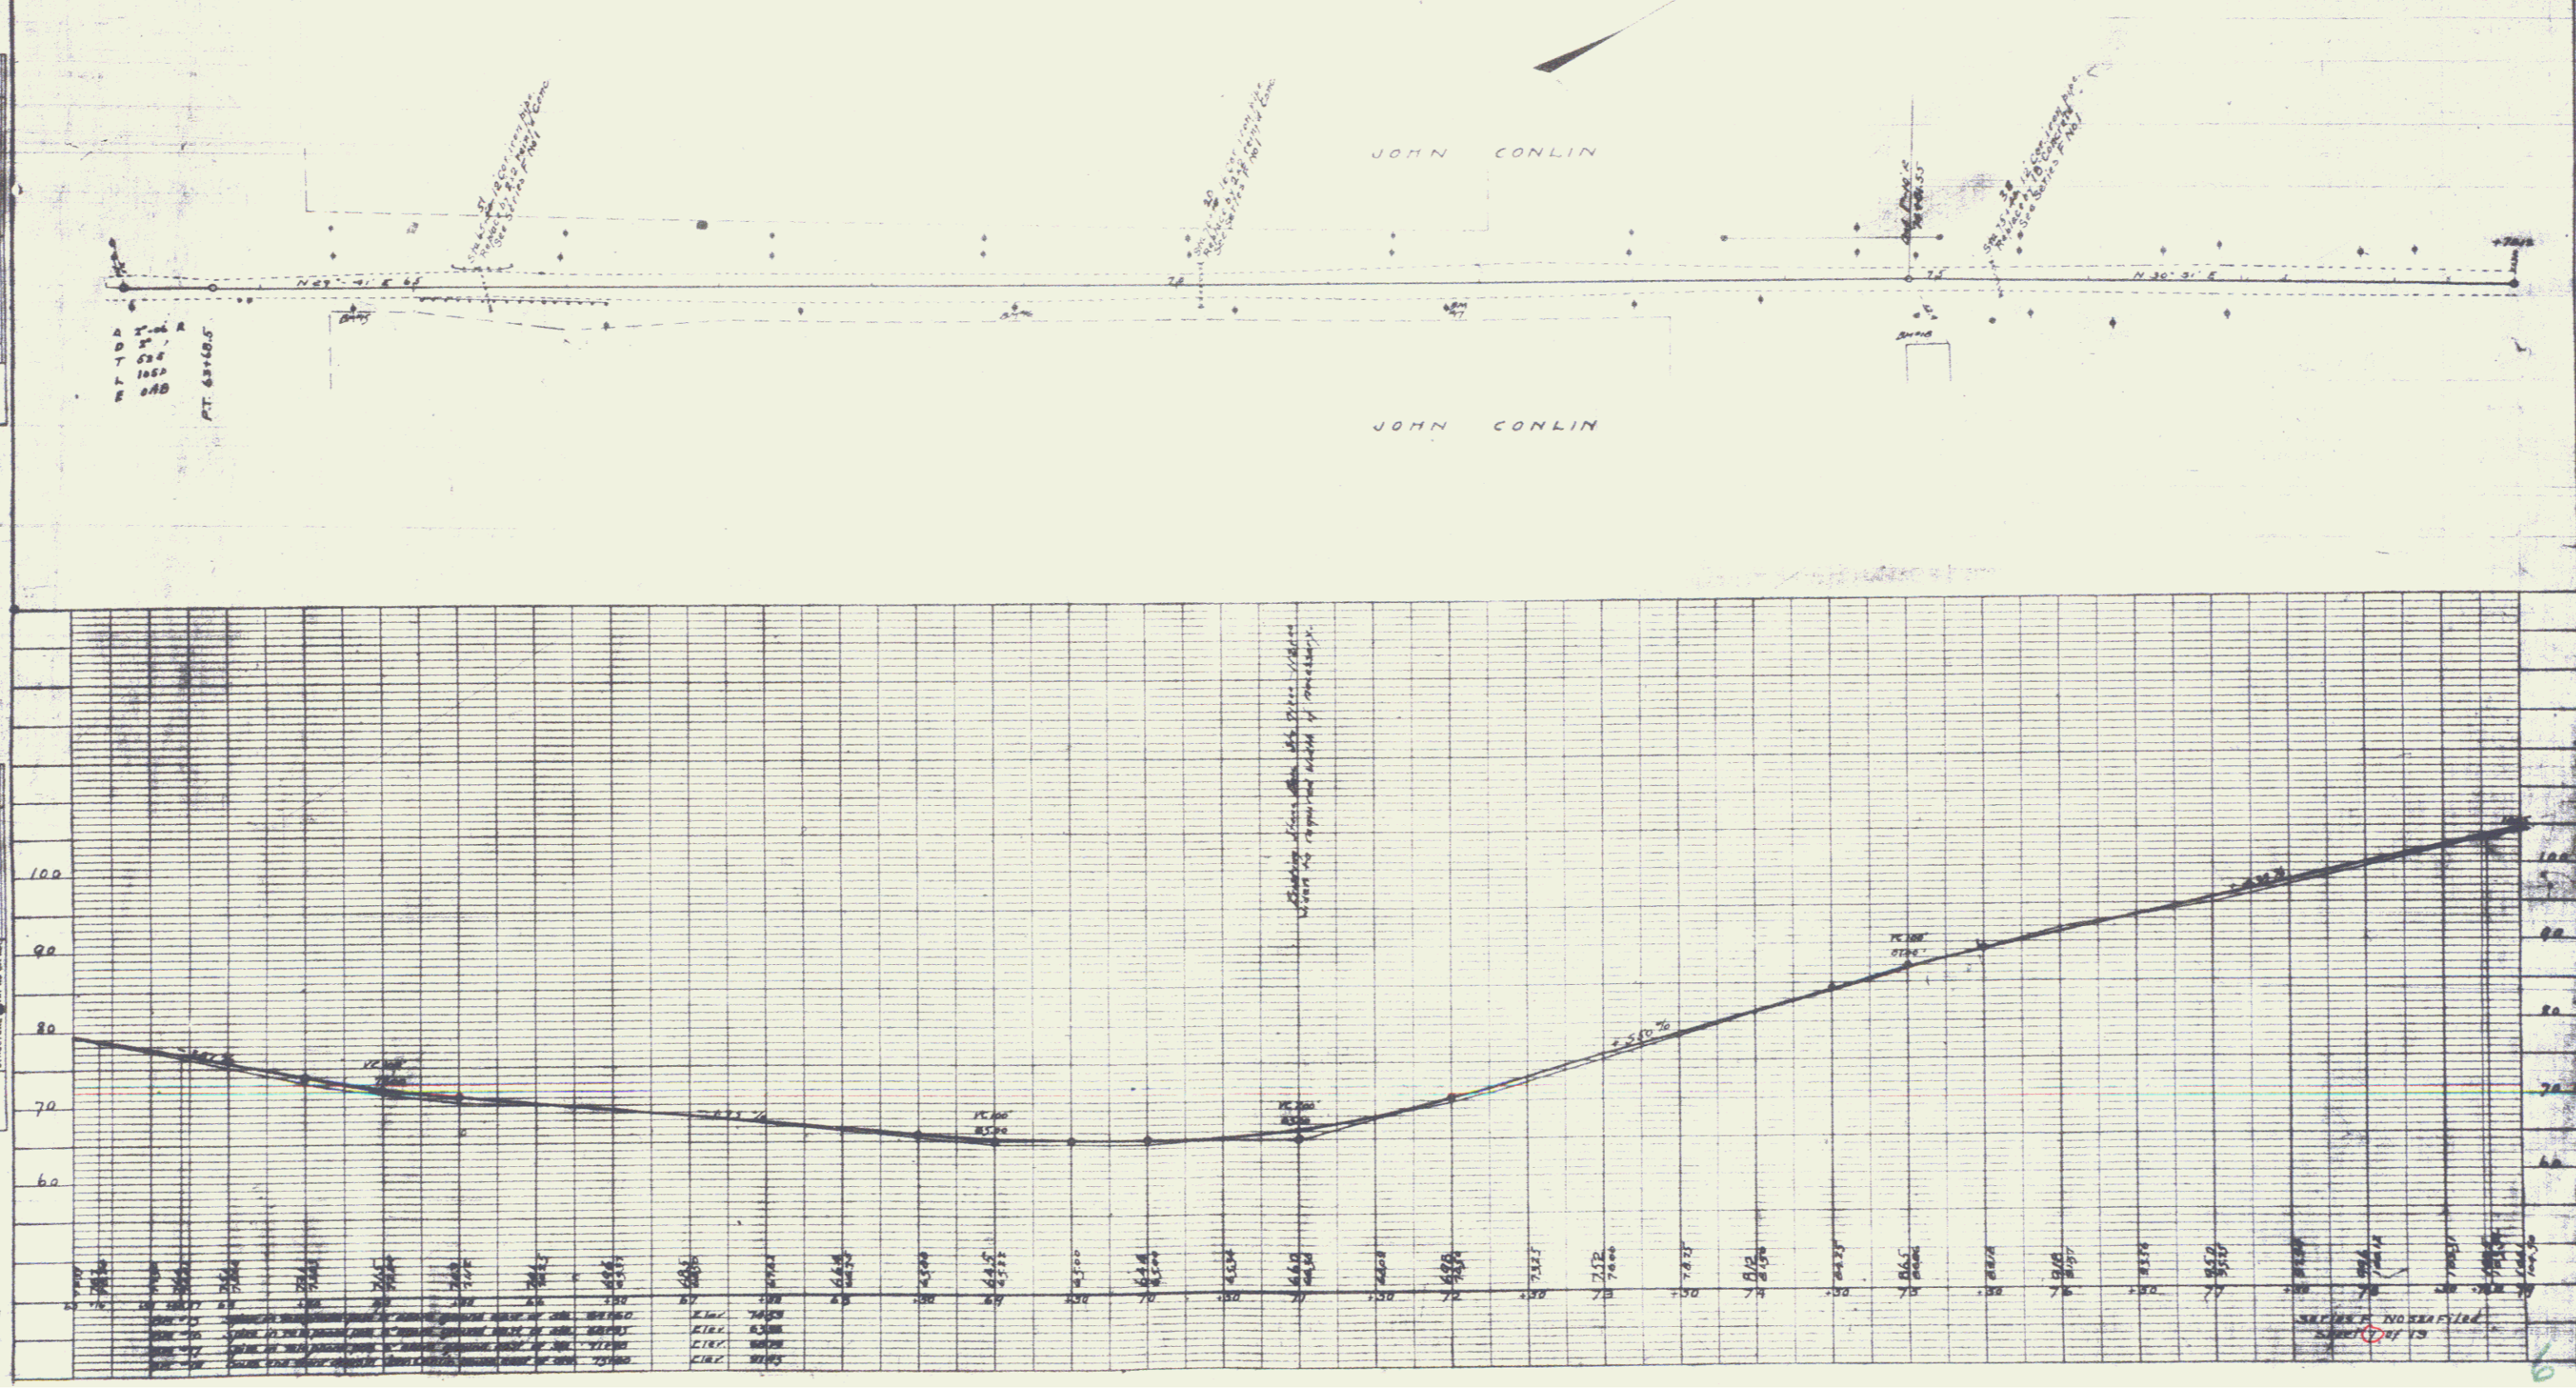

6