

INDEX OF SHEETS

SHEET NO. 1	TITLE PAGE
2	TYPICAL CROSS-SECTION OF IMPROVEMENT
3	BANKING AND WIDENING TABLES
4-12	PLAN AND PROFILE
13-14	DETAILS OF CONSTRUCTION (7 ONE COURSE CEMENT CONCRETE PAVEMENT)
15	STANDARD STRUCTURE SHEET S-28 PIPE CULVERTS
16	S-30 GUARD RAIL
17	S-30-A STD. DRAINAGE
18	S-31 SOUNDING MARKERS
19	SC-2-4 4x6 BOX
20	4x6 SIGNS
21	S-40 BARRICADES, SIGNS & LIGHTS
22	S-41 ROUNDING TOPS OF SLOPES
23-45	CROSS SECTIONS


STATE OF VERMONT
STATE HIGHWAY DEPARTMENT

PLAN AND PROFILE OF PROPOSED
STATE HIGHWAY


FEDERAL AID PROJECT
TOWN OF GEORGIA Pin# 99R427
ROUTE U.S. 7

BURLINGTON-ST. ALBANS ROAD

BEGINNING AT THE MILTON-GEORGIA TOWN LINE AND EXTENDING NORTHERLY 2.119 MILES TO THE SOUTHERLY TERMINUS OF F.A. 52B(1) PROJECT.
LENGTH OF PROJ: 11,190.2 FT. = 2.119 MILES

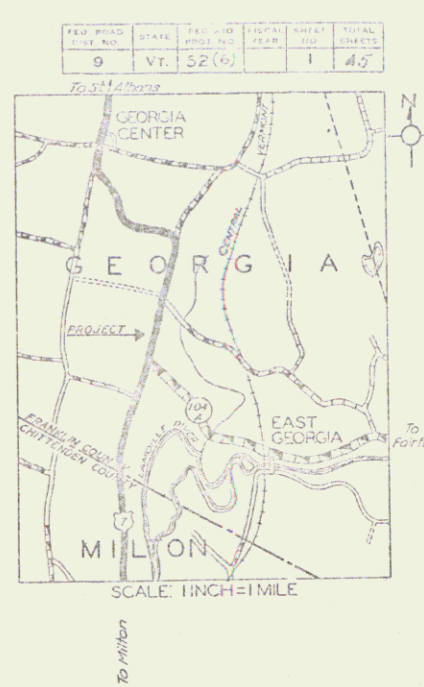


Handwritten 'E' and other markings.

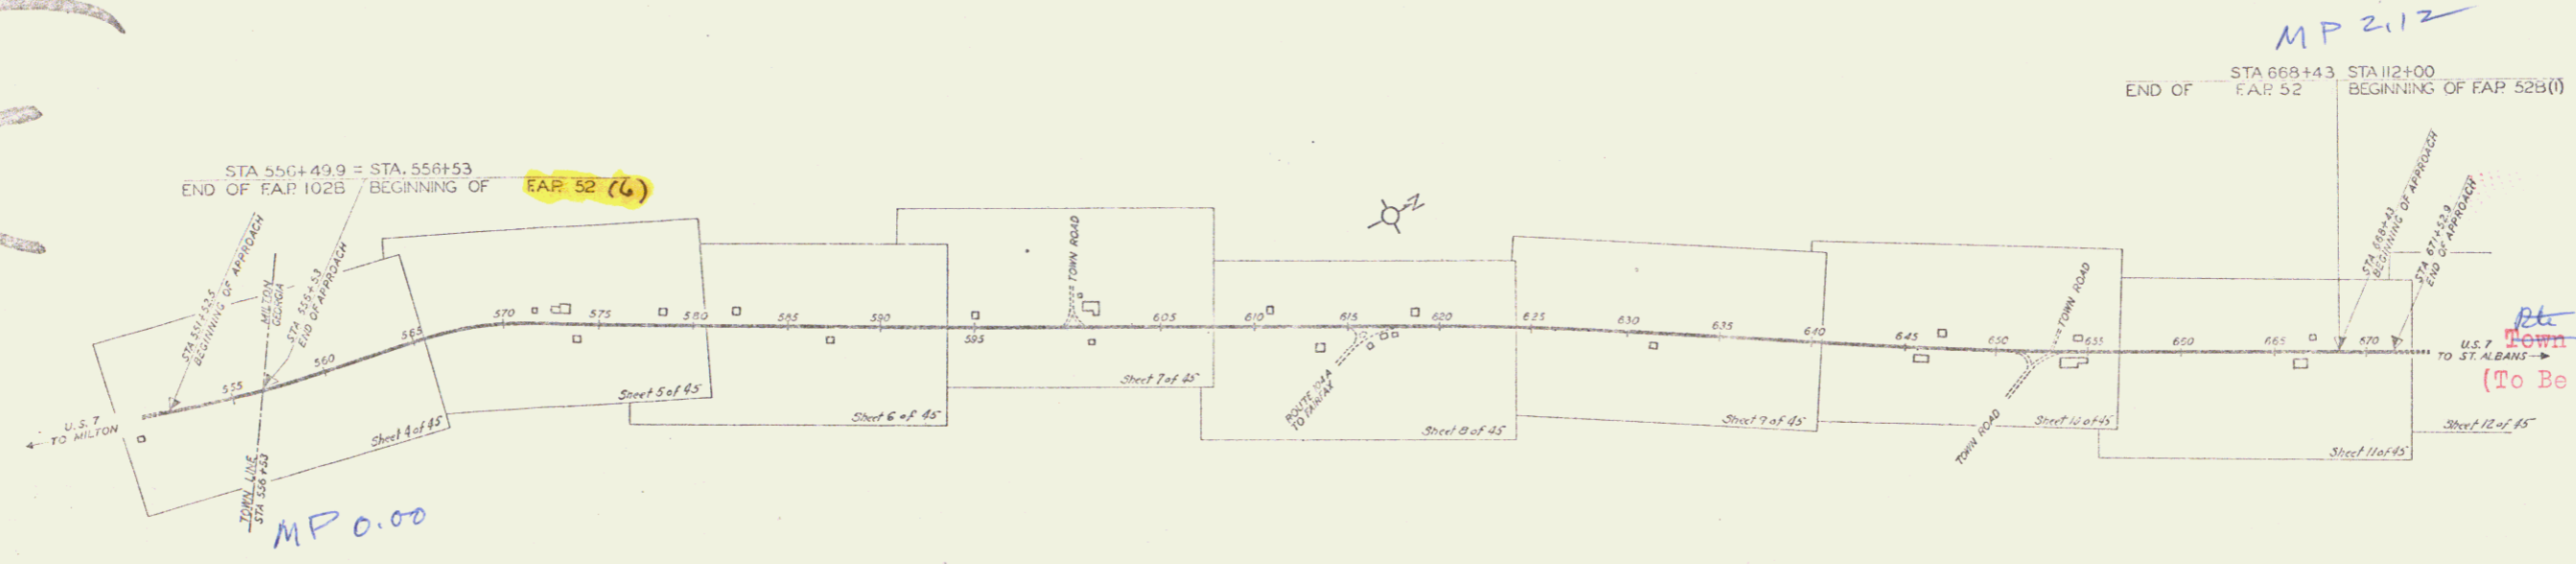

RIGHT-OF-WAY DIVISION
TOWN FILE
PERPETUAL
Town of U.S. 7
(To Be Returned To R.C.W. Division)

APPROVED: *[Signature]*
COMMISSIONER OF HIGHWAYS
SUBMITTED BY ORDER OF THE STATE HIGHWAY BOARD

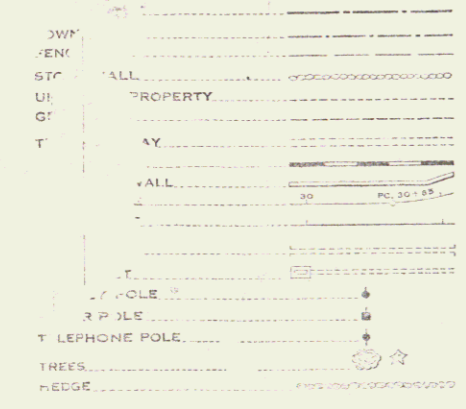

GROUND ELEVATION DATUM LINE

GRADE ELEVATION DATUM LINE

CURVE DATA

DEFLECTION ANGLE	Δ
DEGREE OF CURVE	D
RADIUS OF CURVE	R
TANGENT DISTANCE	T
LENGTH OF CURVE	L
EXTERNAL DISTANCE	E
POINT OF INTERSECTION	P. I.
POINT OF CURVE	P. C.
POINT OF TANGENT	P. T.
POINT ON TANGENT	P. O. T.

SCALES

TITLE	1" = 500'
TYPICAL	3/8" = 1'
PLAN	1" = 50'
HORIZONTAL	1" = 50'
PROFILE VERTICAL	1" = 10'
CROSS SECTIONS	1" = 5'

THESE PLANS ARE SUBJECT TO SUCH REVISIONS AS MAY BE REQUIRED BY THE PUBLIC ROADS ADMINISTRATION OR THE COMMISSIONER OF HIGHWAYS.

CONSTRUCTION IS TO BE CARRIED ON IN ACCORDANCE WITH THE PLANS AND THE STANDARD ROAD AND BRIDGE SPECIFICATIONS OF 1936, AS APPROVED DECEMBER 20TH, 1936 BY THE PUBLIC ROADS ADMINISTRATION, INCLUDING ALL SUBSEQUENT APPROVED REVISIONS AND SUCH REVISED SPECIFICATIONS AND SPECIAL PROVISIONS AS ARE SUBMITTED WITH THE PLANS.

RECOMMENDED FOR APPROVAL

APPROVED

APPROVED: *[Signature]* Sept 5 1944
ROAD FILE NO. 527
DISTRICT HIGHWAY COMMISSIONER

SERIES FA NO. 52(6) FILED
SHEET 6 OF 45