
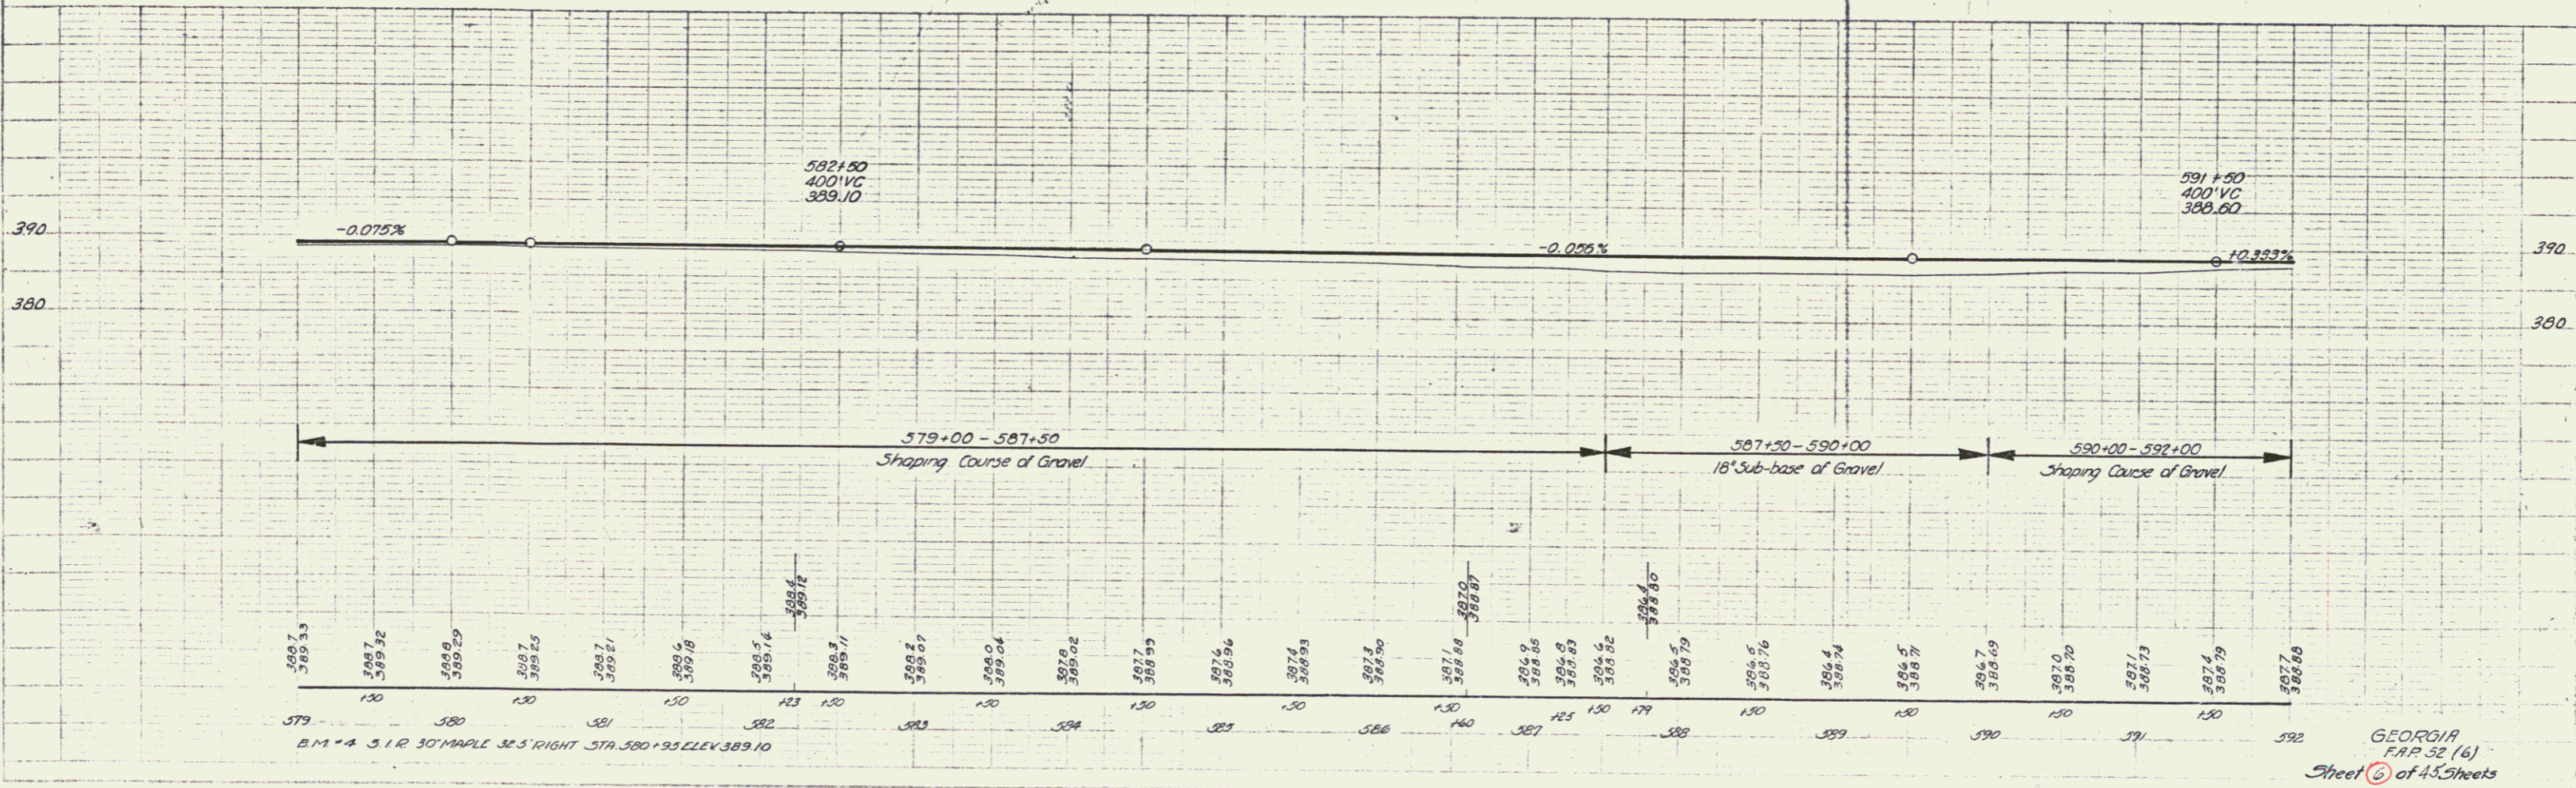


PARCEL	INSTRUMENT	DATE	GRANTOR	GRANTEE	RECORDED GEORGIA	REMARK
C	W.D.O.E.	8-9-44	JOHN M ^c GRATH	ST OF VT	BOOK PAGE DATE 23 565 66 8-16-44	
A	CONDEMN.	8-10-44	AFTON S HAYWARD	ST OF VT	23 567-73 8-18-44	

443 ROAD STATE PROJ. NO. 1741 ALL SHEET TOTAL SHEETS
Dist. No. 32(6) 6 45

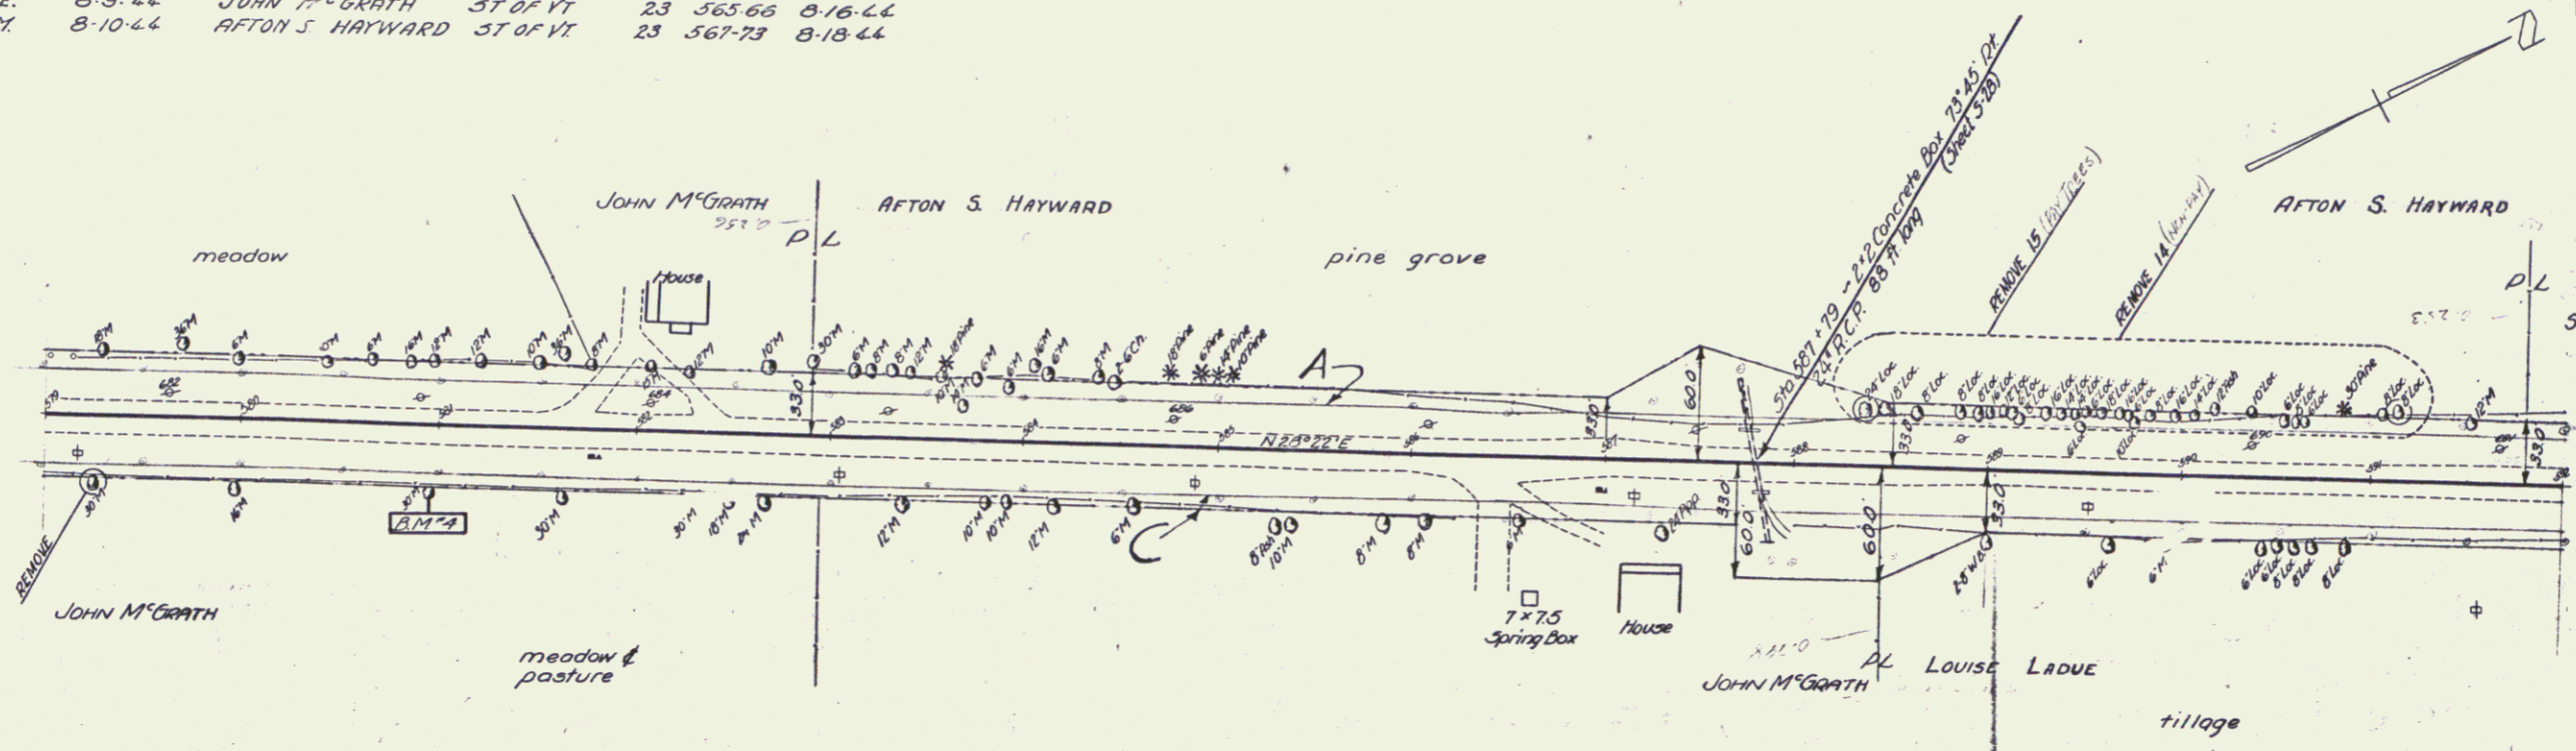

PLAN
Scale 1" = 40'
Date 12-30-44
Project Rogers

Profile
Scale 1" = 10'
Date 9-4-45
Project Rogers