



Seeding Slopes & Fertilizer Items 614 615
Sta. 84+00 ~ 90+50 LI & RT

Construct Drive
Sta. 87+90 RI
Sta. 95+00 RT

3 Cable Guard Rail with Steel Posts Item 543
Sta. 84+00 to 90+50 LI & RT
88122 to 90+75 RT

Cut to Fill Transition
97+45 - 98+20
Treated Timber Curb Item 558
Sta. 8E+19 ~ 90+81 RI 242 U.

Drilling and Blasting of Solid Rock Subgrade Item 114 Mod
Sta. 84+00 to Sta. 87+00
Sta. 91+00 to Sta. 93+00
Sta. 97+45 to Sta. 98+20

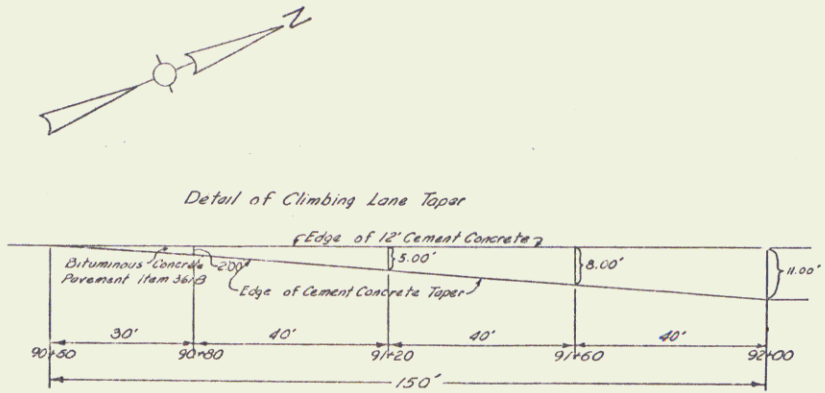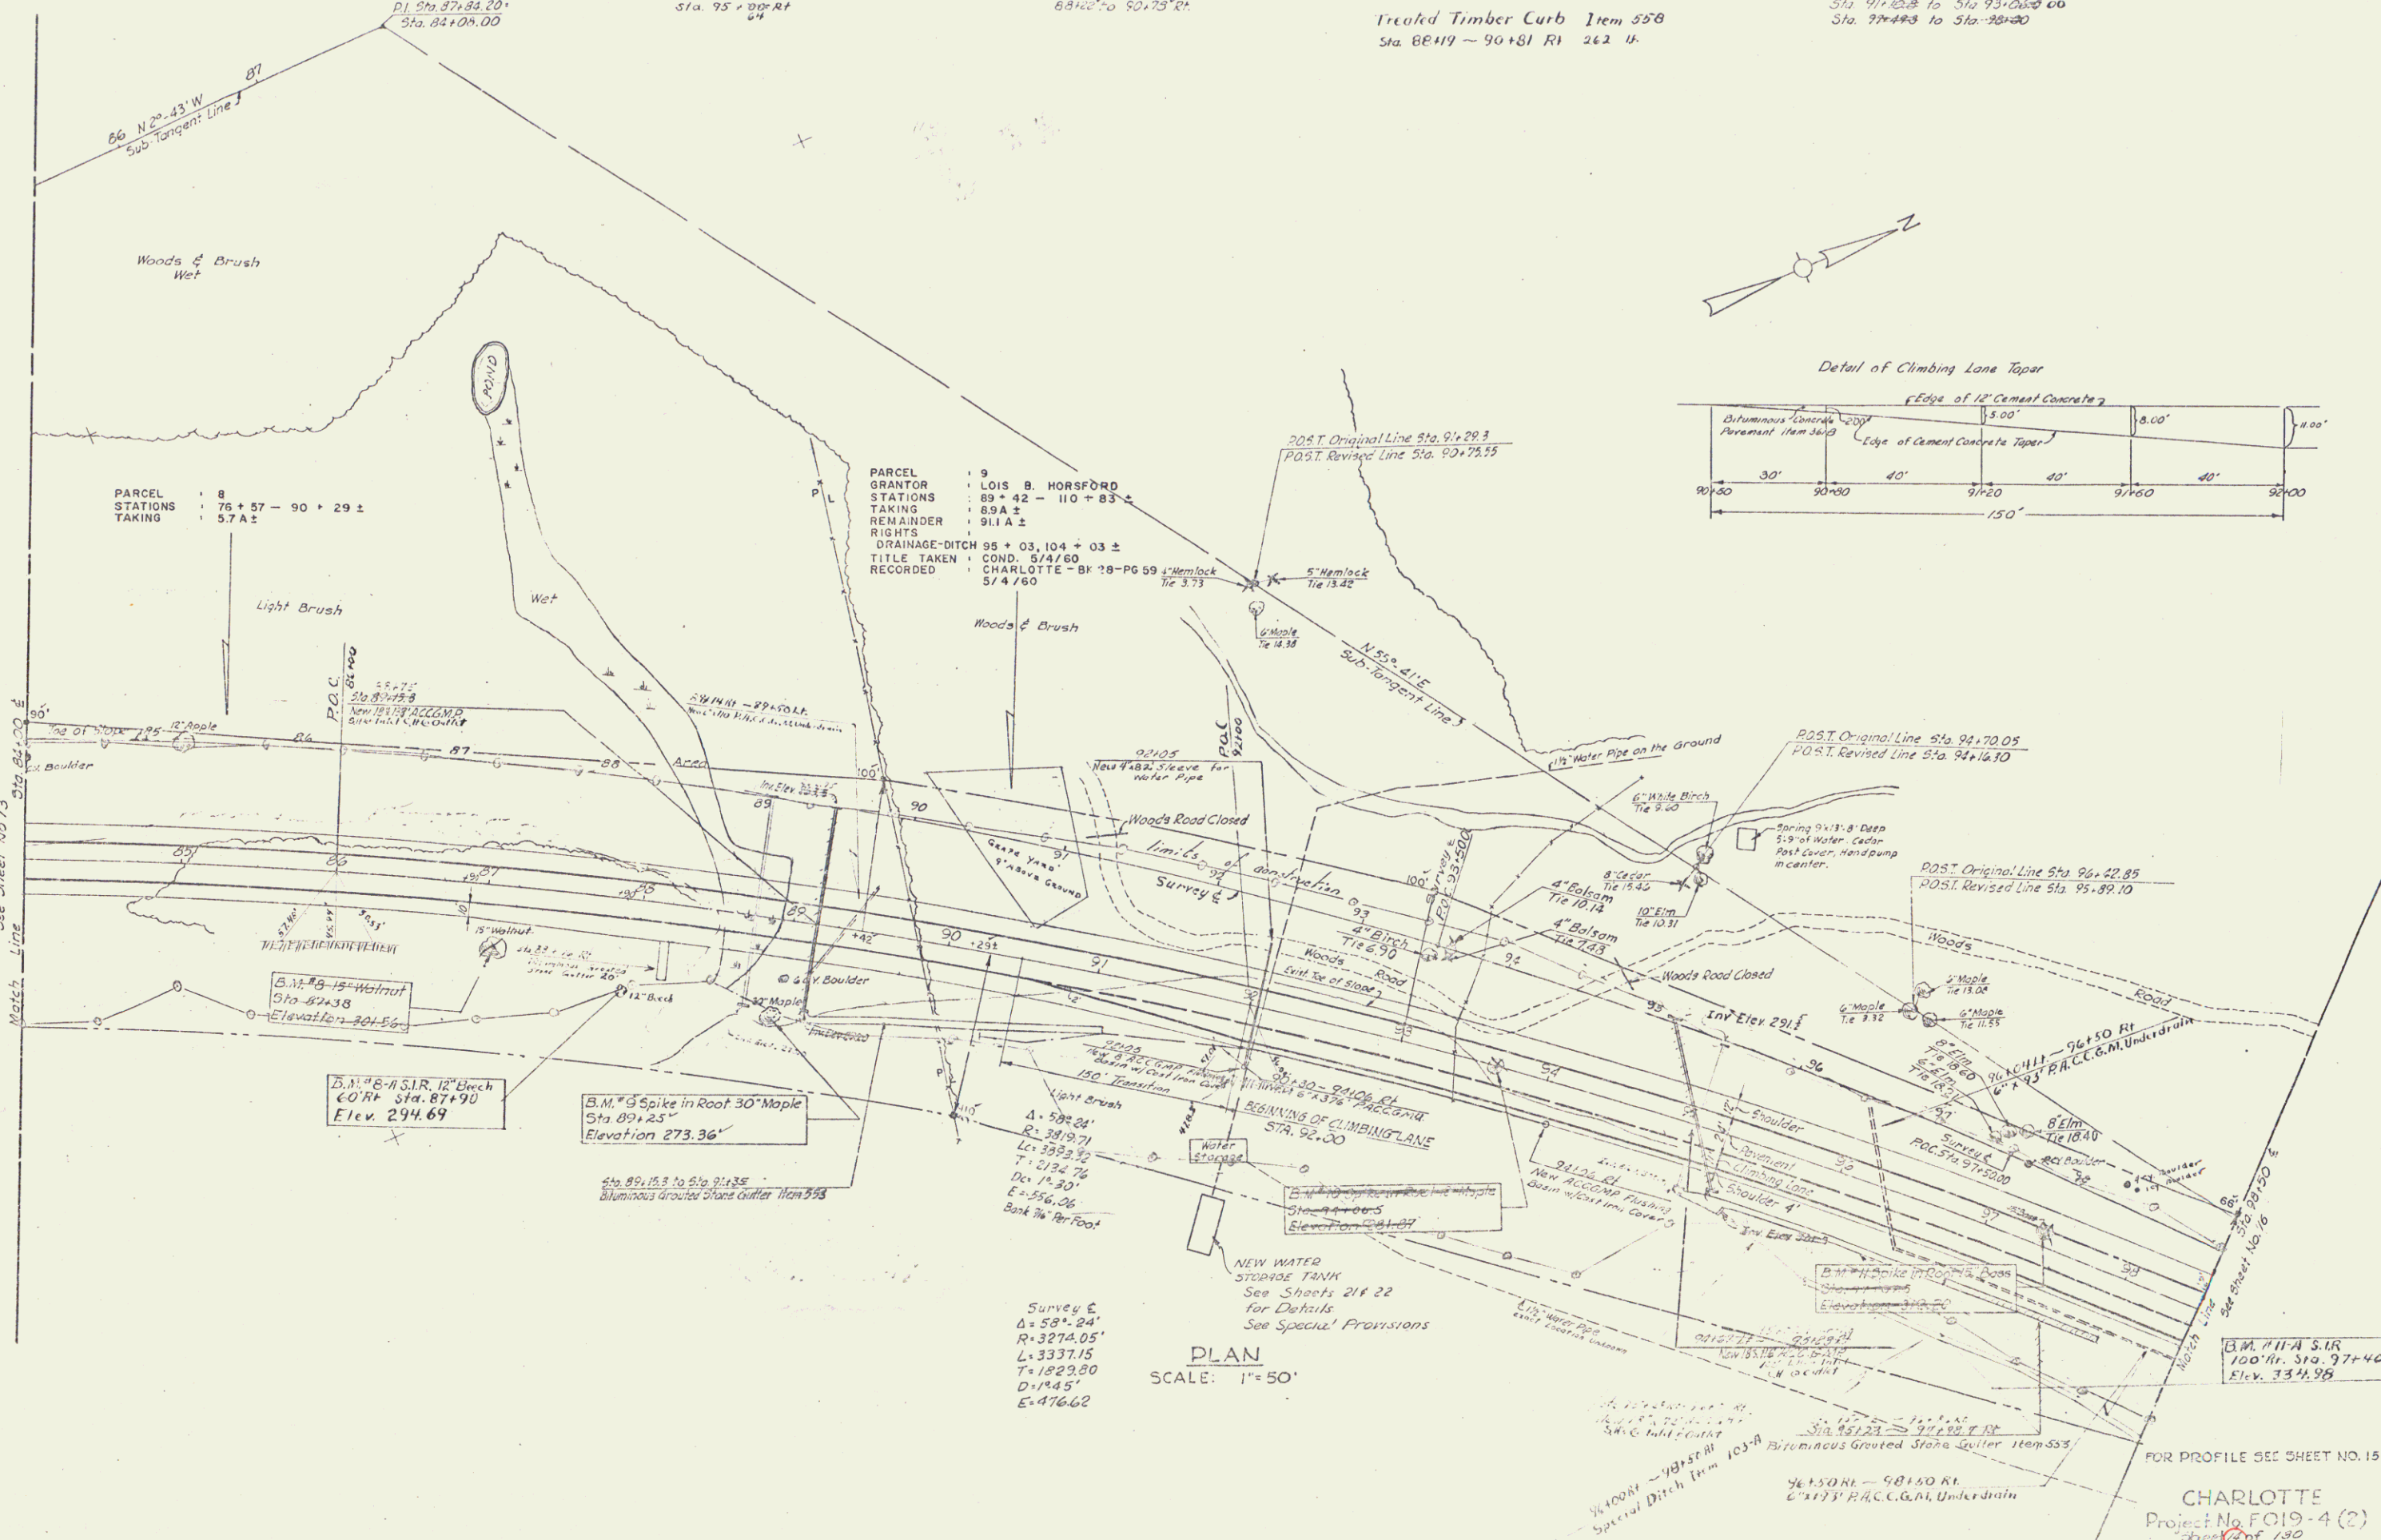

PARCEL 8
STATIONS 76+57 - 90+29 ±
TAKING 57 A ±

PARCEL 9
GRANTOR LOIS B. HORSFORD
STATIONS 89+42 - 110+83 ±
TAKING 89 A ±
REMAINDER 91 A ±
RIGHTS
DRAINAGE-DITCH 95+03, 104+03 ±
TITLE TAKEN COND. 5/4/60
RECORDED CHARLOTTE-BK 18-PG 59
5/4/60

Survey E
Δ = 58° 24'
R = 3274.05'
L = 3337.15'
T = 1823.00'
D = 194.5'
E = 476.62'

PLAN
SCALE: 1" = 50'

FOR PROFILE SEE SHEET NO. 15
CHARLOTTE
Project No. FO19-4 (2)
Sheet 1 of 100

7