


PLAN  
 DATE: \_\_\_\_\_  
 BY: \_\_\_\_\_  
 CHECKED: \_\_\_\_\_  
 NOTE BOOK: \_\_\_\_\_  
 NO. OF BAY CHECKED: \_\_\_\_\_  
 NO. \_\_\_\_\_

PROFILE  
 DATE: \_\_\_\_\_  
 BY: \_\_\_\_\_  
 CHECKED: \_\_\_\_\_  
 NOTE BOOK: \_\_\_\_\_  
 NO. OF BAY CHECKED: \_\_\_\_\_  
 NO. \_\_\_\_\_

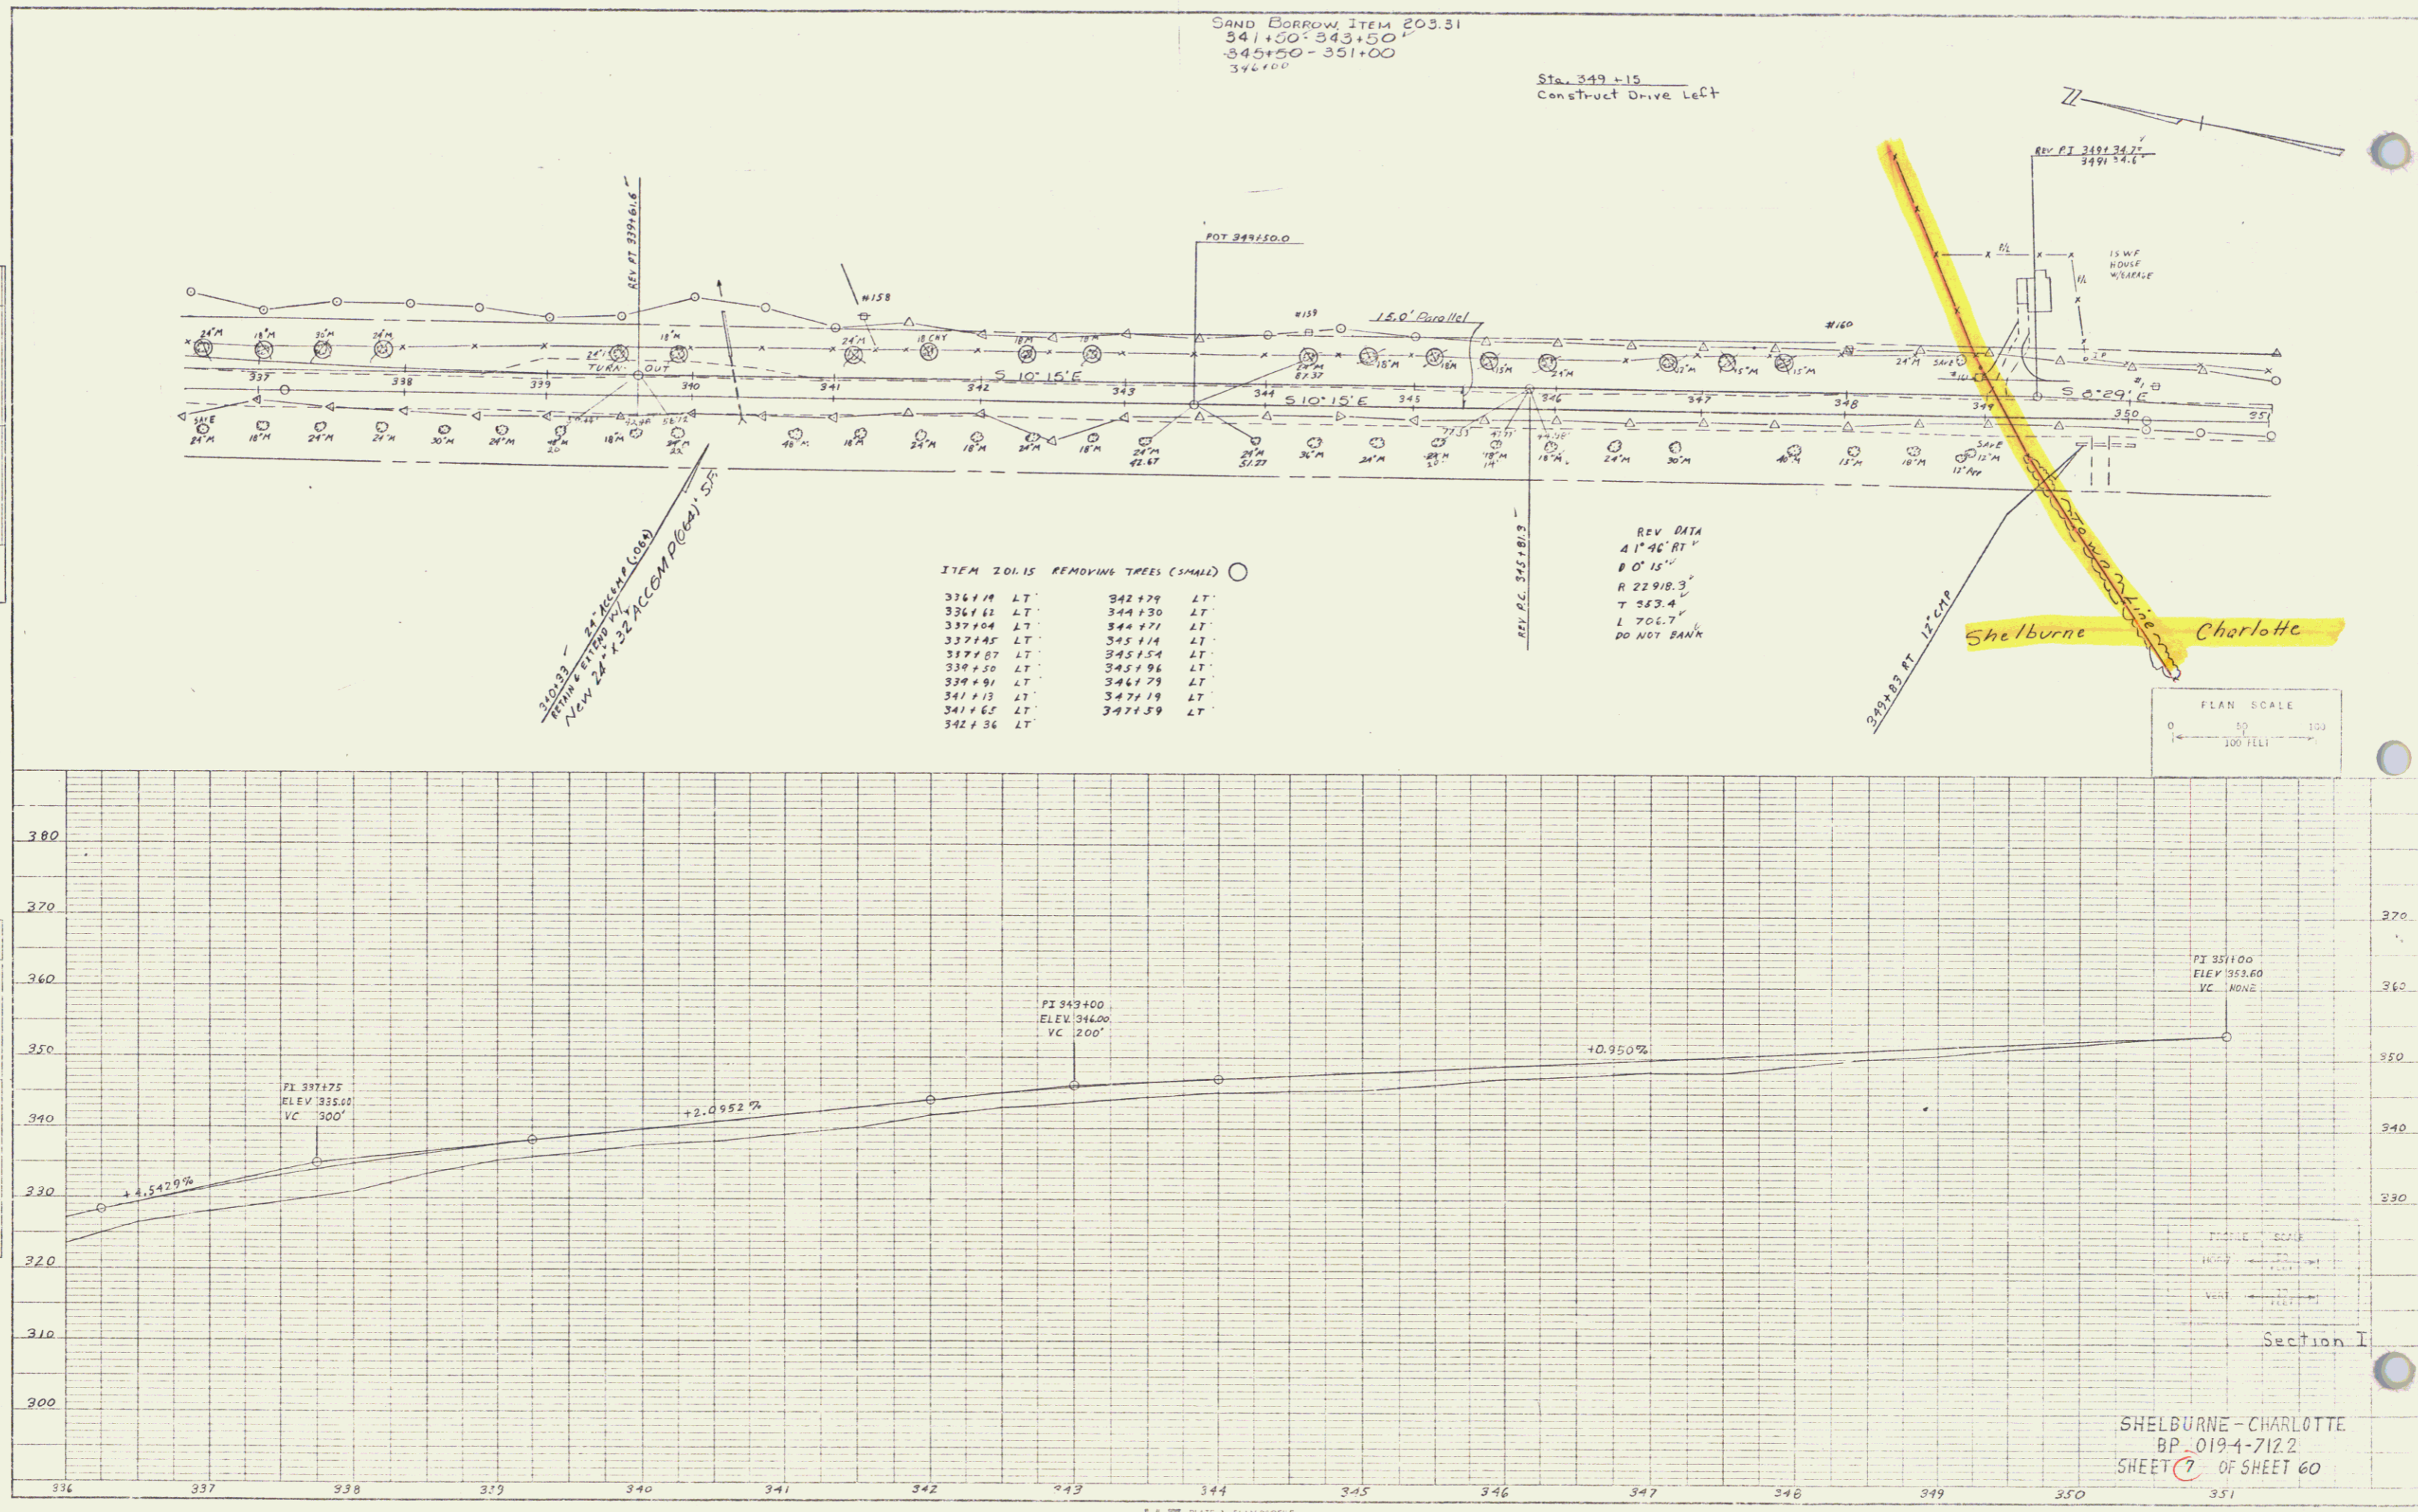

ITEM 201.15 REMOVING TREES (SMALL)

336+14	LT	342+79	LT
336+61	LT	344+30	LT
337+04	LT	344+77	LT
337+45	LT	345+14	LT
337+87	LT	345+54	LT
338+20	LT	345+96	LT
338+91	LT	346+79	LT
341+13	LT	347+19	LT
341+62	LT	347+59	LT
342+56	LT		

REV. DATA  
 4" 46' RT"  
 0' 15"  
 R 22918.3'  
 T 383.4'  
 L 706.1'  
 DO NOT BANK

PLAN SCALE  
 0 50 100  
 1" = 100' (H.L.)

Section I  
 SHELburne - CHARLOTTE  
 BP 019-4-712.2  
 SHEET 7 OF SHEET 60