



SAND BORROW ITEM 203.31
351+00 - 353+00.50



REV DATA
4 0° 53' 21"
D 1"
R 5729.58'
T 44.17'
L 88.32'

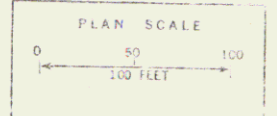

PLAN
DATE: _____
BY: _____
CHECKED: _____
NOTED: _____
NO. _____

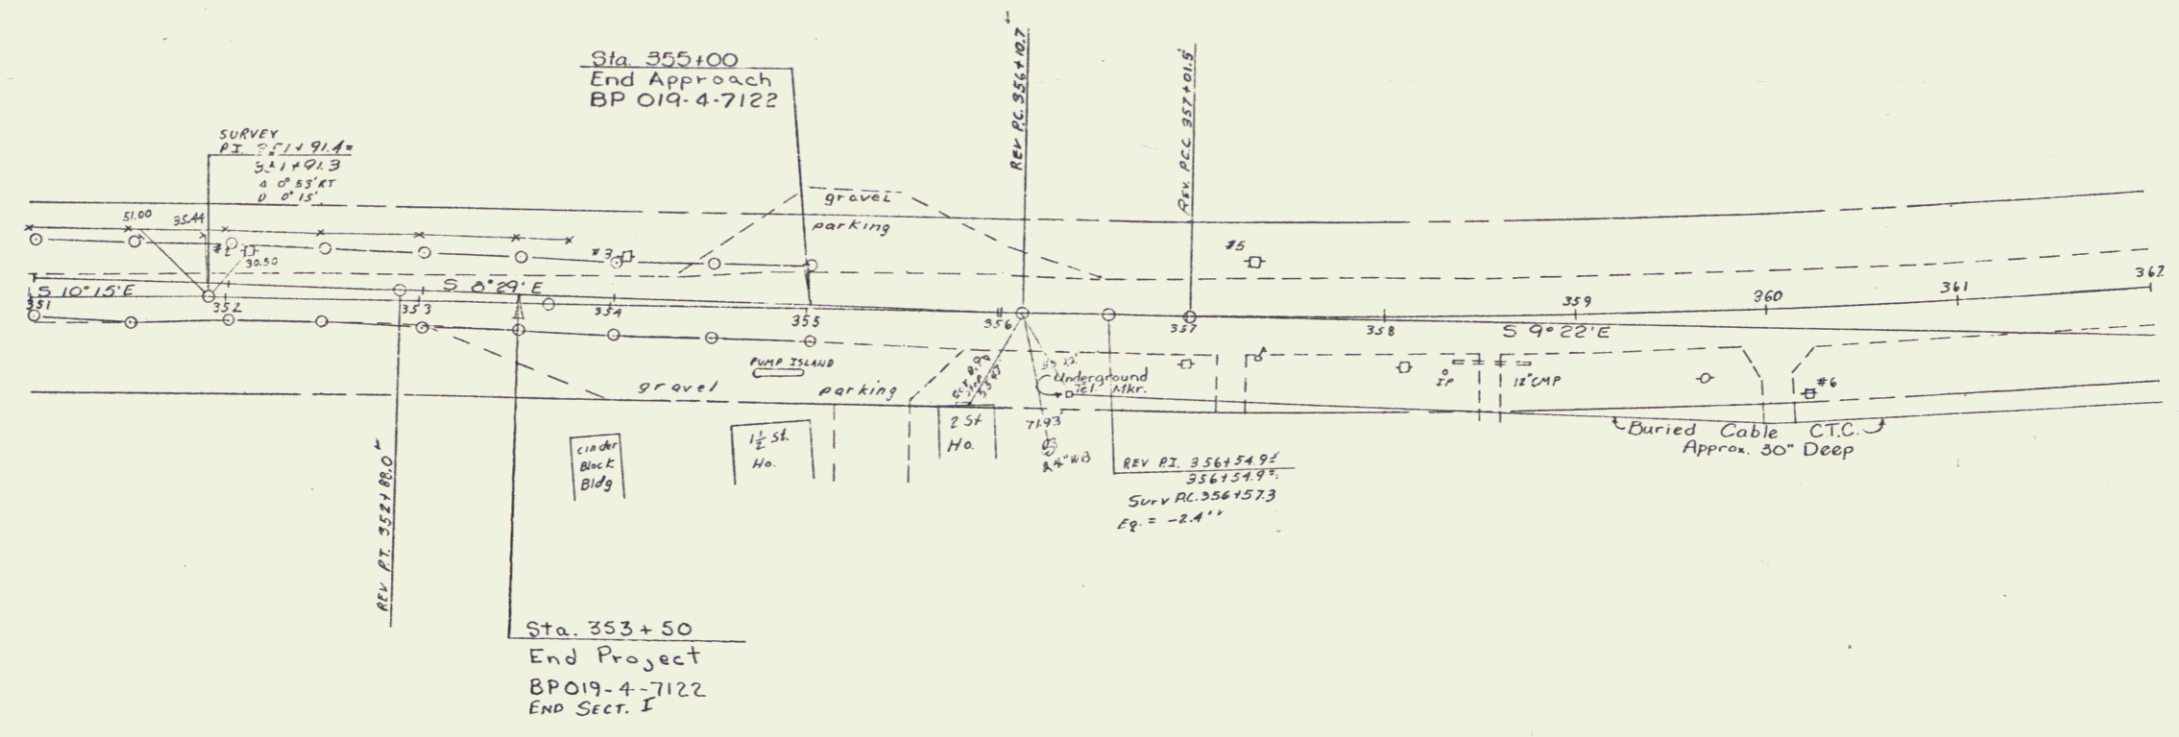

PROFILE
DATE: _____
BY: _____
CHECKED: _____
NOTED: _____
NO. _____

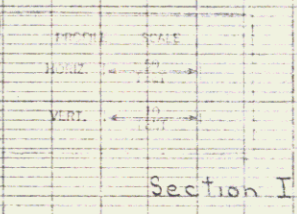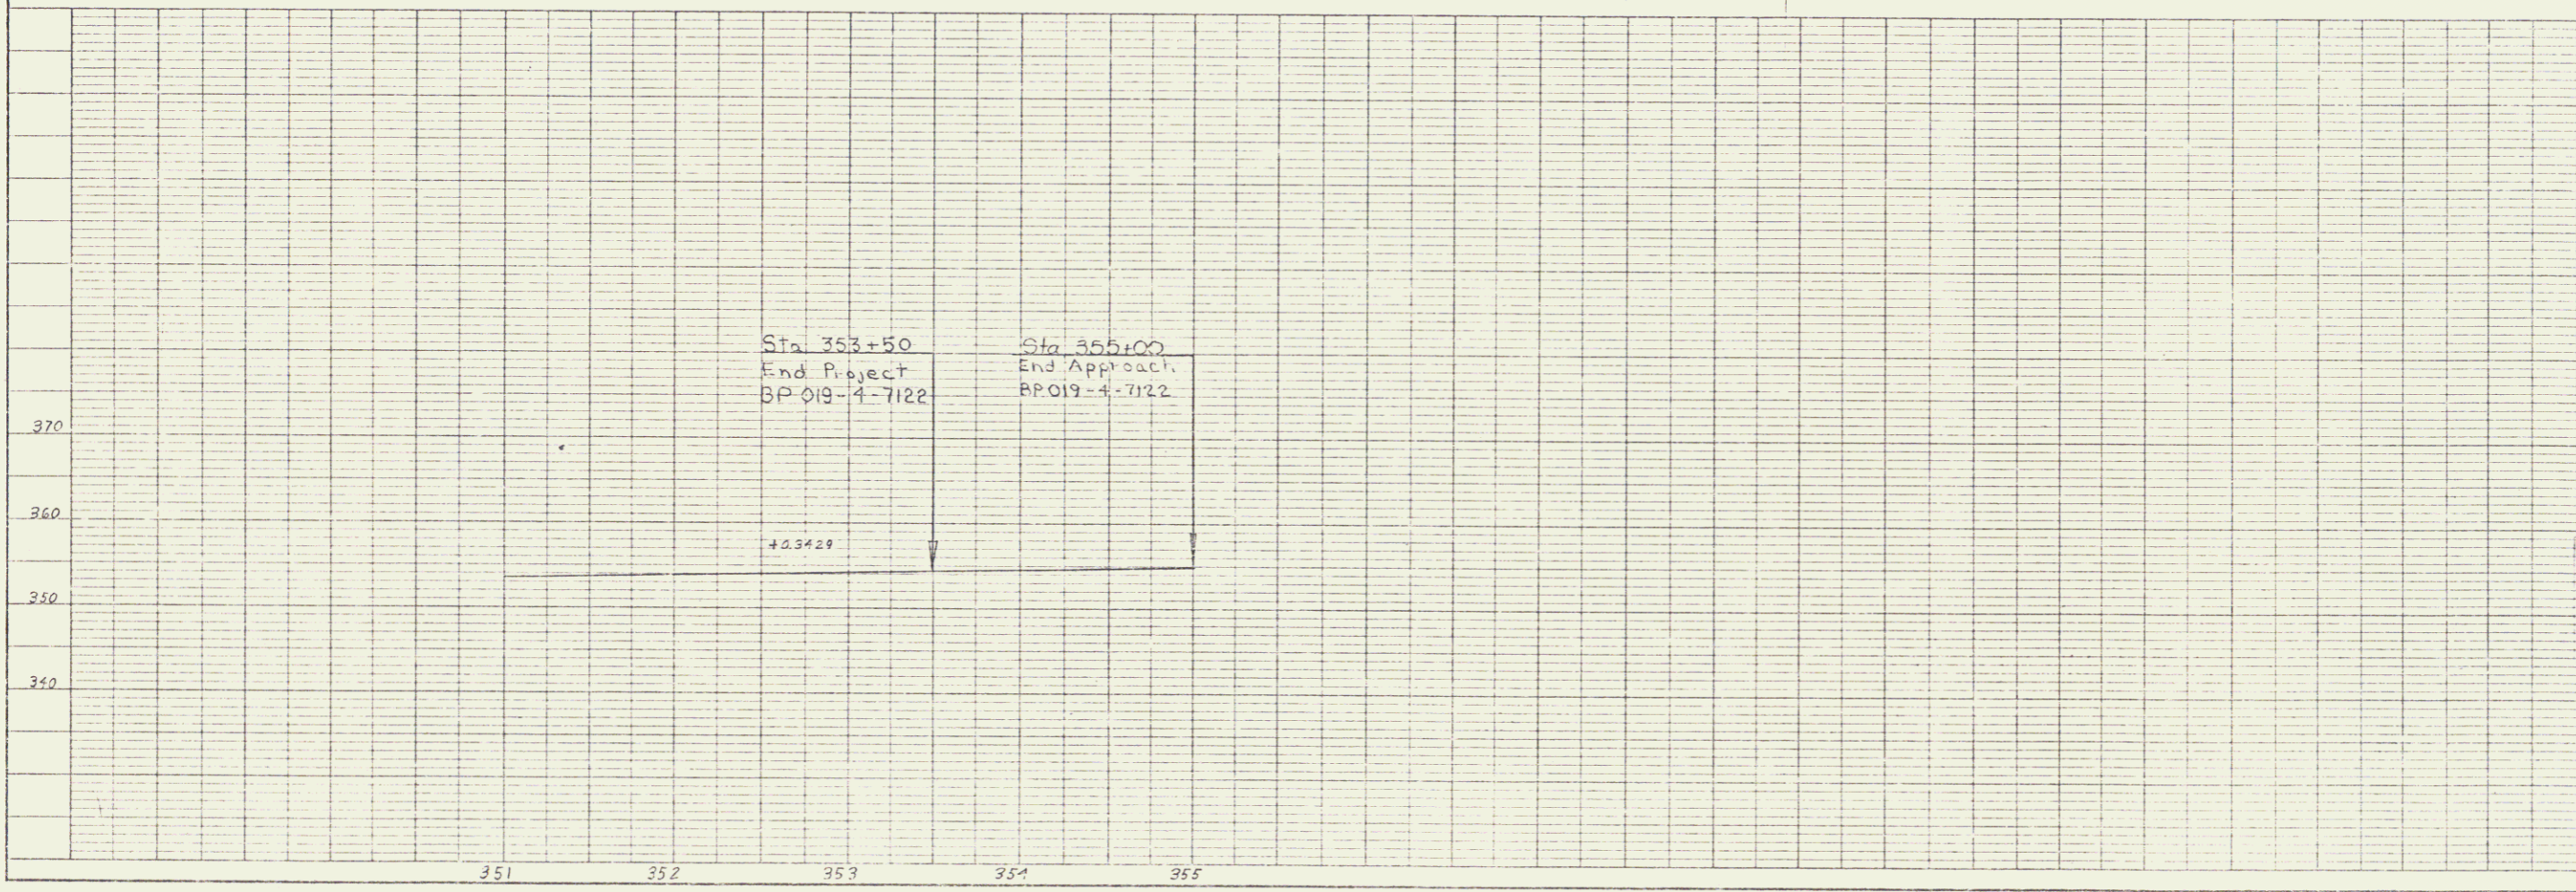

SHELburne - CHARLOTTE
BP 019-4-7122
SHEET 6 OF SHEET 60