
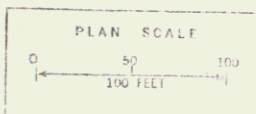


PLAN
 DRAWN BY: J. T. WELLS
 CHECKED BY: W. J. STANFORD
 DATE: 1/22/52
 NOTE BOOK NO. 35222
 RT. OF WAY CHECKED

PROFILE
 DRAWN BY: J. T. WELLS
 CHECKED BY: W. J. STANFORD
 DATE: 1/22/52
 NOTE BOOK NO. 35222
 RT. OF WAY CHECKED

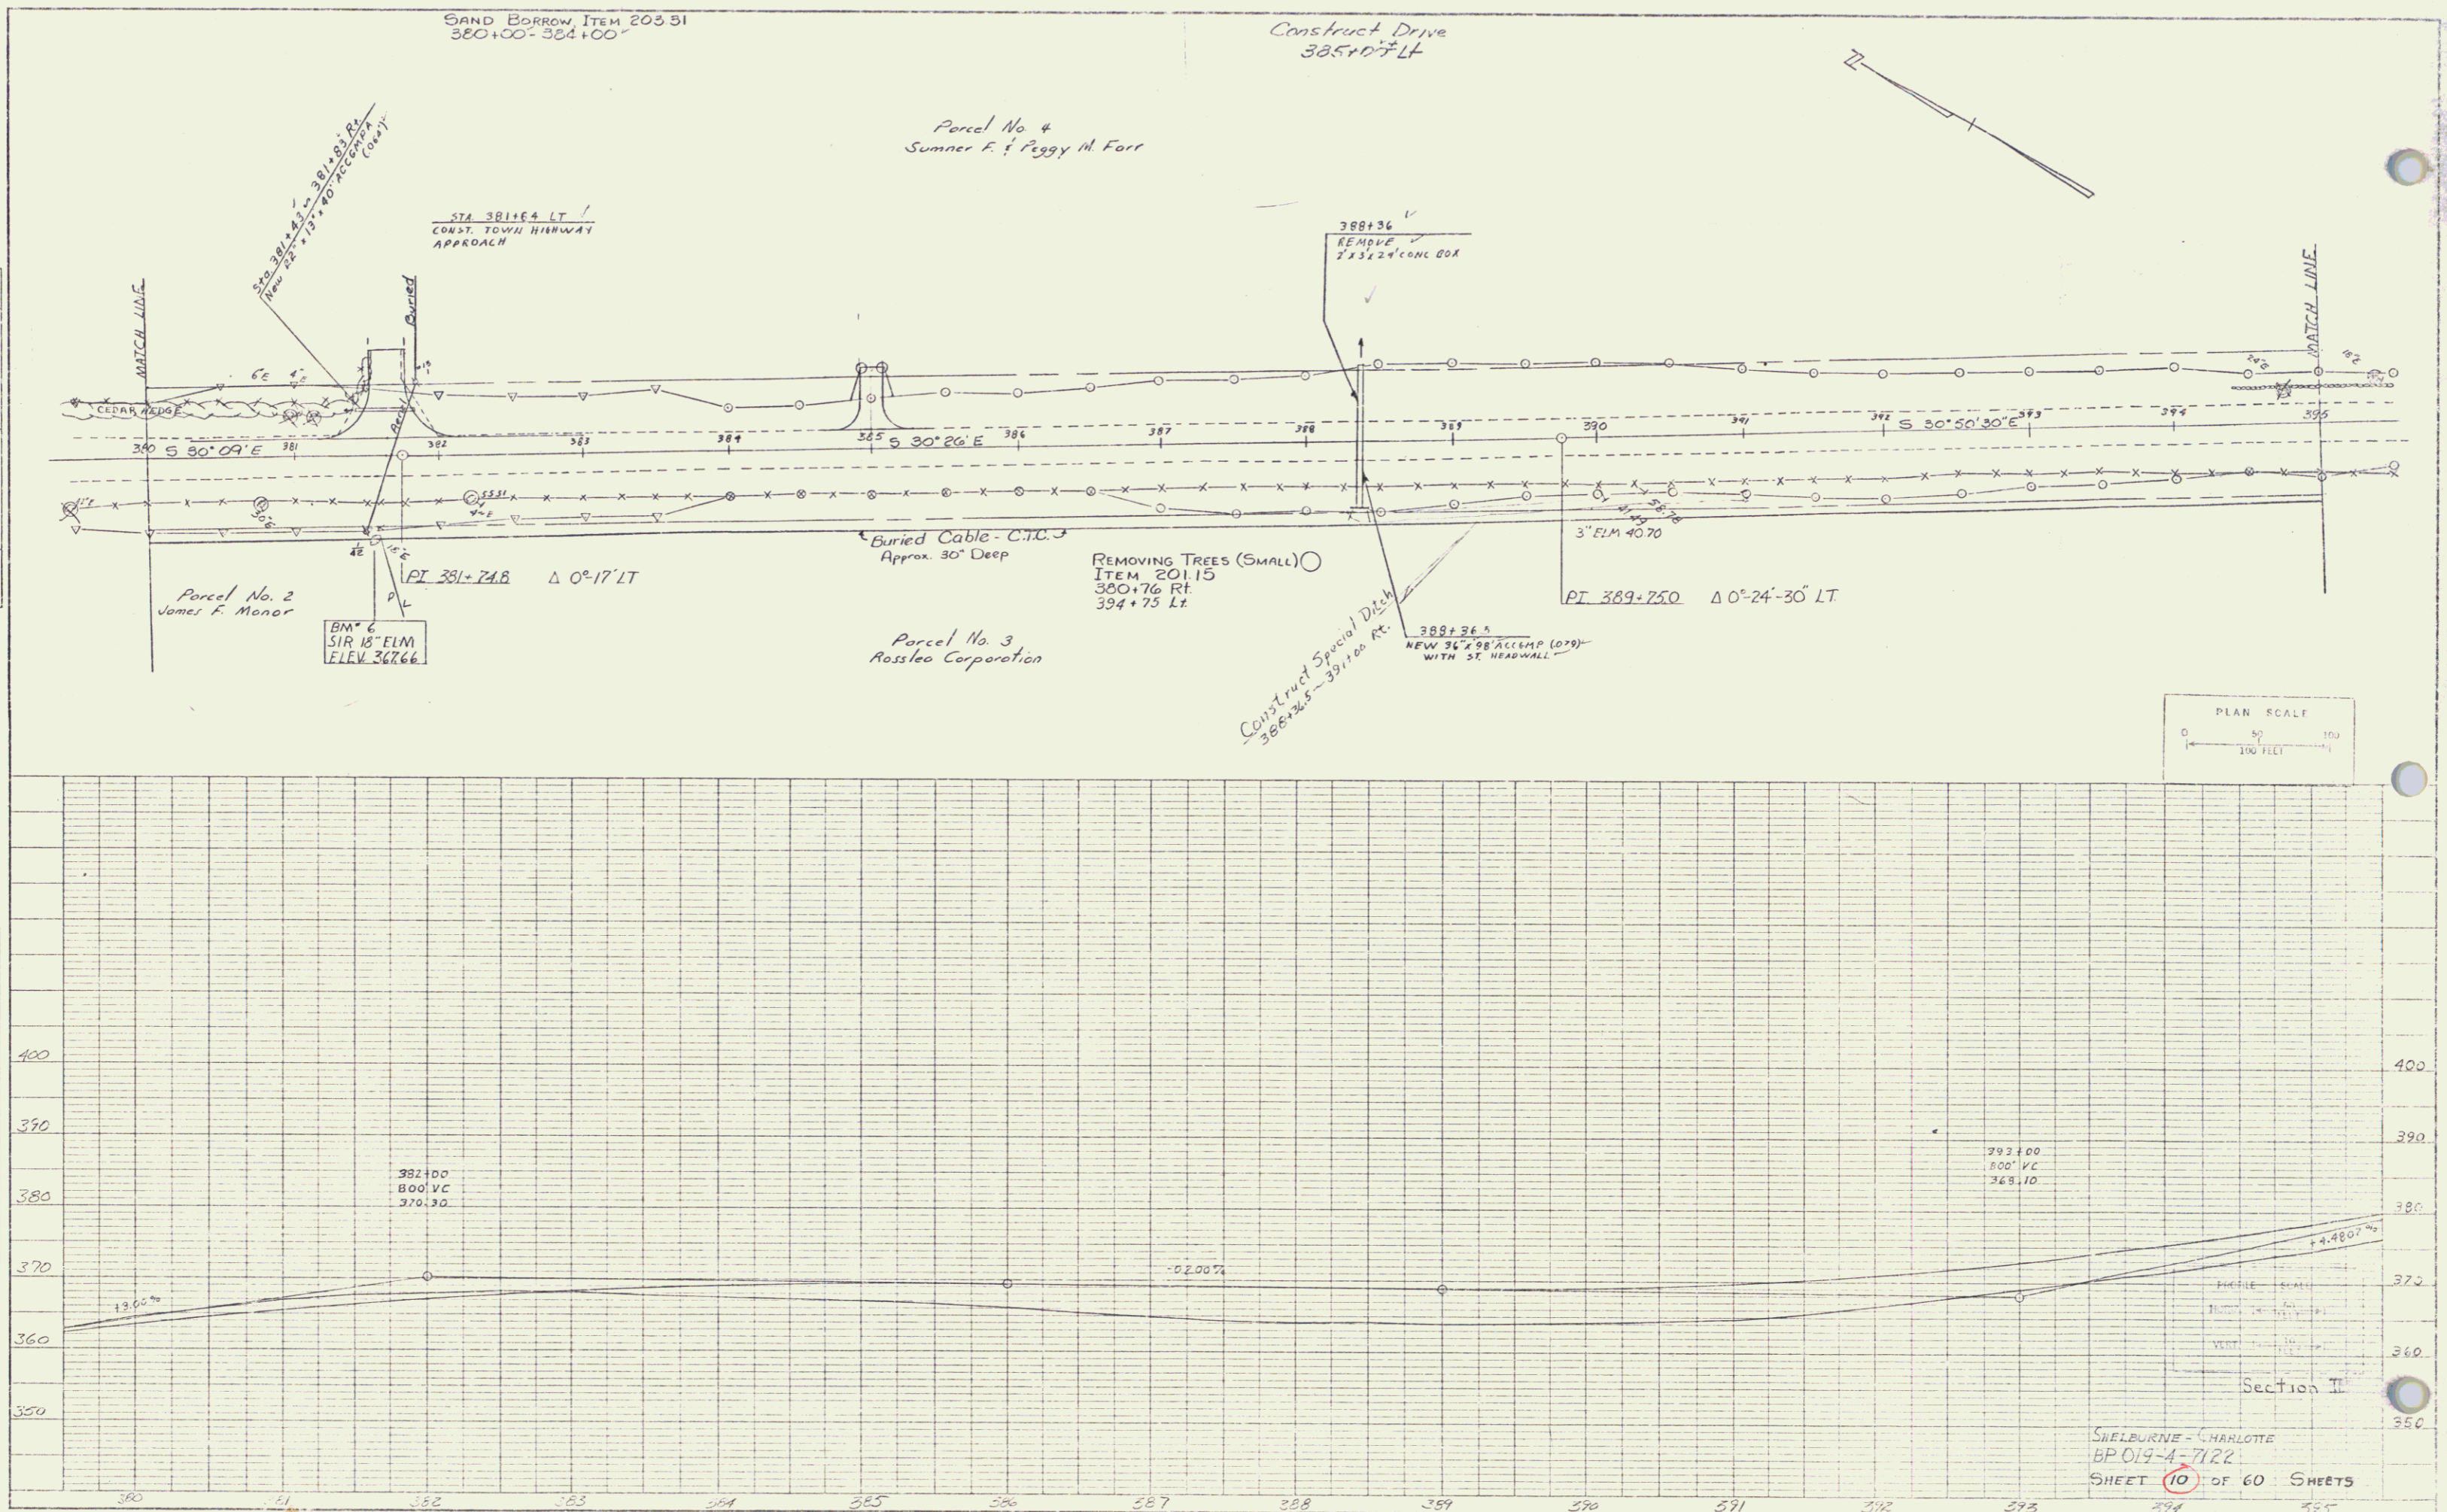

Section II

SHELburne - CHARLOTTE
 BP 019-A-7122
 SHEET 10 OF 60 SHEETS

PLATE I, PLAN & PROFILE
 HOFF & TULL, INC.
 48 7012 PHOENIX ST. - CHARLOTTE, N.C.

6