
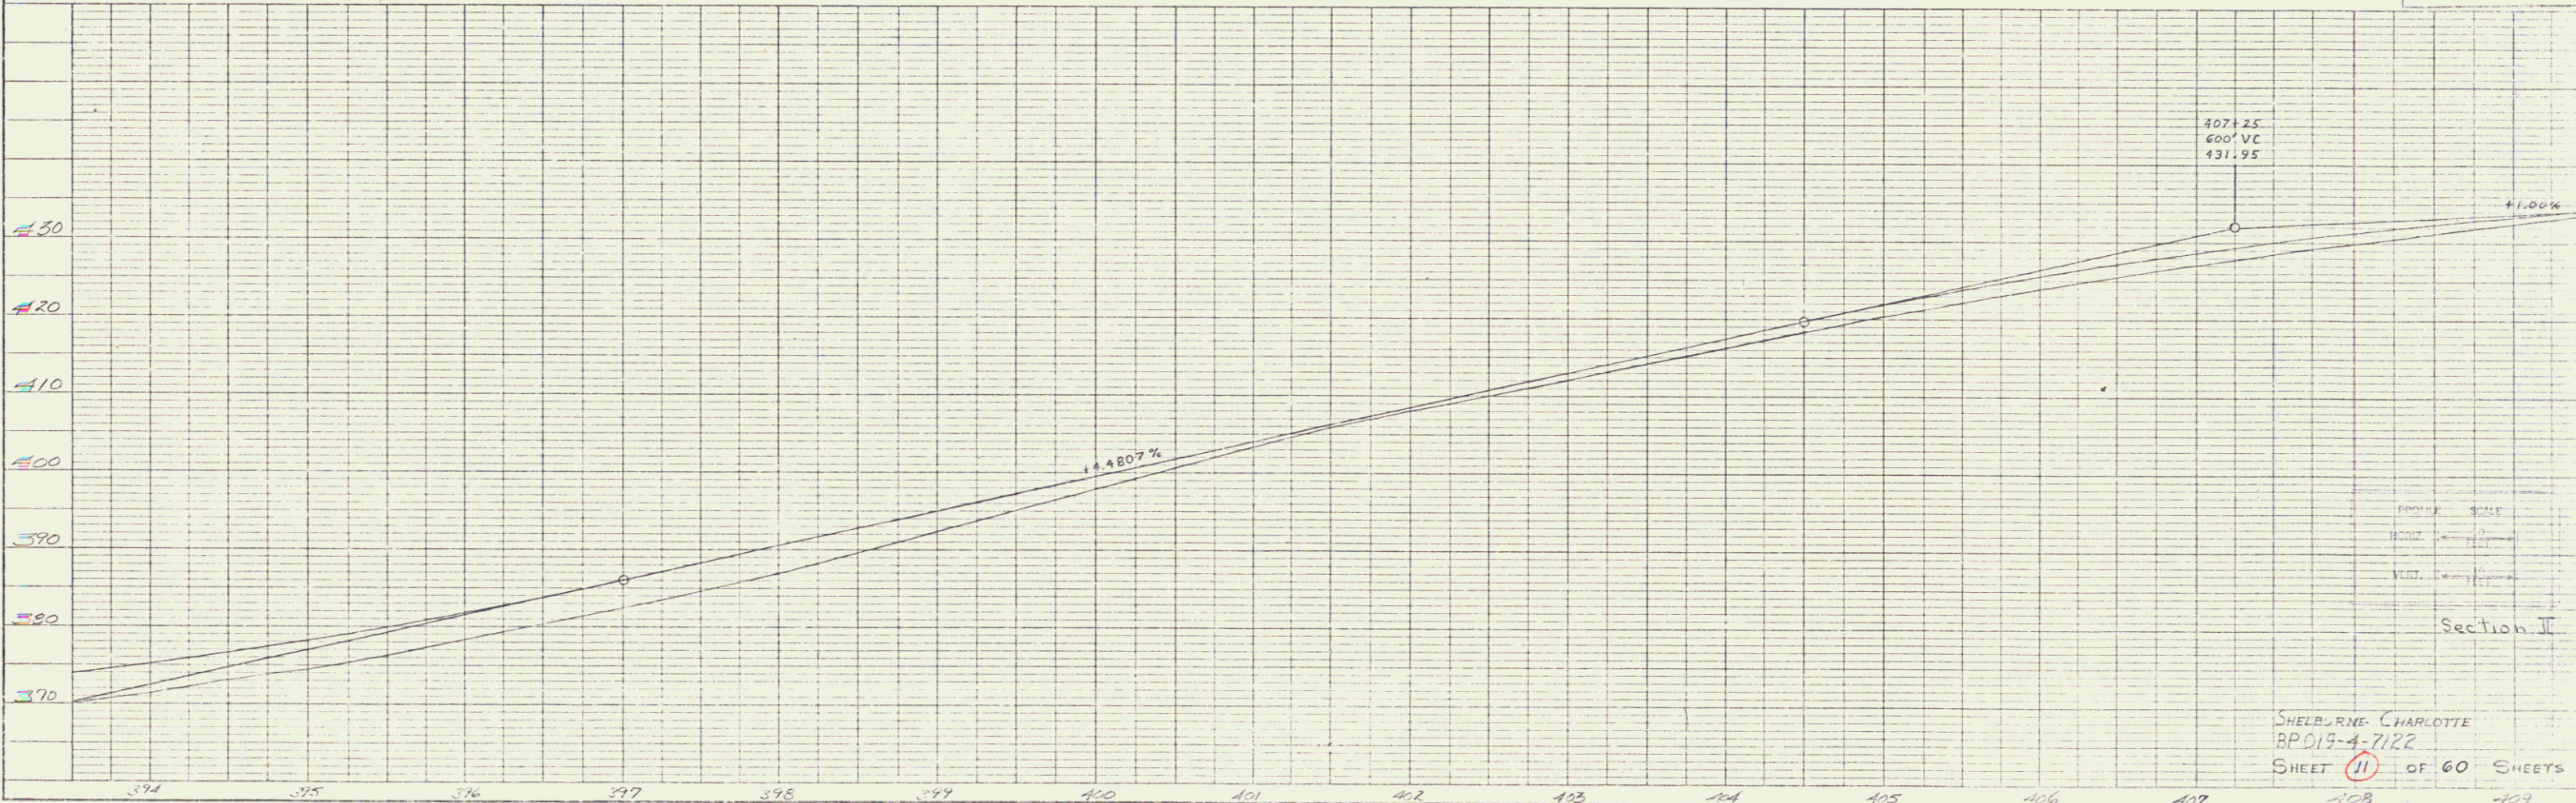


SHEET NO. 11
 DATE
 BY
 CHECKED
 APPROVED
 PROJECT NO. 19-4-7122
 SHEET NO. 11 OF 60 SHEETS

PROFILE
 DATE
 BY
 CHECKED
 APPROVED
 PROJECT NO. 19-4-7122
 SHEET NO. 11 OF 60 SHEETS

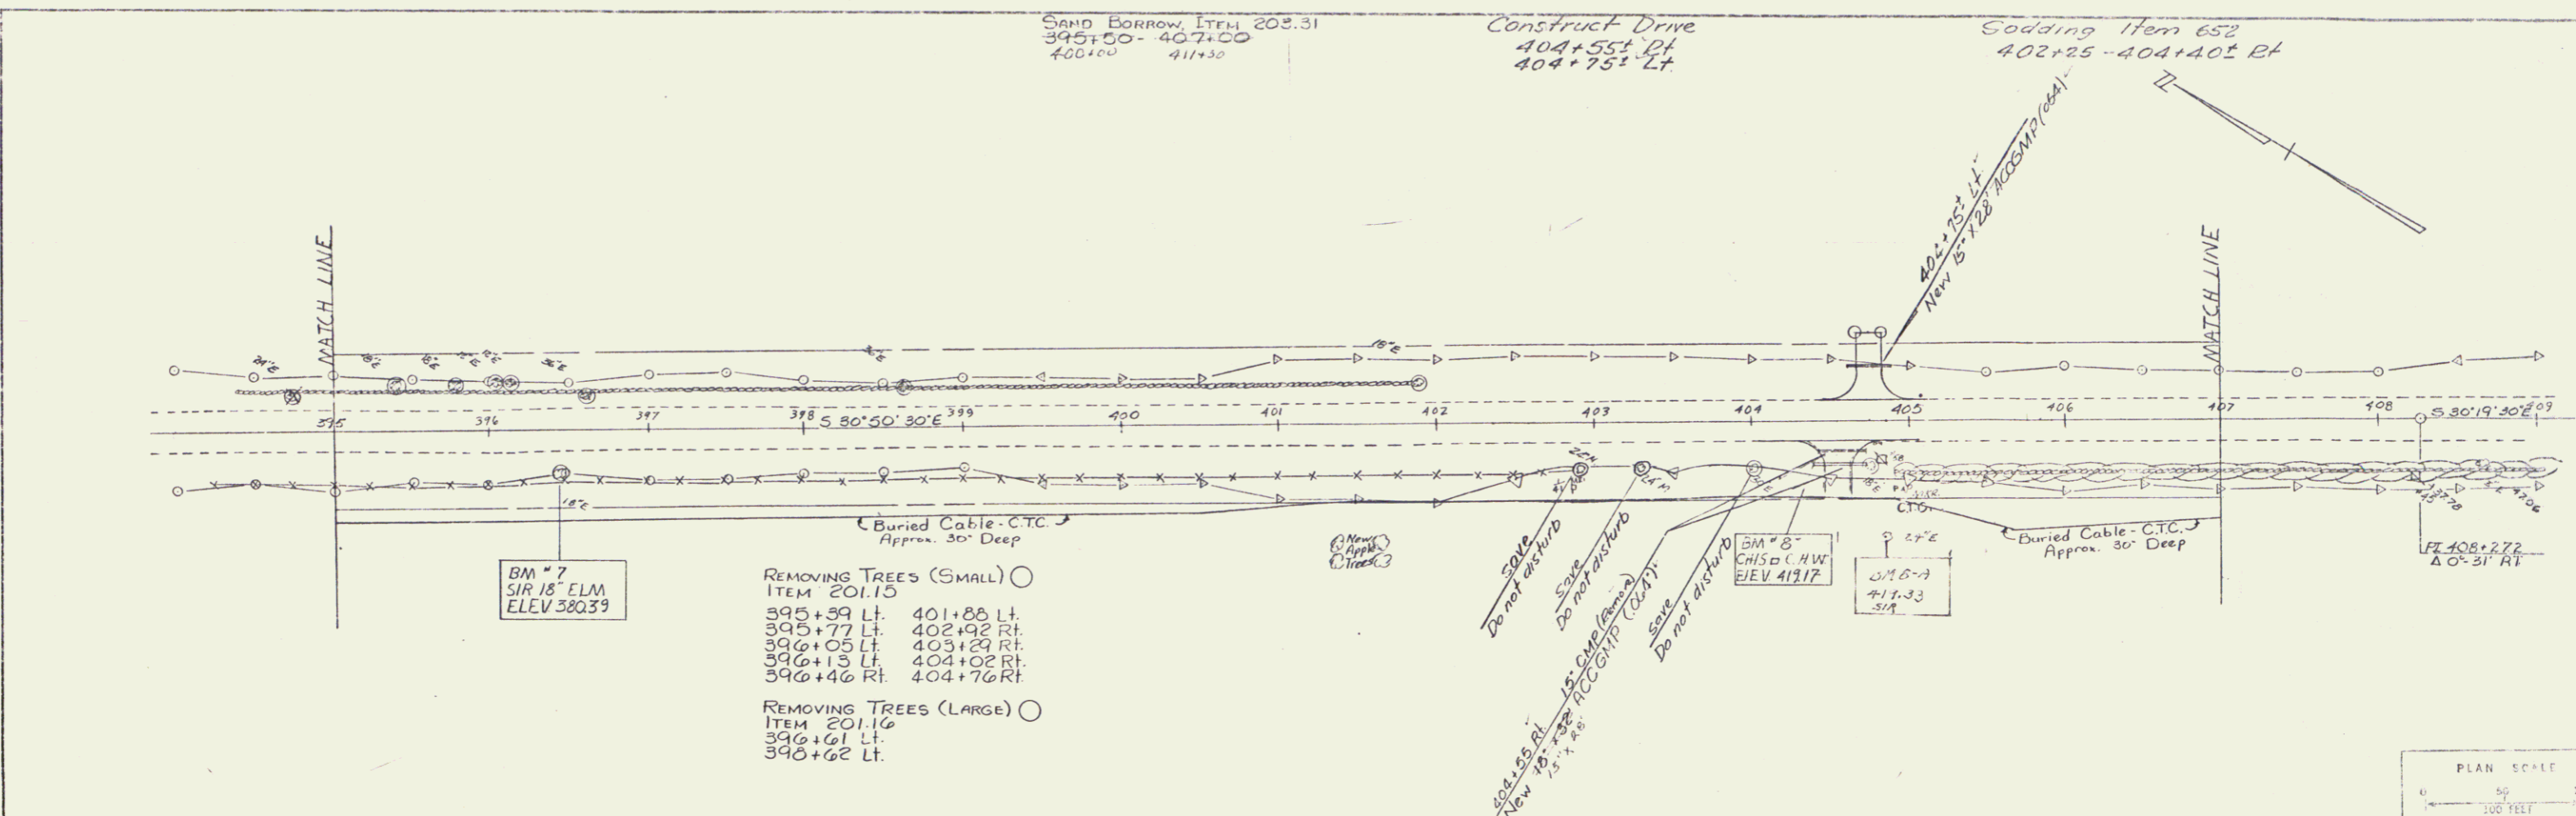

RE
 45700 PHOENIX

7