

INDEX OF SHEETS


SHEET NO.	TITLE PAGE	STATIONING
2	TYPICAL CROSS-SECTION OF IMPROVEMENT	516.0 and 516.11
3	PLAN AND PROFILE	213.00 TO 227.00
4	"	227.00 " 243.00
5	"	243.00 " 259.00
6	"	259.00 " 275.00
7	"	275.00 " 291.00
8	"	291.00 " 306.00
9	"	306.00 " 322.00
10	"	322.00 " 338.00
11	"	338.00 " 354.00
12	"	354.00 " 370.00
13	"	370.00 " 402.00
14	"	402.00 " 418.00
15	"	418.00 " 434.00
16	"	434.00 " 449.00
17	"	449.00 " 464.00
18	"	464.00 " END OF PROJECT
19	"	"
20 TO 21	"	"
21 A	BRIDGE	STA. 222+00 TO 222+05
22-34	CROSS-SECTIONS	72A-1
34-43	CROSS-SECTIONS	72A-2

STATE OF VERMONT
STATE HIGHWAY DEPARTMENT


PLAN AND PROFILE OF PROPOSED
STATE HIGHWAY
FEDERAL AID PROJECT

TOWNS OF SHELBURNE-CHARLOTTE
BURLINGTON-VERGENNES ROAD *Pin # 99R435*
EXTENDING SOUTH FIVE MILES FROM F. A. P. NO. 15
TO THE TOP OF MUTTON HILL

FED. AID DIST. NO.	STATE	FED. AID PROJ. NO.	PLAN	SHEET NO.	TOTAL SHEETS
9	Vt	72A	2534	1	1

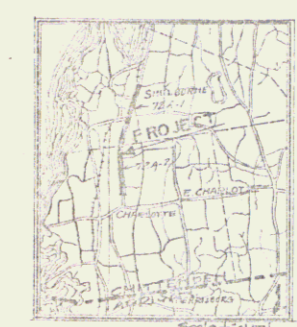

SCALE: PLAN 1 IN. = 50 FT.
PROFILE HORIZ. 1 IN. = 50 FT.
VERT. 1" = 10"
GROSS SECTION 1" = 5"

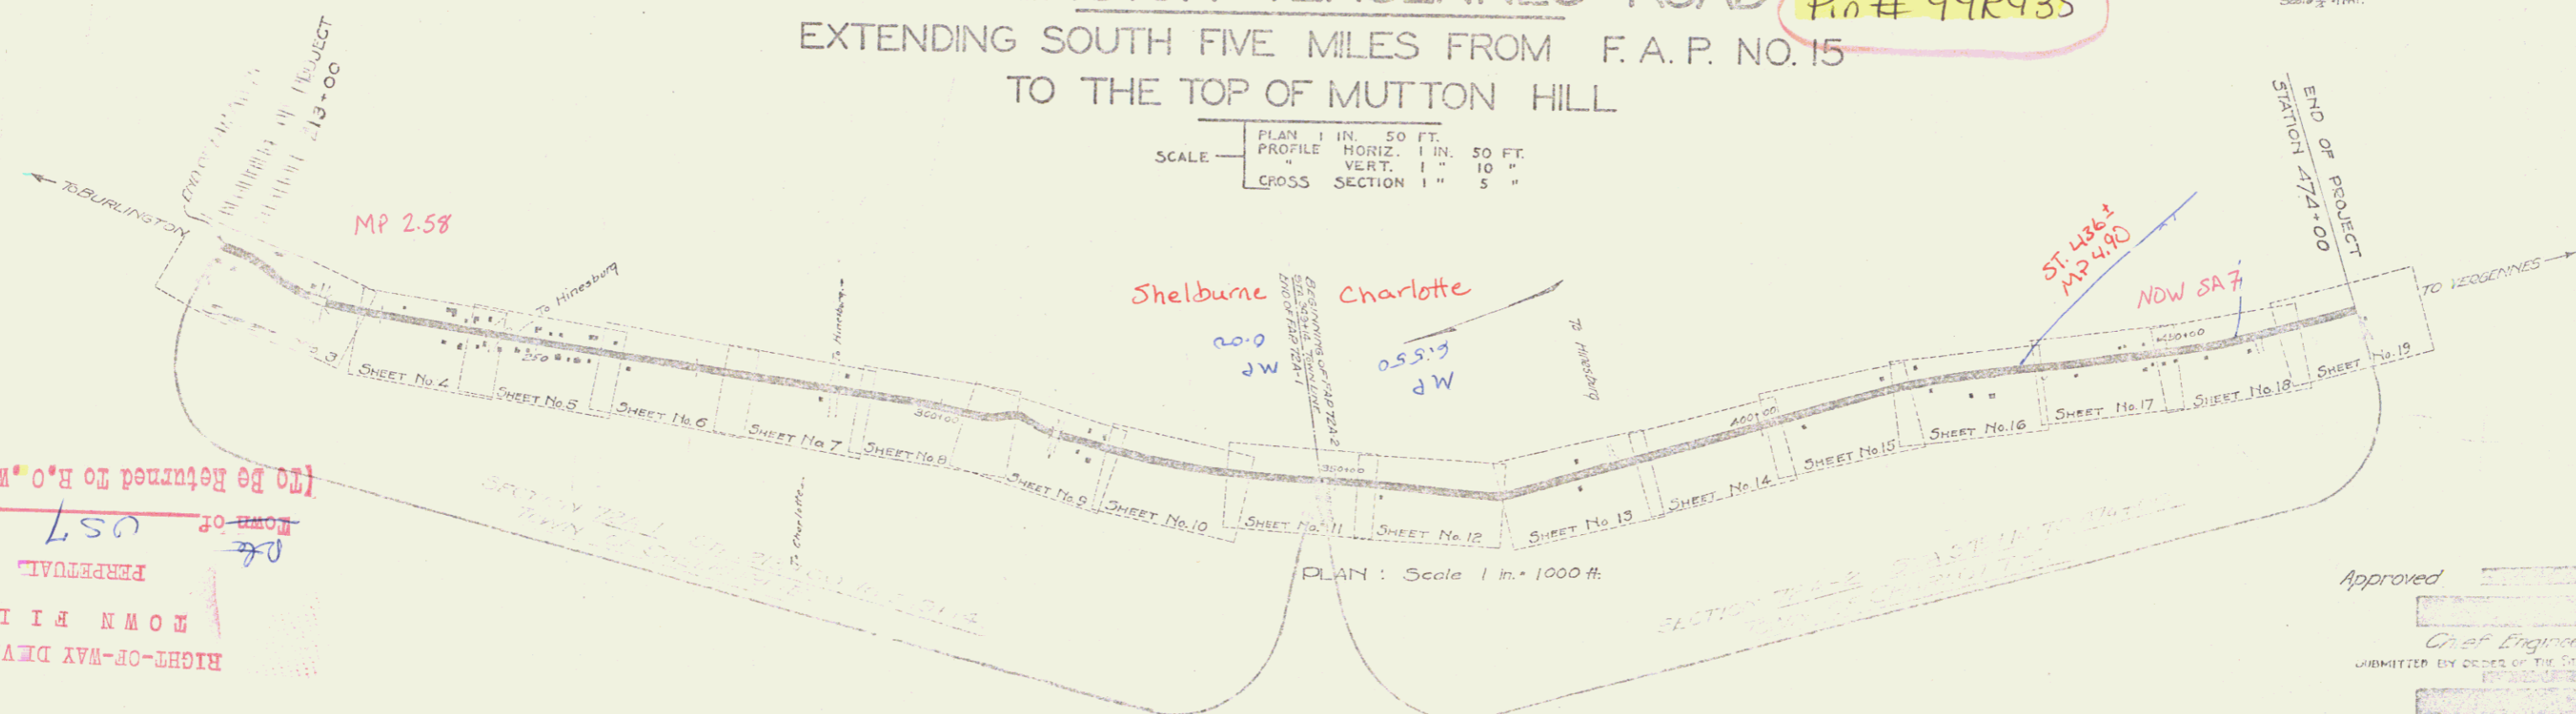

(To Be Returned to H.O.W. Division)
 WORK OF
 US7
 PERMANENT
 OWN FILE
 RIGHT-OF-WAY DIVISION

CONVENTIONAL SIGNS

Symbol	Description
[Symbol]	COUNTY LINE
[Symbol]	TOWN LINE
[Symbol]	FENCE LINE
[Symbol]	STONE WALL
[Symbol]	UNFENCED PROPERTY
[Symbol]	GUARD RAIL
[Symbol]	TRAVELED WAY
[Symbol]	RAILROAD
[Symbol]	RETAINING WALL
[Symbol]	CENTER LINE
[Symbol]	SURVEY LINE

Symbol	Description
[Symbol]	GROUND ELEVATION
[Symbol]	GRADE ELEVATION

Symbol	Description
[Symbol]	CURVE DATA
[Symbol]	DEFLECTION ANGLE Δ
[Symbol]	DEGREE OF CURVE D.
[Symbol]	RADIUS OF CURVE R.
[Symbol]	TANGENT DISTANCE T.
[Symbol]	LENGTH OF CURVE L.
[Symbol]	EXTERNAL DISTANCE E.
[Symbol]	POINT OF INTERSECTION P.I.
[Symbol]	POINT OF CURVE P.C.
[Symbol]	POINT OF TANGENT P.T.

Approved: _____
 Chief Engineer
 SUBMITTED BY ORDER OF THE STATE HIGHWAY BOARD
 Commissioner of Highways

Rte U.S. 7

RECOMMENDED: _____
 DISTRICT ENGINEER
 BUREAU OF PUBLIC ROADS
 RECOMMENDED FOR APPROVAL: _____
 CHIEF ENGINEER - PUBLIC ROADS
 APPROVED: _____
 DISTRICT ENGINEER - BUREAU OF PUBLIC ROADS

1/1/24

project No: F 72A

SHEET 1 OF 1
 DIST. # 5 PLANS