

9" SUB-BASE
Sta. 416+00 to 418+00 Length 200'

DATE	12-22-15	BY	43
------	----------	----	----


CHARLES BYINGTON



Note: Ditch on both sides of road
Sta. 409+00 - 415+00 as shown on
Cross Sections

Curve No. 19
Sta. 408+00
R. 0'-36" Right

B. L. BYINGTON

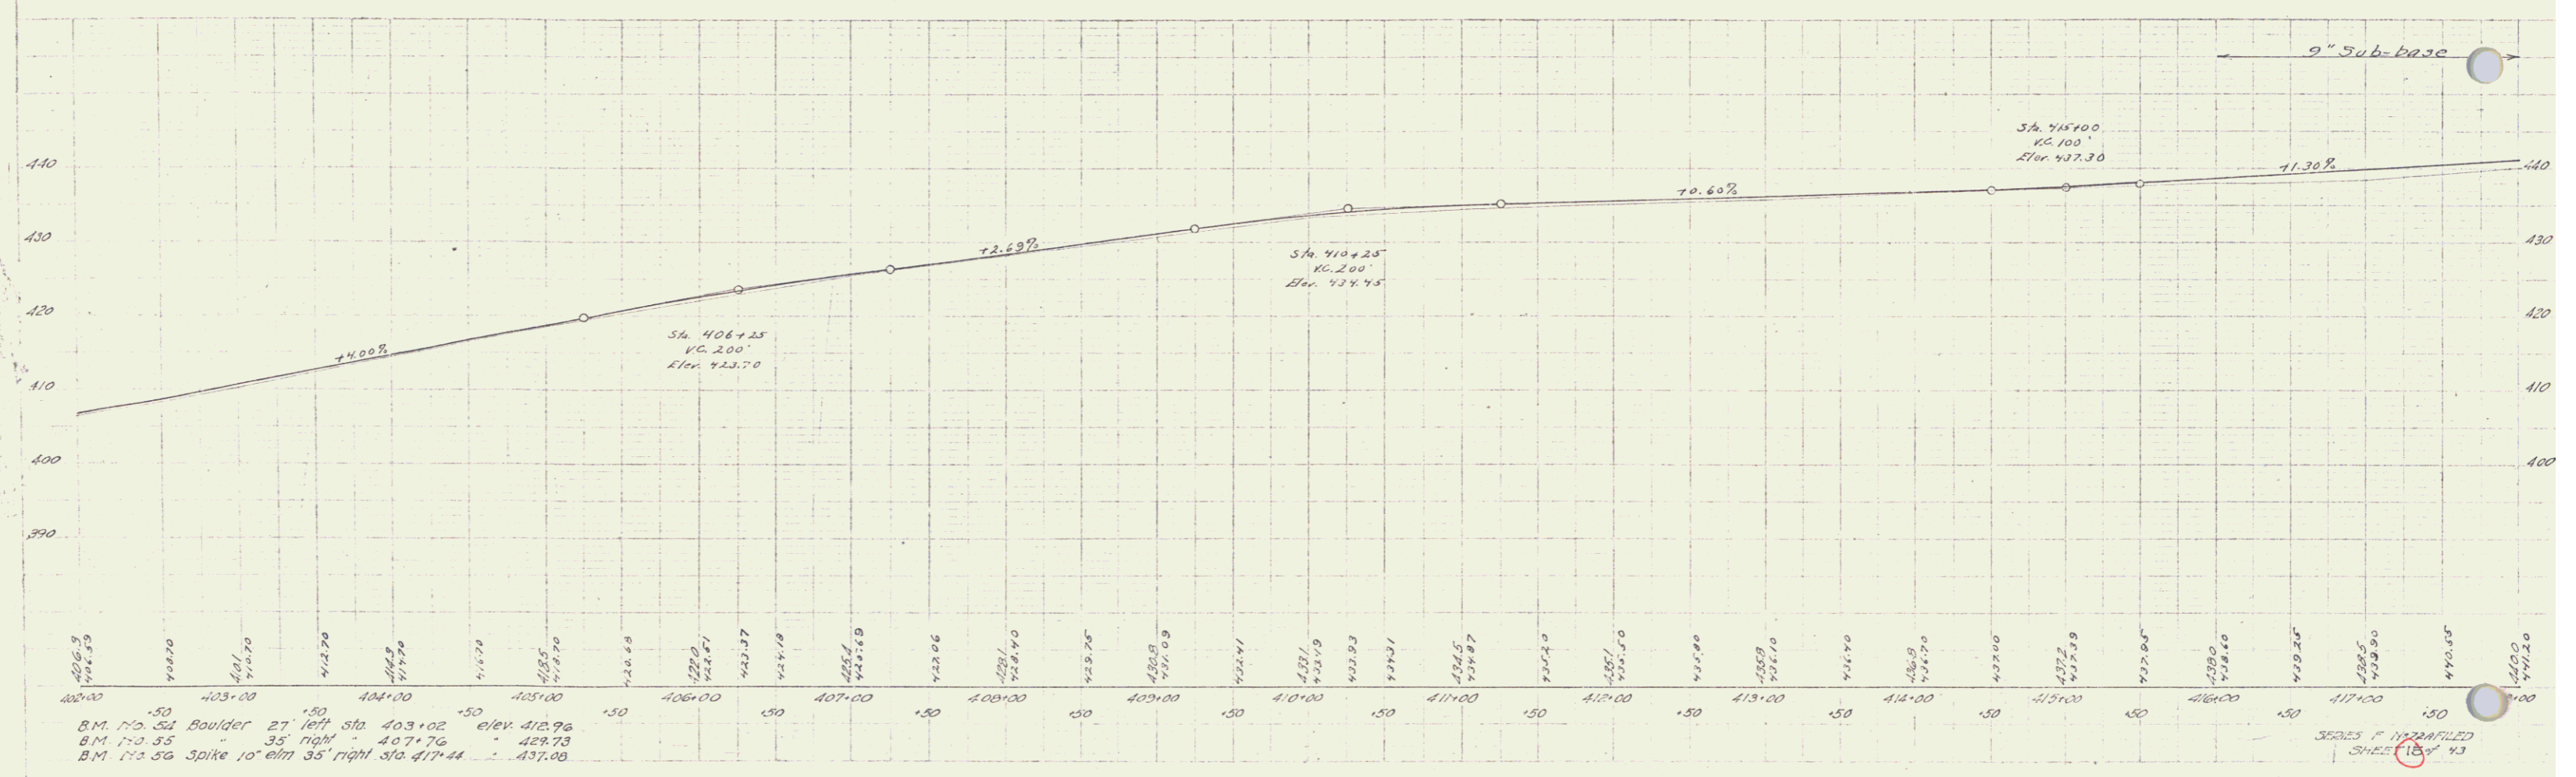

B.M. 120.51 Boulder 27' left Sta. 403+02 Elev. 412.98
B.M. 120.55 " 35' right " 407+76 " 429.73
B.M. 122.56 Spike 10' elm 35' right Sta. 417+44 " 437.00

SEALS IF NECESSARY
SHEET 18 OF 43