


9" SUB-BASE
Sta. 452+00 to 454+00 Length 200'

RECORD BOOK NO. 1000
DATE 11-16-43



Curve No. 21
Δ = 97.45' Min.
D = 27.0
T = 194.3
L = 388.2
E = 6.6
A = 206.5

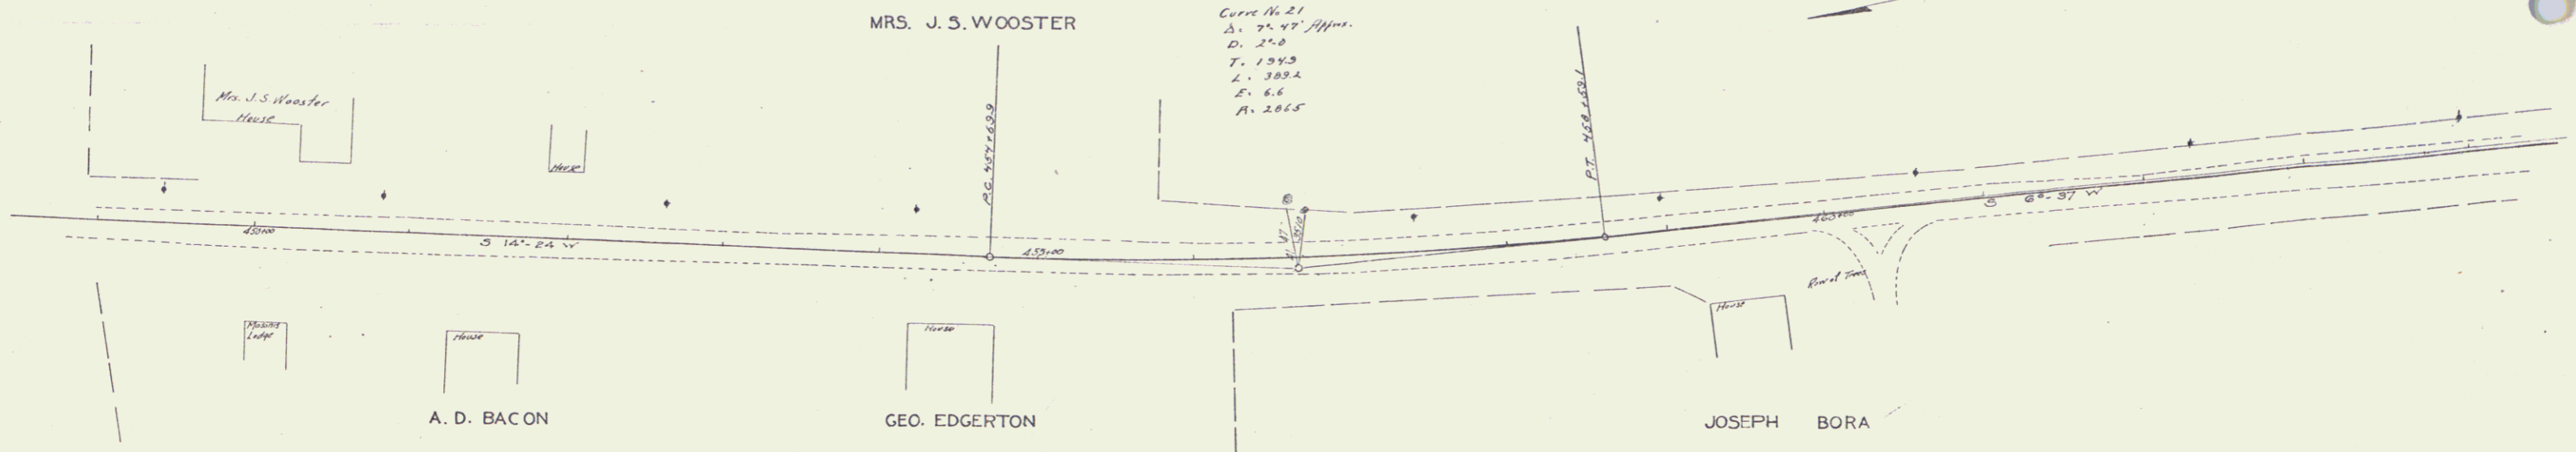