

INDEX OF SHEETS

SHEET NO	TITLE PAGE
2	TYPICAL CROSS-SECTION OF IMPROVEMENT
3	PLAN AND PROFILE STA. 0+00 TO STA. 16+00
4	16+00 - 32+00
5	32+00 - 48+00
6	48+00 - 64+00
7	64+00 - 80+00
8	80+00 - 96+00
9	96+00 - 112+00
10	112+00 - 128+00
11	128+00 - 144+00
12	144+00 - 159+00
13	159+00 - 173+00
14	173+00 - 189+00
15	189+00 - 204+00
16	204+00 - 213+00
17-29	CROSS-SECTIONS

STATE OF VERMONT
STATE HIGHWAY DEPARTMENT

PLAN AND PROFILE OF PROPOSED
STATE HIGHWAY
FEDERAL AID PROJECT

TOWNS OF SO. BURLINGTON AND SHELburnE

SHELburnE ROAD

Pin # 99R436

FROM BURLINGTON-SO. BURLINGTON LINE SOUTHERLY 21300 FEET.


FED. ROAD DIST. NO.	STATE	FED. AID PROJ. NO.	FISCAL YEAR	SHEET NO.	TOTAL SHEETS
3	VT.	13	1919	7	29

(To Be Returned To R.O.W. Division)

FORM OF 057
PERPETUAL

RIGHT-OF-WAY DIVISION
NOISIAI AVI

SCALES PLAN 1"=1000'
PROFILE 1"=400' VERT. 1"=100'
CROSS-SECTIONS 1"=20'

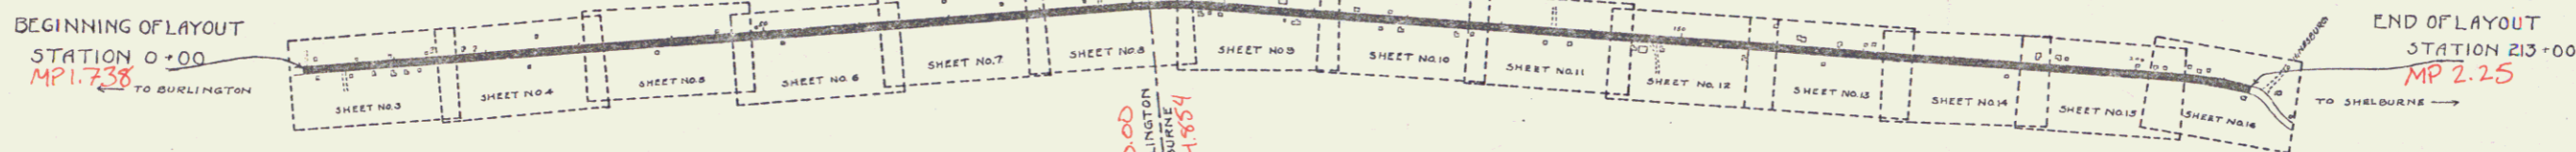

LAYOUT
SCALE 1"=1000 FT.

CONVENTIONAL SIGNS

COUNTY LINE	-----	GROUND ELEVATION	-----
TOWN LINE	-----	GRADE ELEVATION	-----
FENCE LINE	-----		
STONE WALL	-----		
UNFENCED PROPERTY	-----		
GUARD RAIL	-----		
TRAVELED WAY	-----		
RAILROAD	-----		
RETAINING WALL	-----		
BASE OR SURVEY LINE	-----		
CULVERT	-----		
DROP INLET	-----		
TROLLEY POLE	-----		
POWER POLE	-----		
TELEPHONE POLE	-----		
TREES	-----		
HEDGE	-----		

CURVE DATA

DEFLECTION ANGLE	Δ
DEGREE OF CURVE	D.
RADIUS OF CURVE	R.
TANGENT DISTANCE	T.
LENGTH OF CURVE	L.
EXTERNAL DISTANCE	E.
POINT OF INTERSECTION	P. I.
POINT OF CURVE	P. C.
POINT OF TANGENT	P. T.

RECOMMENDED
STATE ENGINEER
APPROVED
GOVERNOR
SUBMITTED
STATE HIGHWAY COMMISSIONER

RECOMMENDED
DISTRICT ENGINEER
RECOMMENDED FOR APPROVAL
CHIEF ENGINEER - BUREAU OF PUBLIC ROADS
APPROVED
DIRECTOR - BUREAU OF PUBLIC ROADS

Re U.S. 7

Project No. F 15

11119

SERIES P NO. 15 FILED
DATE 11/19/19

DIST. # 5 PLANS