



FED. ROAD DIST. NO.	STATE	FED. AID PROJ. NO.	FINANCIAL YEAR	SHEET NO.	TOTAL SHEETS
9	VT.	17	1978	13	20

H E N R Y R O W L E Y

M I T C H E L L

G E O . W I L L E Y

M . M . F A R R E L L

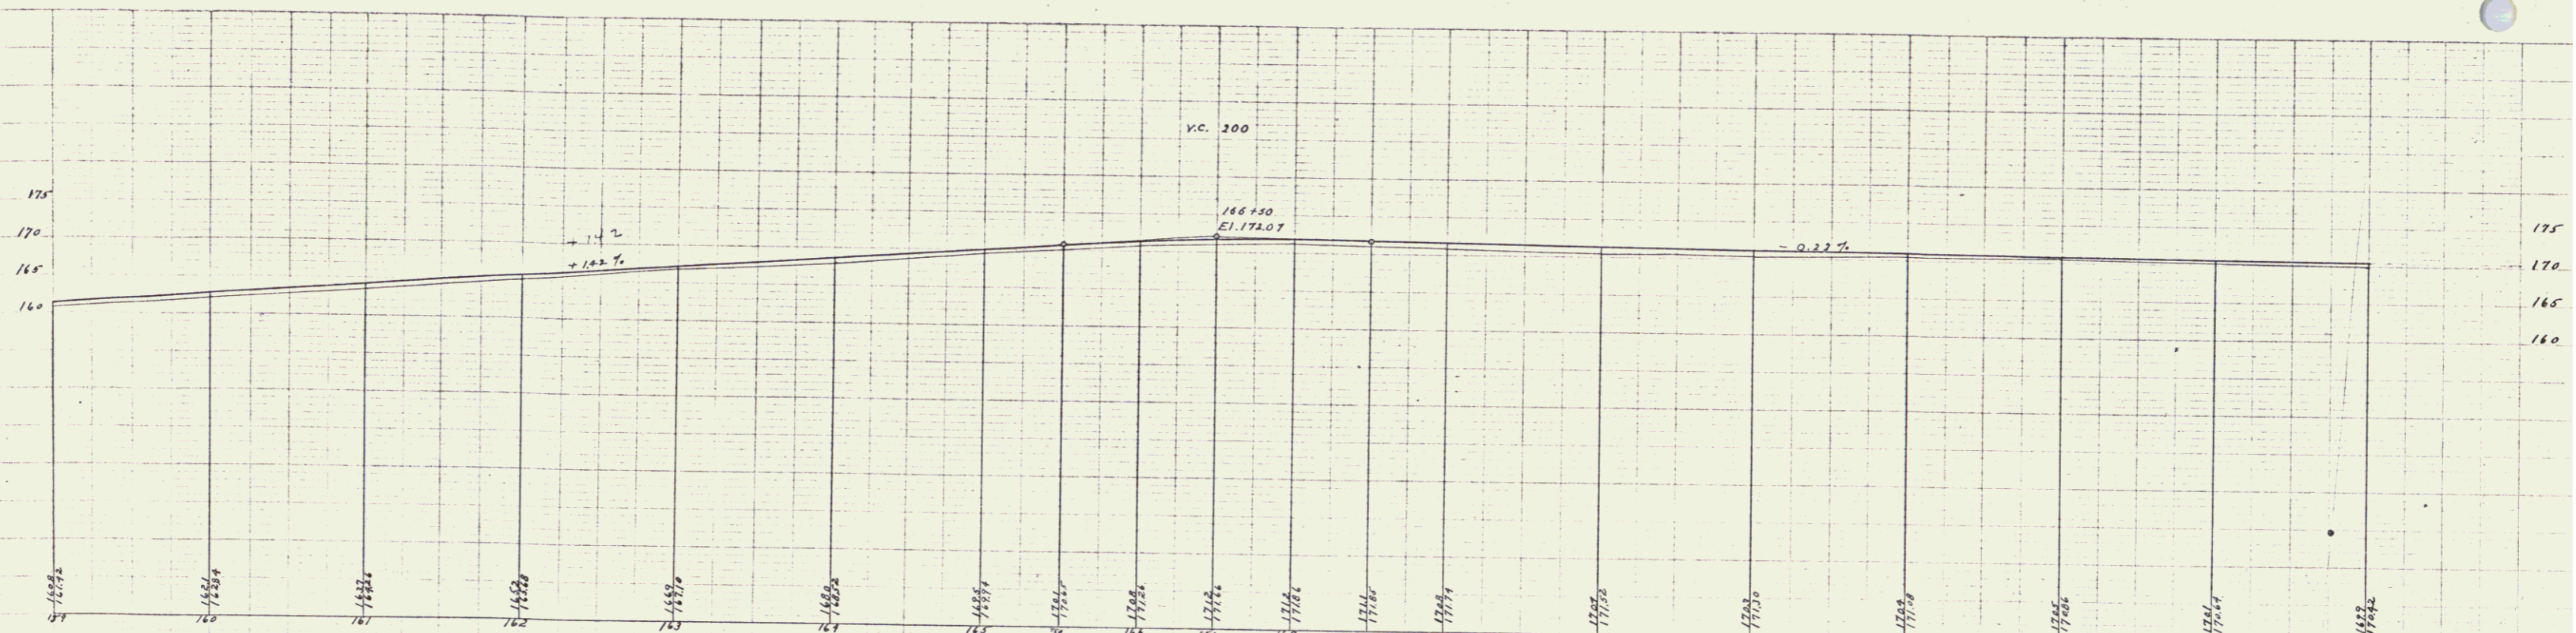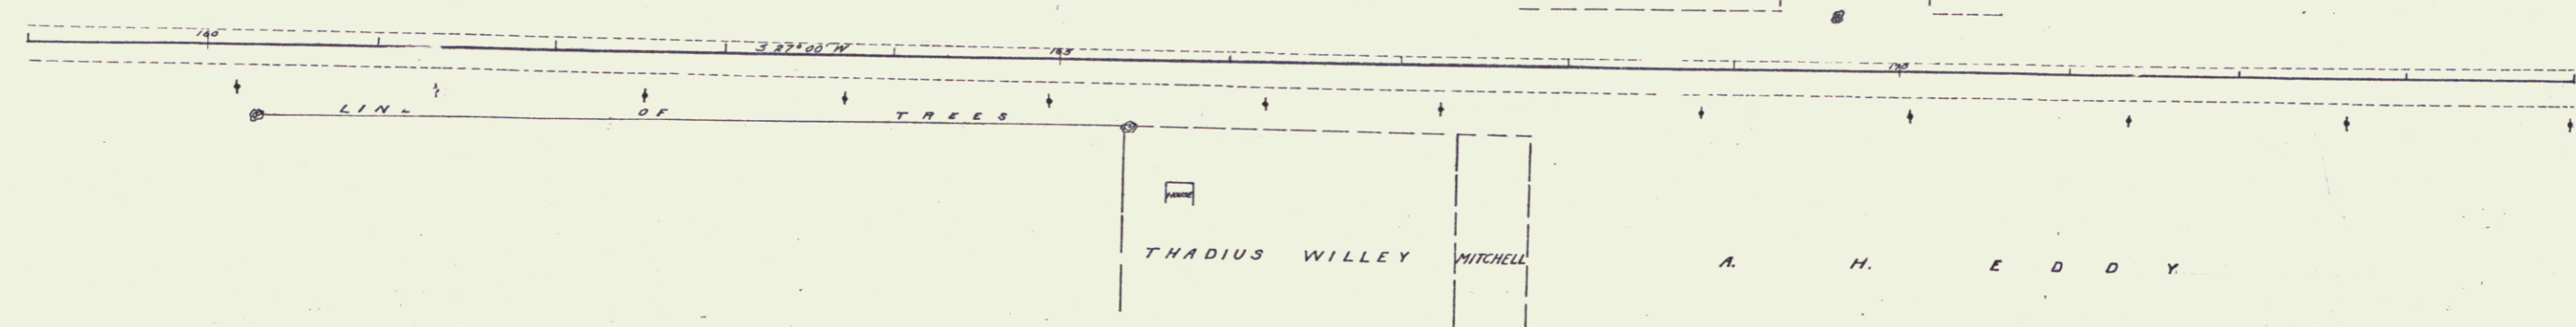

B.M. N.W. corner of threshold of front door, of Rowley house, on East side of road Elev. 172.20  
 B.M. N.W. corner of threshold of Farrell house Elev. 173.00

W.B. Burke  
 State Engineer  
 Vermont  
 State Engineer  
 State Engineer  
 State Engineer

W.B. Burke  
 State Engineer  
 Vermont  
 State Engineer  
 State Engineer  
 State Engineer