

STANDARD STRUCTURE SHEETS APPROVED
BY THE CHIEF ENGINEER, VERMONT STATE
DEPARTMENT OF HIGHWAYS

S-28 APRIL 26, 1941
S-30A APRIL 19, 1941
S-40 DEC. 18, 1945


URBAN PROJECT

U.S. ROUTE 7 Pin# 99R440

VERGENNES-BURLINGTON ROAD

BEGINNING AT A POINT 1.212 MILES SOUTHERLY FROM THE SOUTH BURLINGTON-BURLINGTON CITY LINE AND EXTENDING NORTHERLY 6397.5 FEET.

LENGTH OF PROJECT 6397.5 FEET=1.212 MILES

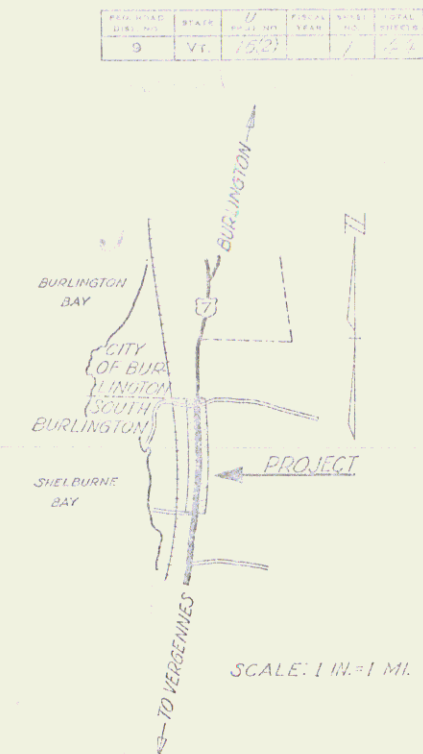

APPROVED: June 11, 1968
H. E. Sargent
COMMISSIONER OF HIGHWAYS

RIGHT-OF-WAY DIVISION
TOWN FILE

PERPETUAL

Project No. 15(2)

(To Be Returned To R.O.W. Division)

RECORD PLANS
SOUTH DURLINGTON U15(2)
PREPARED BY W. SMITH 12/23/49
CONTRACTOR - W. H. HUNMAN INC.
RESIDENT ENGINEER-EDGAR STARKLEY

THESE PLANS ARE SUBJECT TO SUCH REVISIONS AS MAY BE REQUIRED BY THE PUBLIC ROADS ADMINISTRATION FOR THE COMMISSIONER OF HIGHWAYS.

CONSTRUCTION IS TO BE CARRIED OUT IN ACCORDANCE WITH THE PLANS AND THE STANDARD ROAD AND BRIDGE SPECIFICATIONS OF 1931 AS APPROVED DECEMBER 29, 1930 BY THE PUBLIC ROADS ADMINISTRATION, INCLUDING ALL SUBSEQUENT APPROVED REVISIONS AND SUCH REVISED SPECIFICATIONS AND SPECIAL PROVISIONS AS ARE SUBMITTED WITH THE PLANS.

June 10, 1948

U 15(2) 15(2)

STEARNS R. JENKINS

457