

CONSTRUCT DRIVES (LC)

417+30	456+32
420+25	456+92
420+65	457+50
432+05	458+12
434+25	458+39
435+72	461+98

REMOVING AND RESETTING CURBS - ITEM 537


REMOVE STA.	RESET STA.
417+00 - 417+25	417+00 - 417+25
417+35 - 419+31	417+35 - 419+31
443+58 - 449+50	443+58 - 449+50
449+75 - 451+05	449+75 - 451+05
452+01 - 455+02	452+01 - 455+02
455+00 - 456+24	455+00 - 456+24
456+30 - 456+74	456+30 - 456+74
457+09 - 457+38	457+09 - 457+38
457+69 - 457+75	457+69 - 457+75
457+85 - 458+01	457+85 - 458+01
457+23 - 461+93	457+23 - 461+93
462+04 - 463+00	462+04 - 463+00

CHANGING ELEVATIONS OF CATCH BASINS OR MANHOLES - ITEM 533

447+73	450+50
452+01	454+50
457+64	463+72
460+81	469+04
461+10	461+60
461+88	

VERTICAL CURVE DATA ITEM 534

457+00	458+00
458+00	461+00
461+00	463+00
463+00	465+00

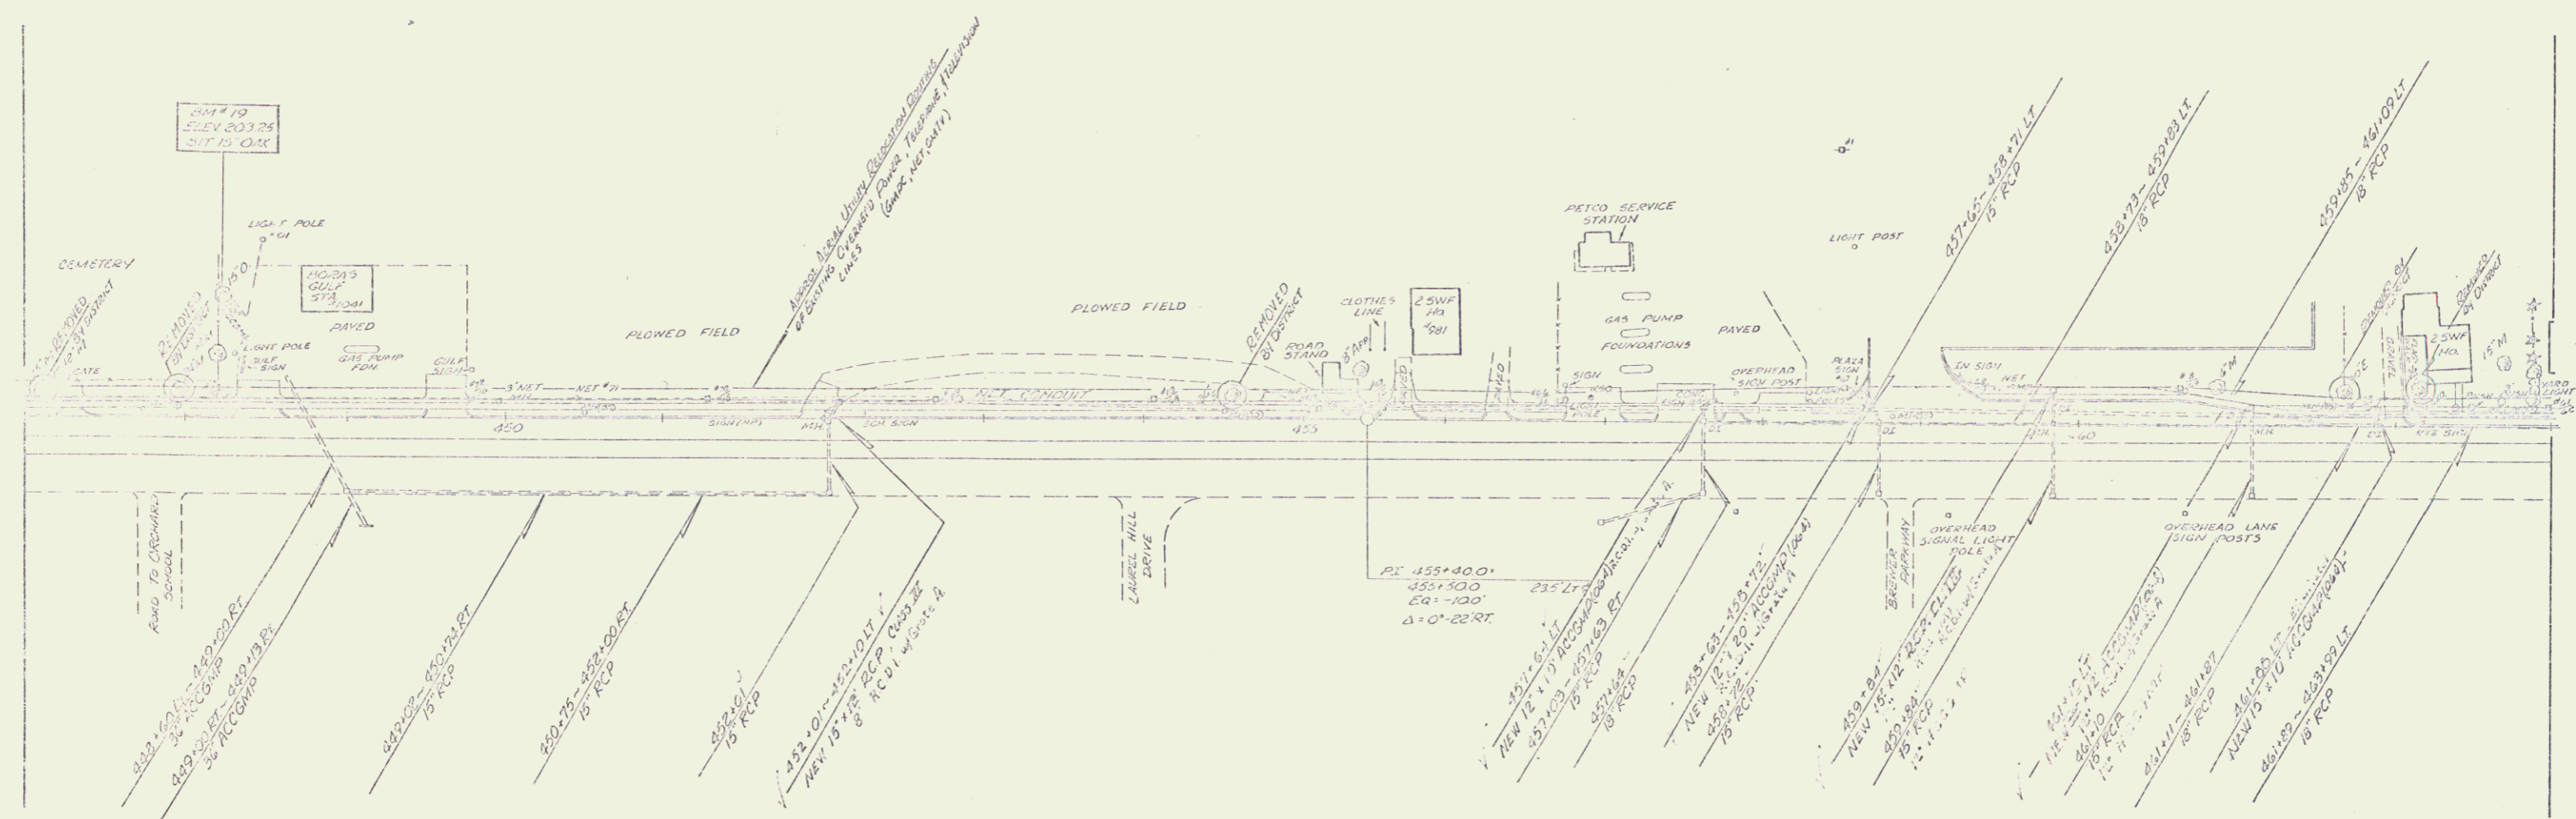

SOUTH BURLINGTON

DESIGNED BY: CAWRIGHT DATE: 1-70
 DRAWN BY: MCARDIA DATE: 2-70
 CHECKED BY: DATE: 1-70
 IN CHARGE: DATE: 1-70

PLAN SCALE
 0 25 50
 1" = 25'

DATE: 1-70
 SHEET: 6 OF 8