

CONSTRUCT DRAIN (11)

463+34 CHANSE
464+33 " "
465+20 " "
466+40 " "

REMOVING AND RESETTNG FENCE - ITEM 507

0+75-1+12 Ramp A Lt

REMOVING AND RESETTNG CURB - ITEM 557

REMOVE STA RESET STA

463+00-463+03 463+00-463+14
463+60-463+62 463+60-463+64
464+26-464+34 464+26-464+36
464+69-464+70 464+69-464+70
465+00-465+02 Ramp A 465+00-465+02
465+00-465+02 Ramp A 465+00-465+02
465+00-465+02 Ramp A 465+00-465+02

VERTICAL GRANITE CURB - ITEM 556-B

0+15-1+20 Ramp A (shown)


464+03-464+05 (18) (shown)

(5) ONE COURSE CEMENT CONCRETE SIDEWALK, ITEM 550


466+00-466+02 Ramp A Lt

467+32-467+32 2h


CHANGING ELEVATIONS AT CURB BASINS
OR MANHOLES, ITEM 533
464+00 " "
464+12 " "
465+97 " "
465+80 " "

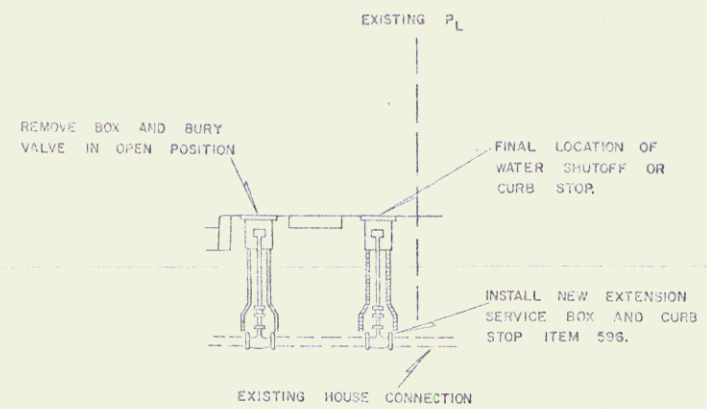

DETAIL FOR ITEM 596 MCD.
EXTENSION SERVICE BOX
AND CURB STOP

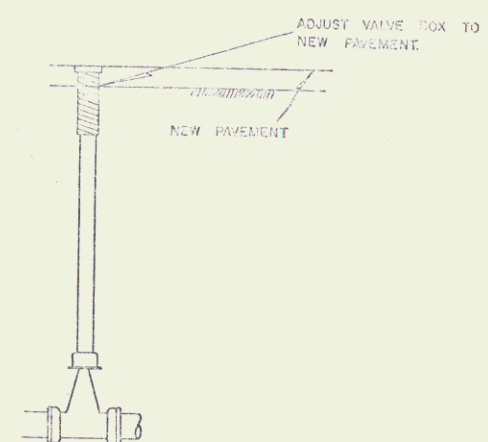

DETAIL FOR ITEM 902
CHANGING ELEVATION OF
WATER GATE VALVE BOXES

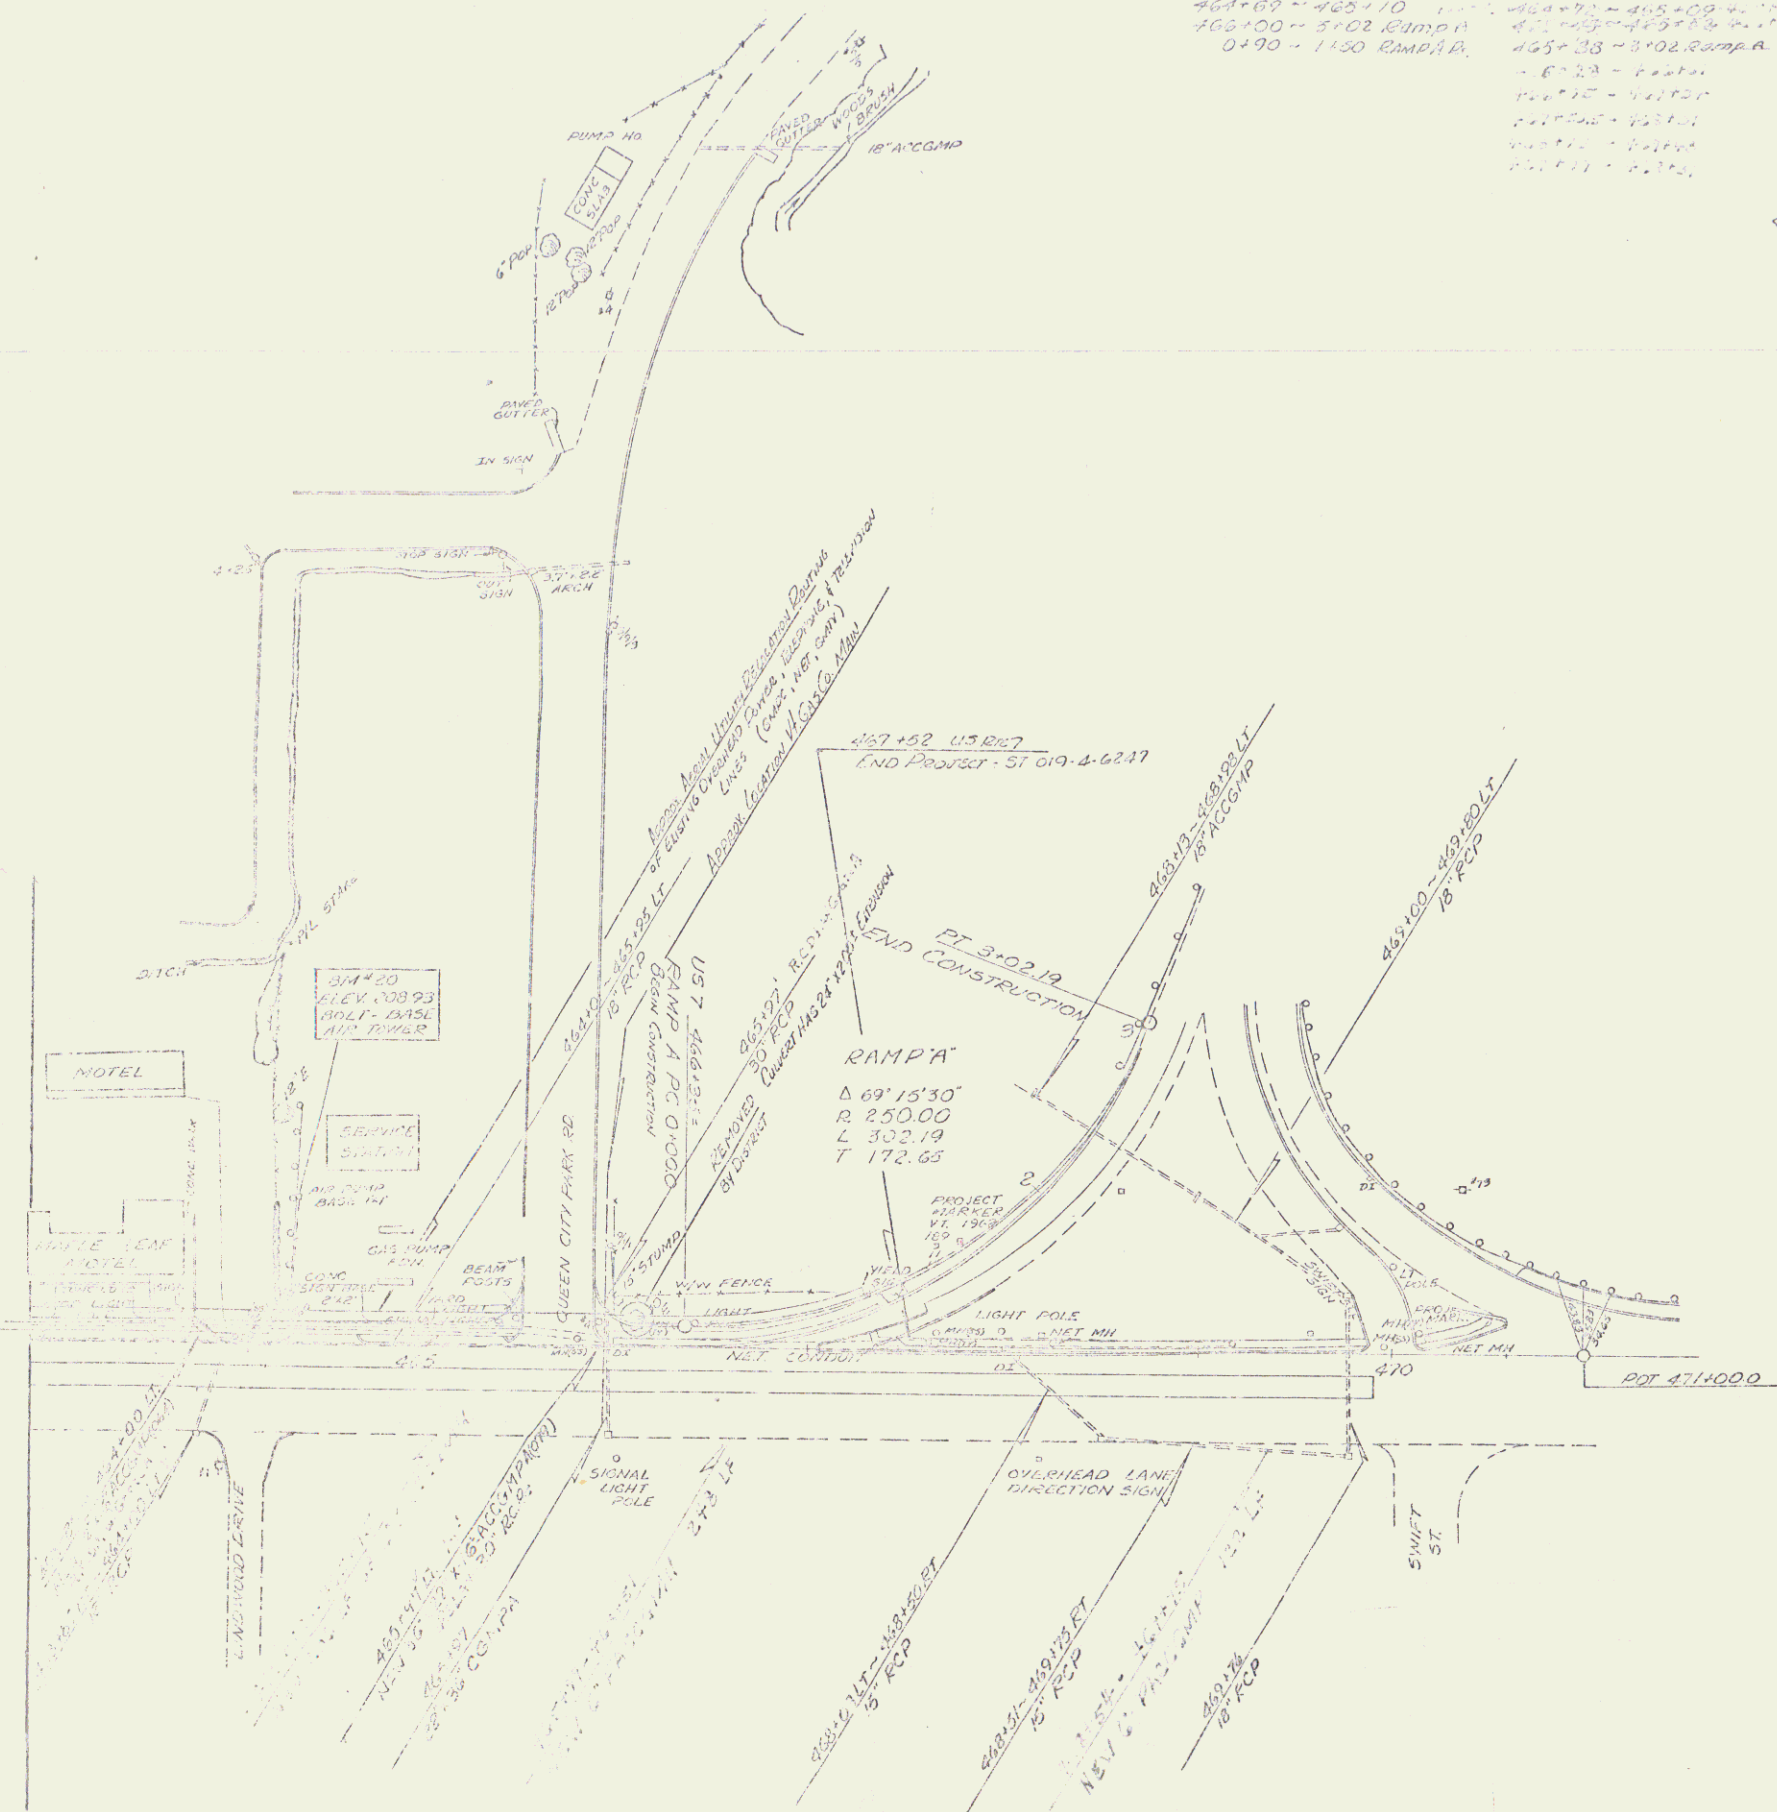

8A
SOUTH BURLINGTON
SURVEYED BY: [blank] DATE: [blank]
DRAWN BY: [blank] DATE: [blank]
CHECKED BY: [blank] DATE: [blank]