

CONSTRUCT DRIVES (LT)



424+86	COMMERCIAL
425+72	" "
427+73	" "
428+58	" "
429+33	" "

REMOVING AND RESETTING CURB, ITEM 507
REMOVE STA (RT)

424+12-424+71	RESET STA (LT)
424+90-425+61	425+12-424+71
425+90-427+54	425+72-424+71
427+60-428+64	427+73-424+71
428+73-429+22	428+58-424+71
429+30-431+00	429+33-424+71

CHANGING ELEVATIONS OF CATCH BASINS
OR MANHOLES, ITEM 533

426+00	Gr
429+00	" "
429+51	" "
429+80	" "

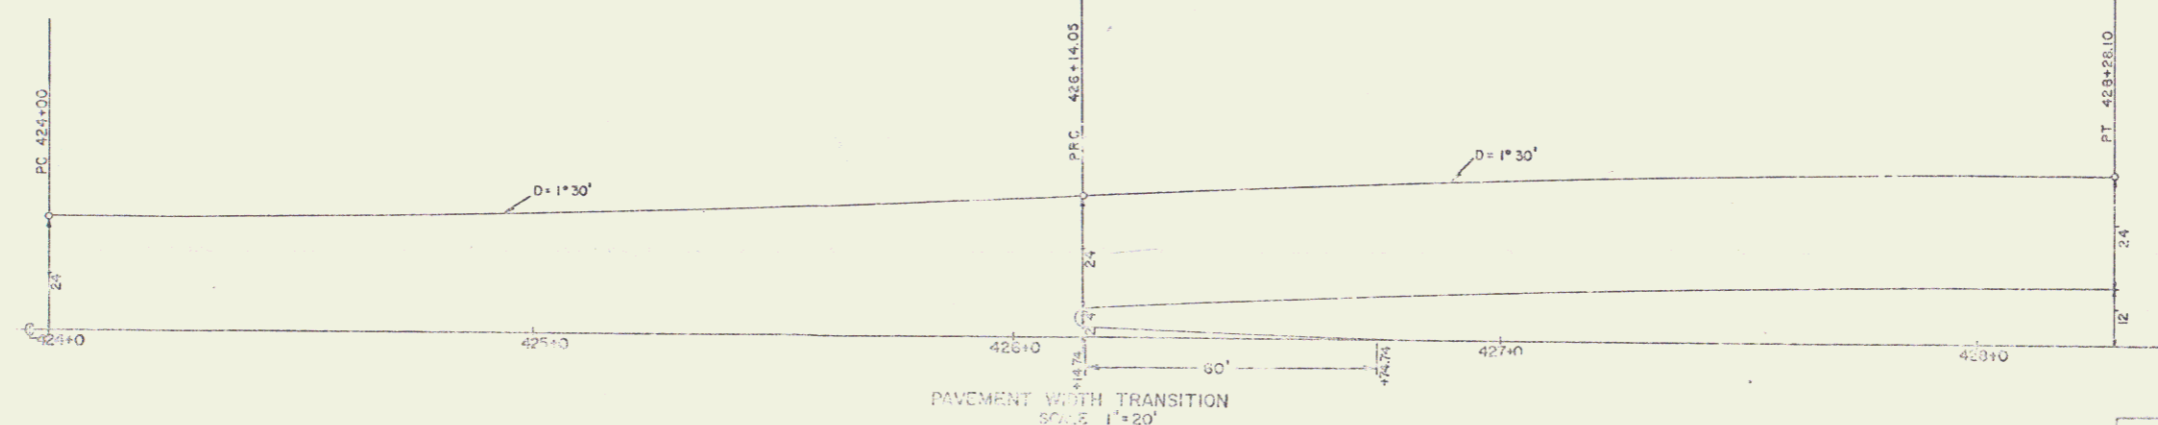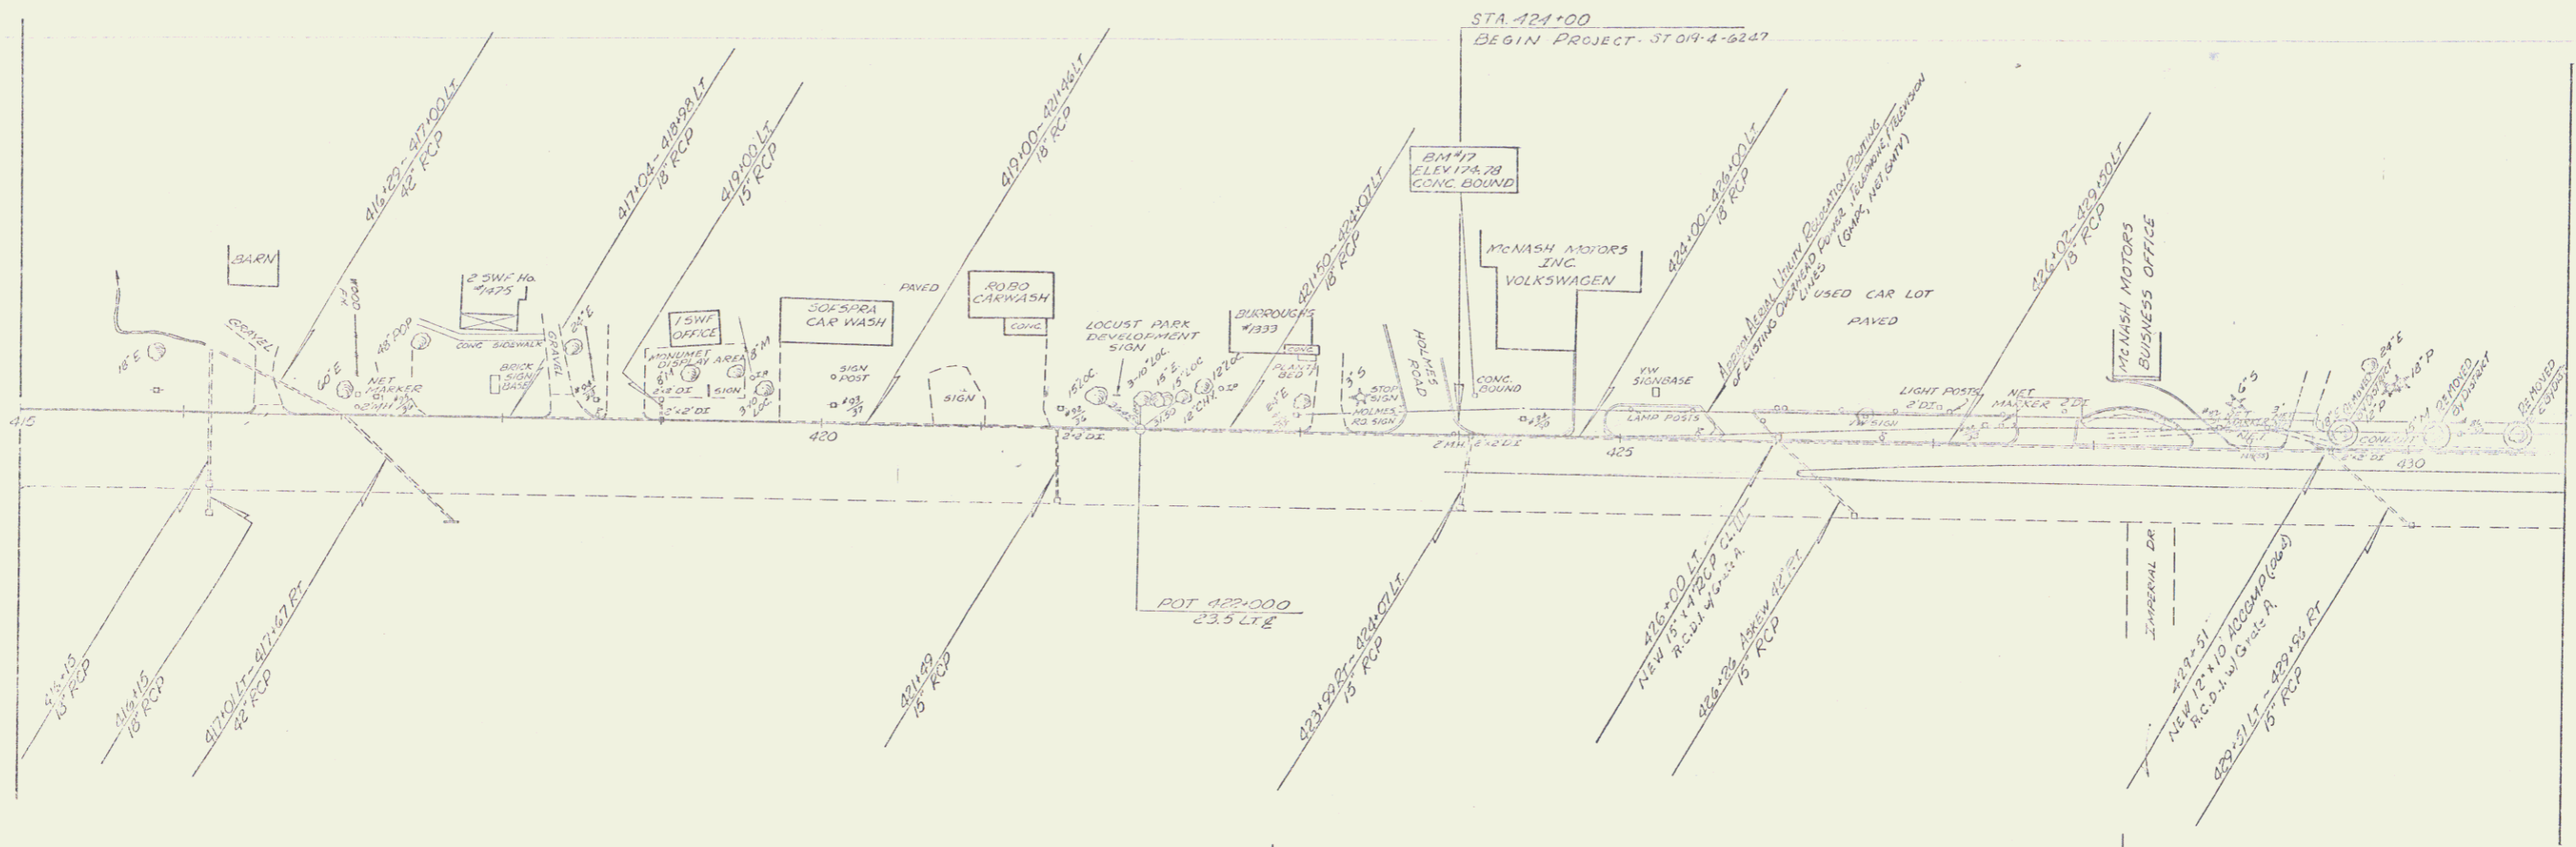

SOUTH BURLINGTON

DESIGNED BY: [Signature]
 CHECKED BY: [Signature]
 DATE: 1/20/00
 TRACT: [Signature]



PLAN SCALE: 1" = 40'

PROJECT NO: 019-4620
 SHEET NO: 35

CONSTRUCT DRIVES (LT)
 432+90 Curb 441+53
 434+55 " 444+65
 438+11 Curb 445+08
 439+00 " 446+15 Curb

REMOVING AND RESETTING CURB, ITEM 557
 REMOVE STA. RESET STA.
 431+00-432+02 431+00-432+77
 433+05-434+04 433+02-434+45
 434+65-435+70 434+67-437+91
 435+73-436+91 436+51-439+72
 437+07-441+28 437+09-441+98
 441+63-444+65 441+63-444+00
 444+73-445+00 445+16-446+07
 446+26-447+00 446+25-447+00

CHANGES ELEVATIONS OF CATCH BASINS
 OR MANHOLES, ITEM 533
 432+00 in.
 432+72 "
 436+17 "
 434+85 "
 437+00 "
 438+43 "
 441+00 "
 444+50 "

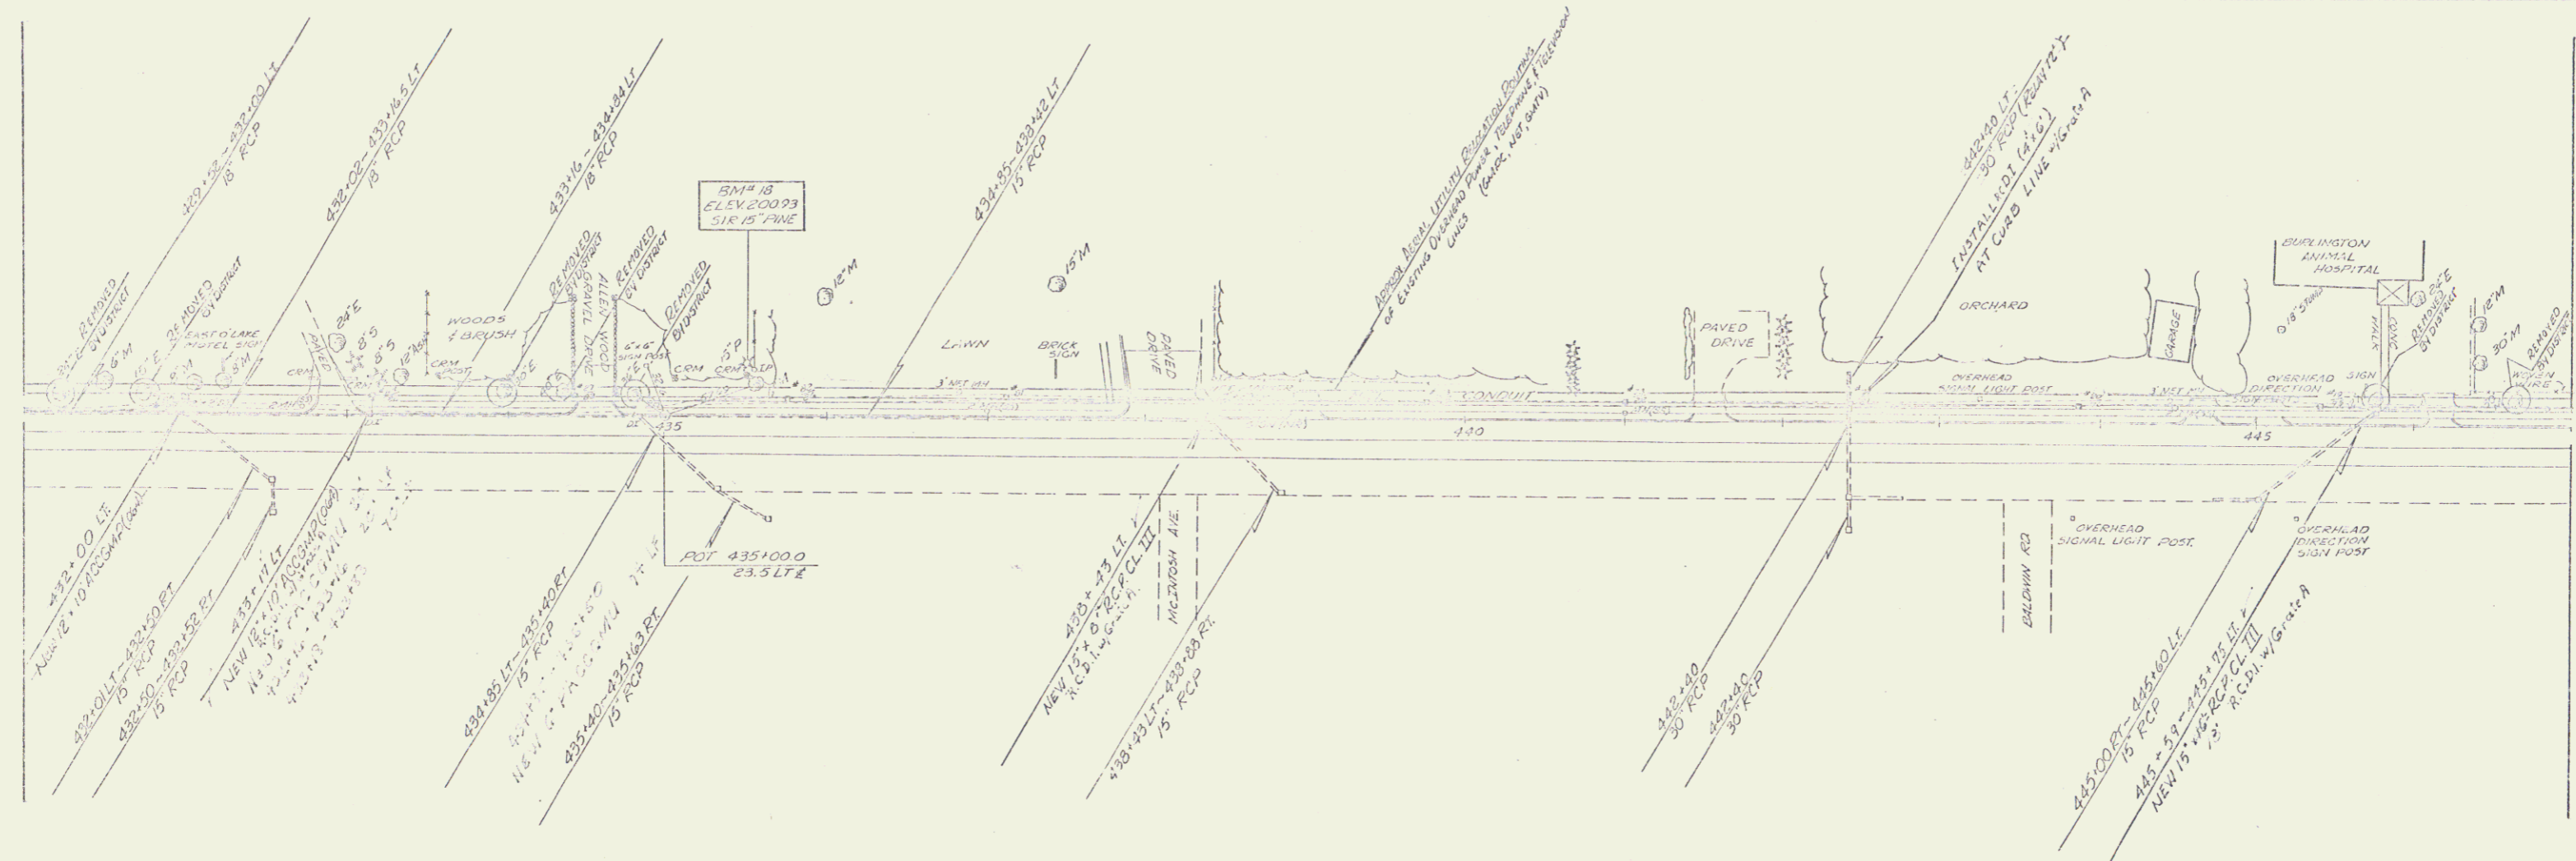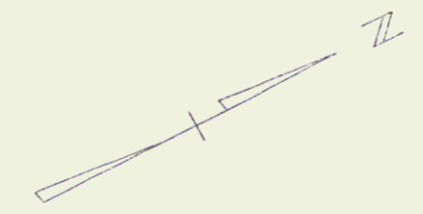

SOUTH BURLINGTON

SURVEYED BY: CAMERON DATE: 1-70
 DRAWN BY: CAMERON DATE: 1-70
 TRACED BY: M. GREGG DATE: 2-70

PLAN SCALE
 1" = 100'

PROJ. OF 113 617-46517
 SHEET 7 OF 85

CONSTRUCT DRIVES (LC)

417+30	456+32
420+25	456+92
420+65	457+50
432+05	458+12
434+25	458+39
435+72	461+98

REMOVING AND RESETTING CURBS - ITEM 537


REMOVE STA.	RESET STA.
417+00 - 417+25	417+00 - 417+25
417+35 - 419+31	417+35 - 419+31
443+58 - 444+50	443+58 - 444+50
449+25 - 451+05	449+25 - 451+05
452+01 - 455+02	452+01 - 455+02
455+00 - 456+24	455+00 - 456+24
456+30 - 456+74	456+30 - 456+74
457+09 - 457+38	457+09 - 457+38
457+69 - 457+75	457+69 - 457+75
457+85 - 458+01	457+85 - 458+01
457+23 - 461+93	457+23 - 461+93
462+04 - 463+00	462+04 - 463+00

CHANGING ELEVATIONS OF CATCH BASINS OR MANHOLES - ITEM 533

447+73	450+50	452+01	454+50	457+64	463+72	466+81	469+04	461+10	461+60	461+88
--------	--------	--------	--------	--------	--------	--------	--------	--------	--------	--------


VERTICAL CURVE DATA - ITEM 534

457+00	458+00
458+00	461+74
462+00	463+77
462+00	463+77

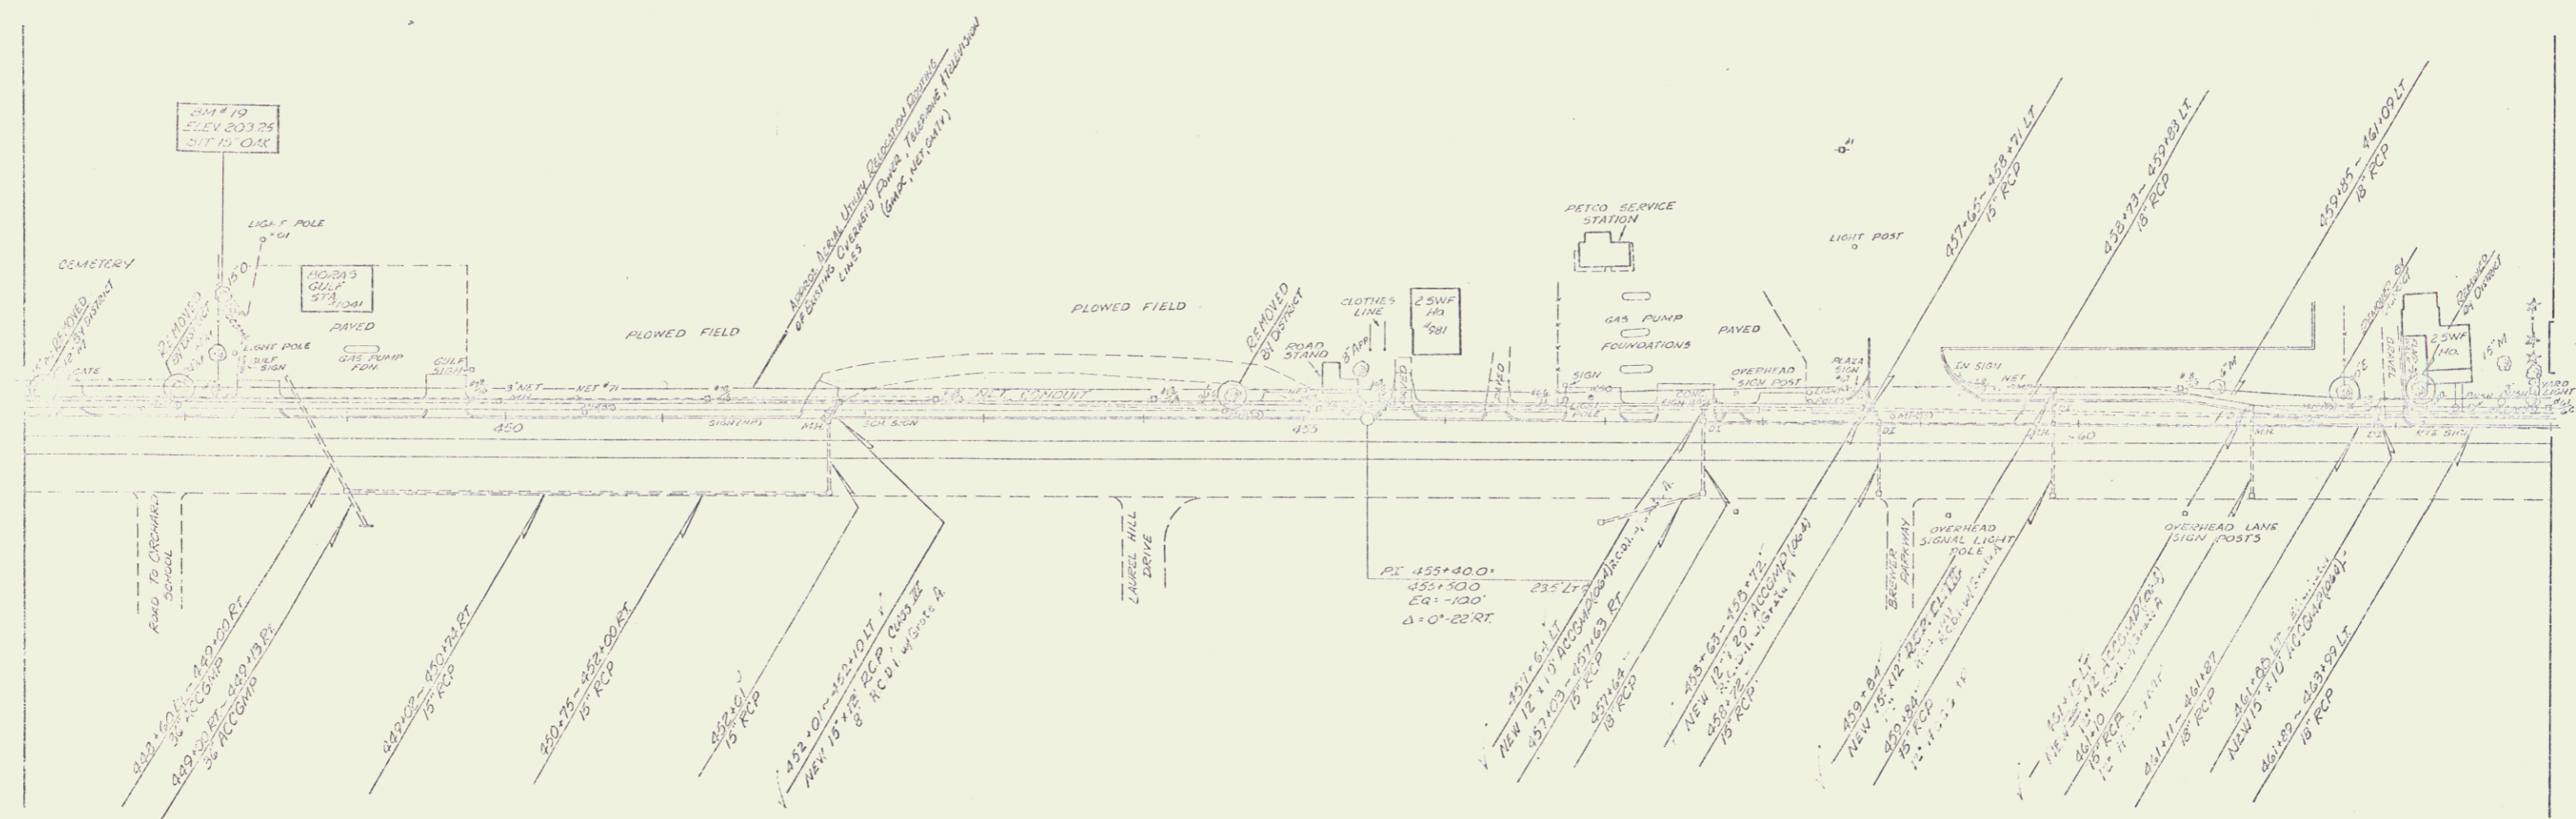

SOUTH BURLINGTON

DRAWN BY	CAWRIGHT	DATE	1-70
TRACED BY	MCARPCIA	DATE	2-70

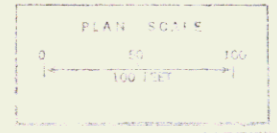

DATE 01-19-68
SHEET 6 OF 57



Construction Details (11)
 463+34 Ditch
 464+00 " "
 465+20 " "
 466+00 " "

REMOVING AND RESETTING FENCE - ITEM 504
 0+75-1+12 Ramp A Lt


REMOVING AND RESETTING CURB - ITEM 557
 REMOVE STA. RESET STA.
 463+00-463+00 463+00-463+14
 463+60-463+62 463+64-463+84
 464+00-464+00 464+00-464+36
 464+60-464+10 464+70-465+00
 465+00-465+02 Ramp A 465+00-465+00
 0+90-1+50 Ramp A 465+38-465+02 Ramp A

VERTICAL GRANITE CURB - ITEM 556-B
 0+75-1+12 Ramp A (shown)
 467+00-467+02 (18) (shown)


(5) ONE COURSE CEMENT CONCRETE SIDEWALK, ITEM 810
 466+00-469 Ramp A Lt.
 467+32-467+02 Lt

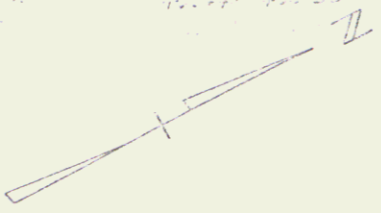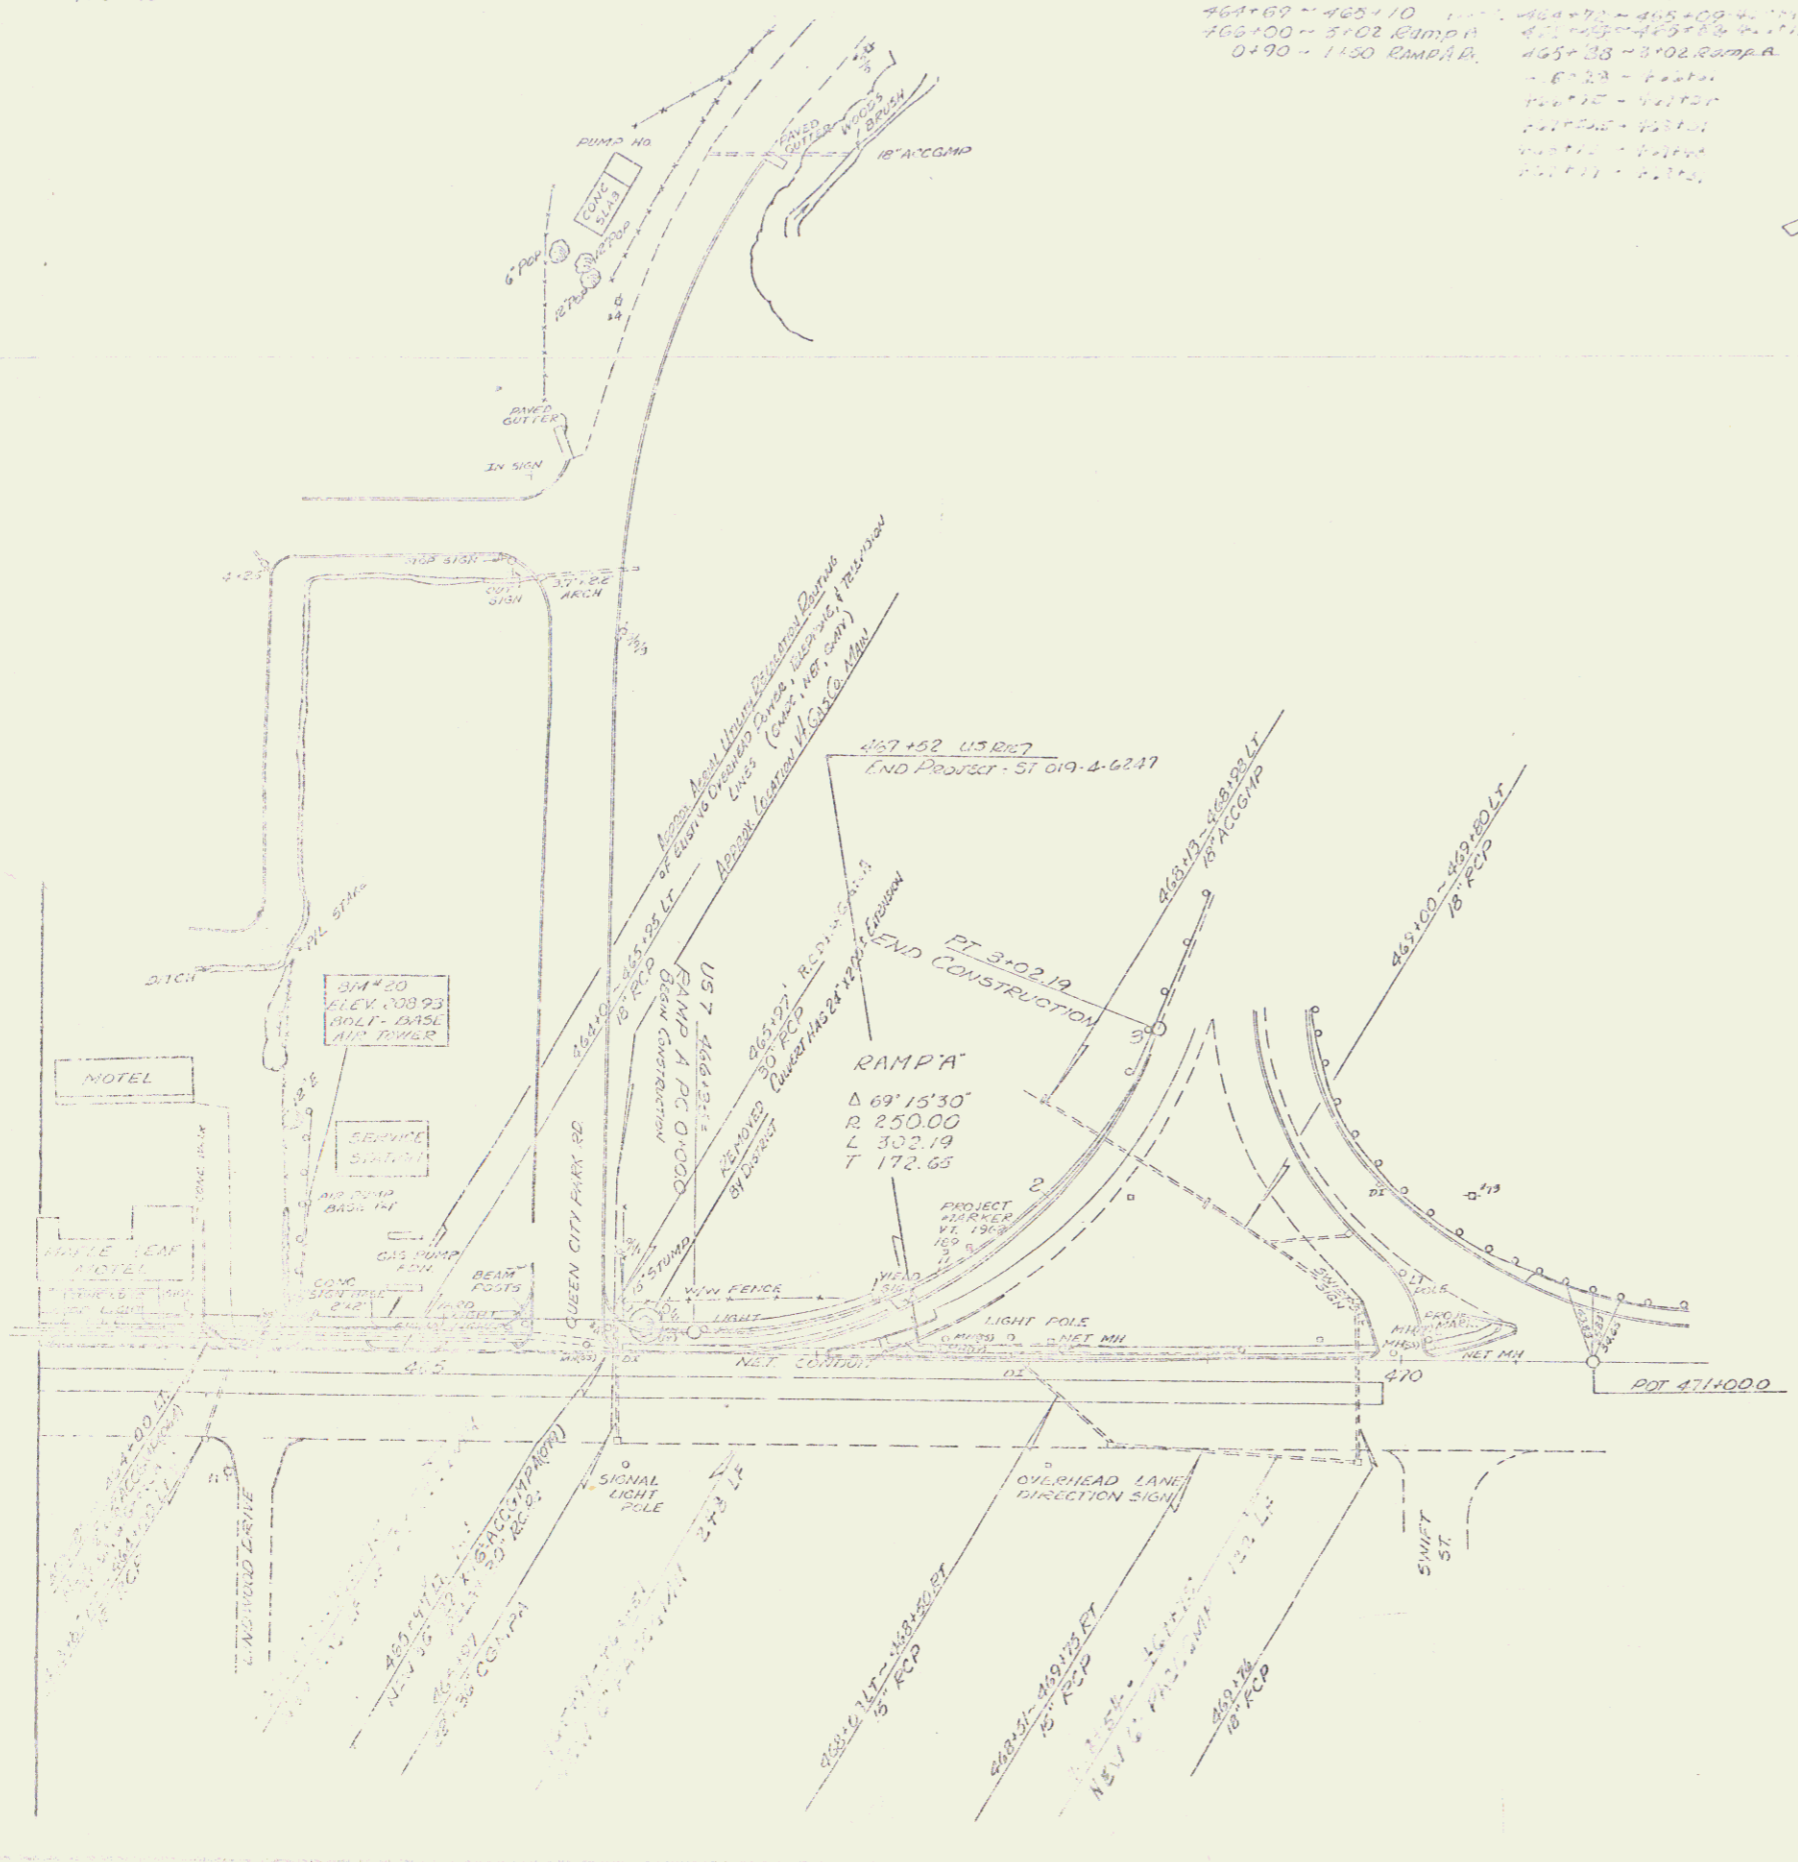

CHANGING ELEVATIONS OF CURB SIDING OR MANHOLES, ITEM 833
 464+00 4' "
 464+18 " "
 465+97 " "
 465+00 "

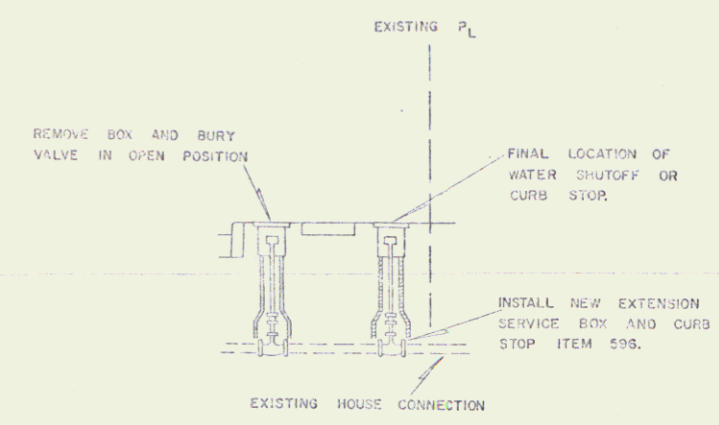

DETAIL FOR ITEM 596 MCD.
 EXTENSION SERVICE BOX
 AND CURB STOP.

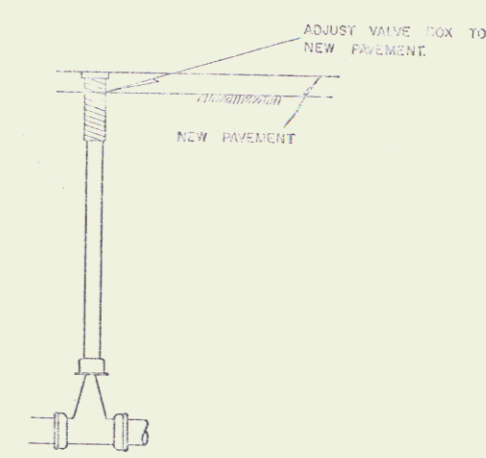

DETAIL FOR ITEM 902
 CHANGING ELEVATION OF
 WATER GATE VALVE BOXES

8A

SOUTH BURLINGTON

DESIGNED BY: [Signature]
 DRAWN BY: [Signature]
 CHECKED BY: [Signature]
 DATE: [Date]

