
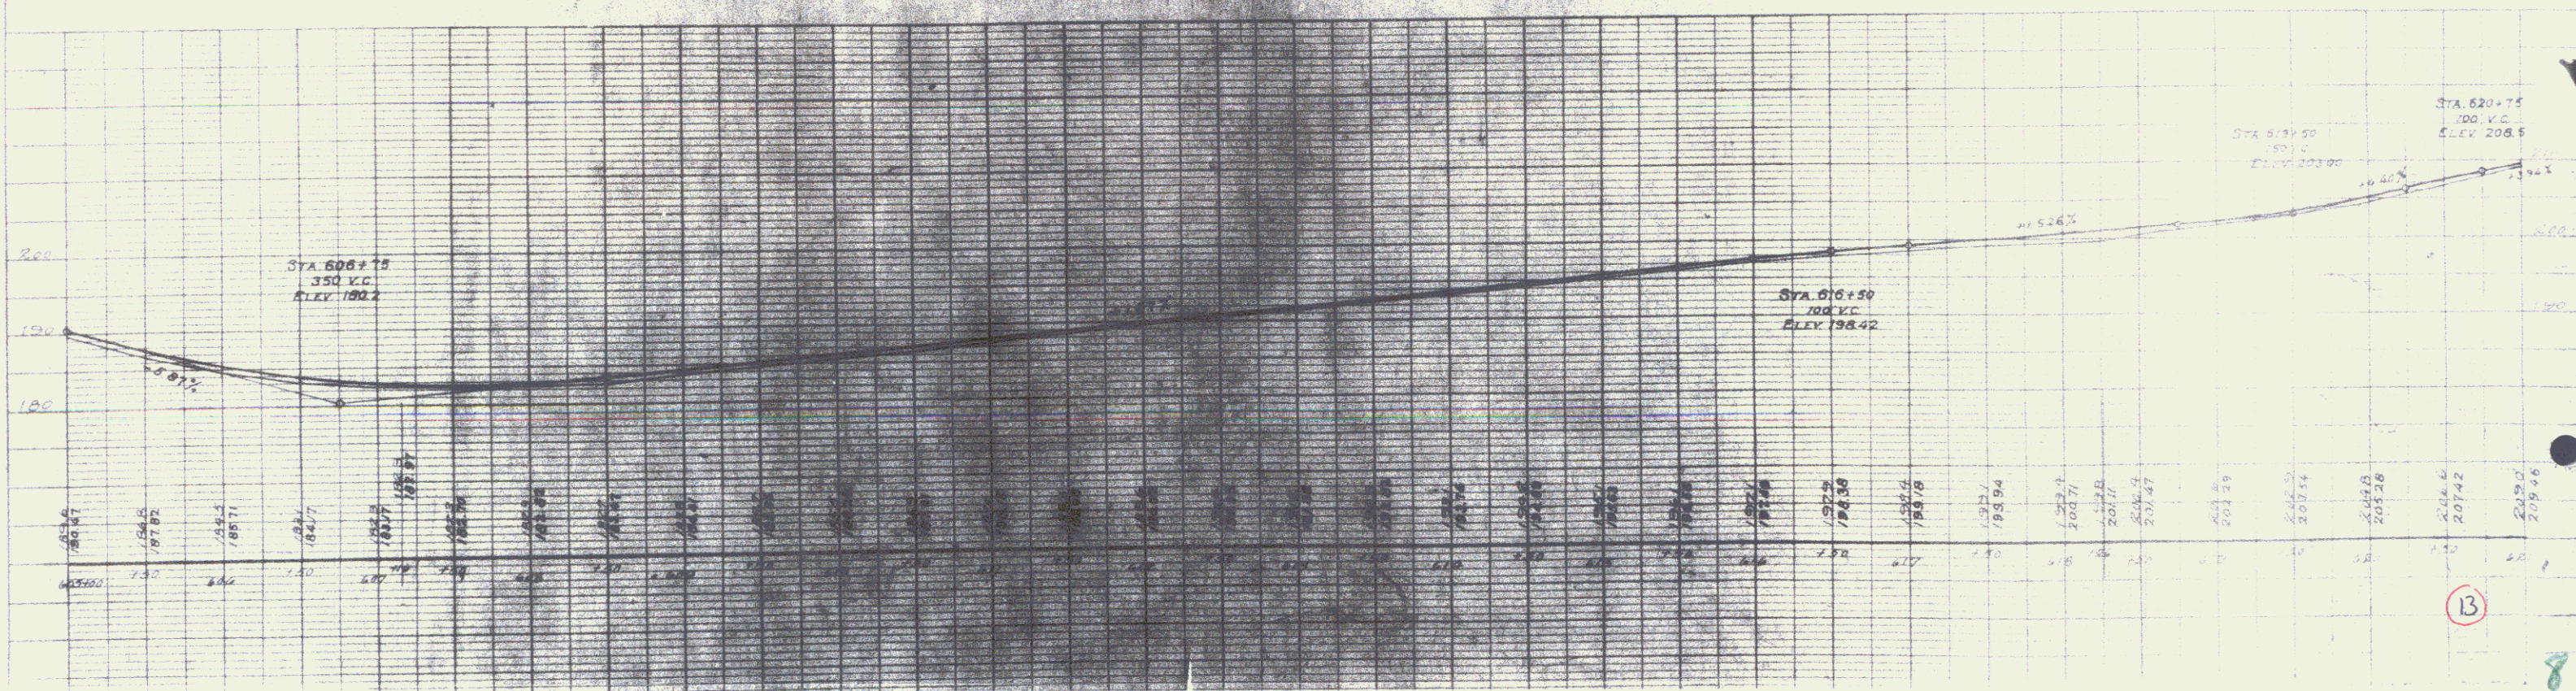


PLAN  
 SHEET NO. 13  
 PROJECT NO. 100-1000  
 DATE: 10/1/50

PROFILE  
 SHEET NO. 13  
 PROJECT NO. 100-1000  
 DATE: 10/1/50

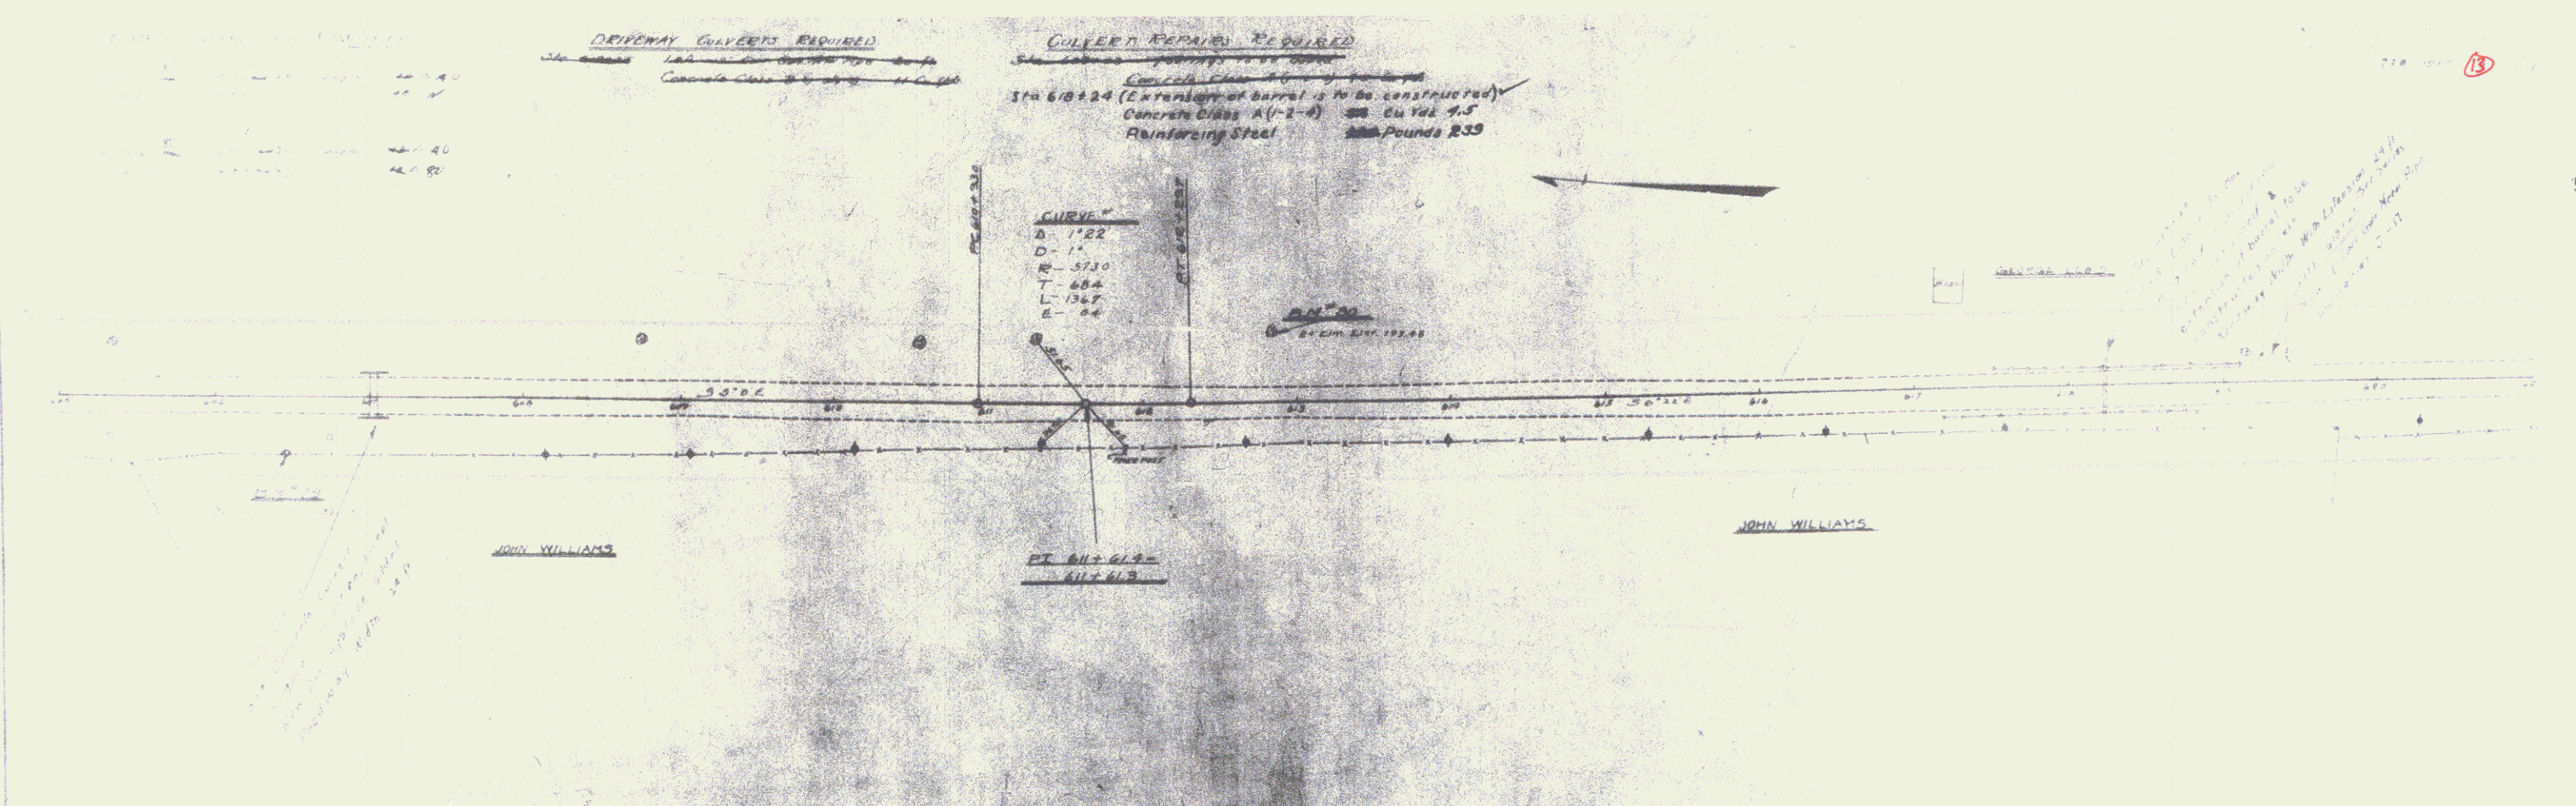

13

13

8