


NEW CULVERTS REQUIRED
 52+ 72.000 24" Reinforced Pipe Culvert 10.0' in
 Concrete Class (MC-2.4) 10' 4.0
 Reinforcing Steel 80 pounds 54
 52+ 72.250 24" Reinforced Pipe Culvert 10.0' in
 Concrete Class (MC-2.4) 10' 4.0
 Reinforcing Steel 80 pounds 54

NEW CULVERTS REQUIRED
 52+ 72.000 24" Reinforced Pipe Culvert 10.0' in
 Concrete Class (MC-2.4) 10' 4.0
 Reinforcing Steel 80 pounds 54
 52+ 72.250 24" Reinforced Pipe Culvert 10.0' in
 Concrete Class (MC-2.4) 10' 4.0
 Reinforcing Steel 80 pounds 54

SUB BASE OF GRAVEL REQUIRED
 52+ 71.500 to 71.750 6" Subbase of Gravel 500' in
 52+ 71.750 to 71.800 6" Subbase of Gravel 500' in

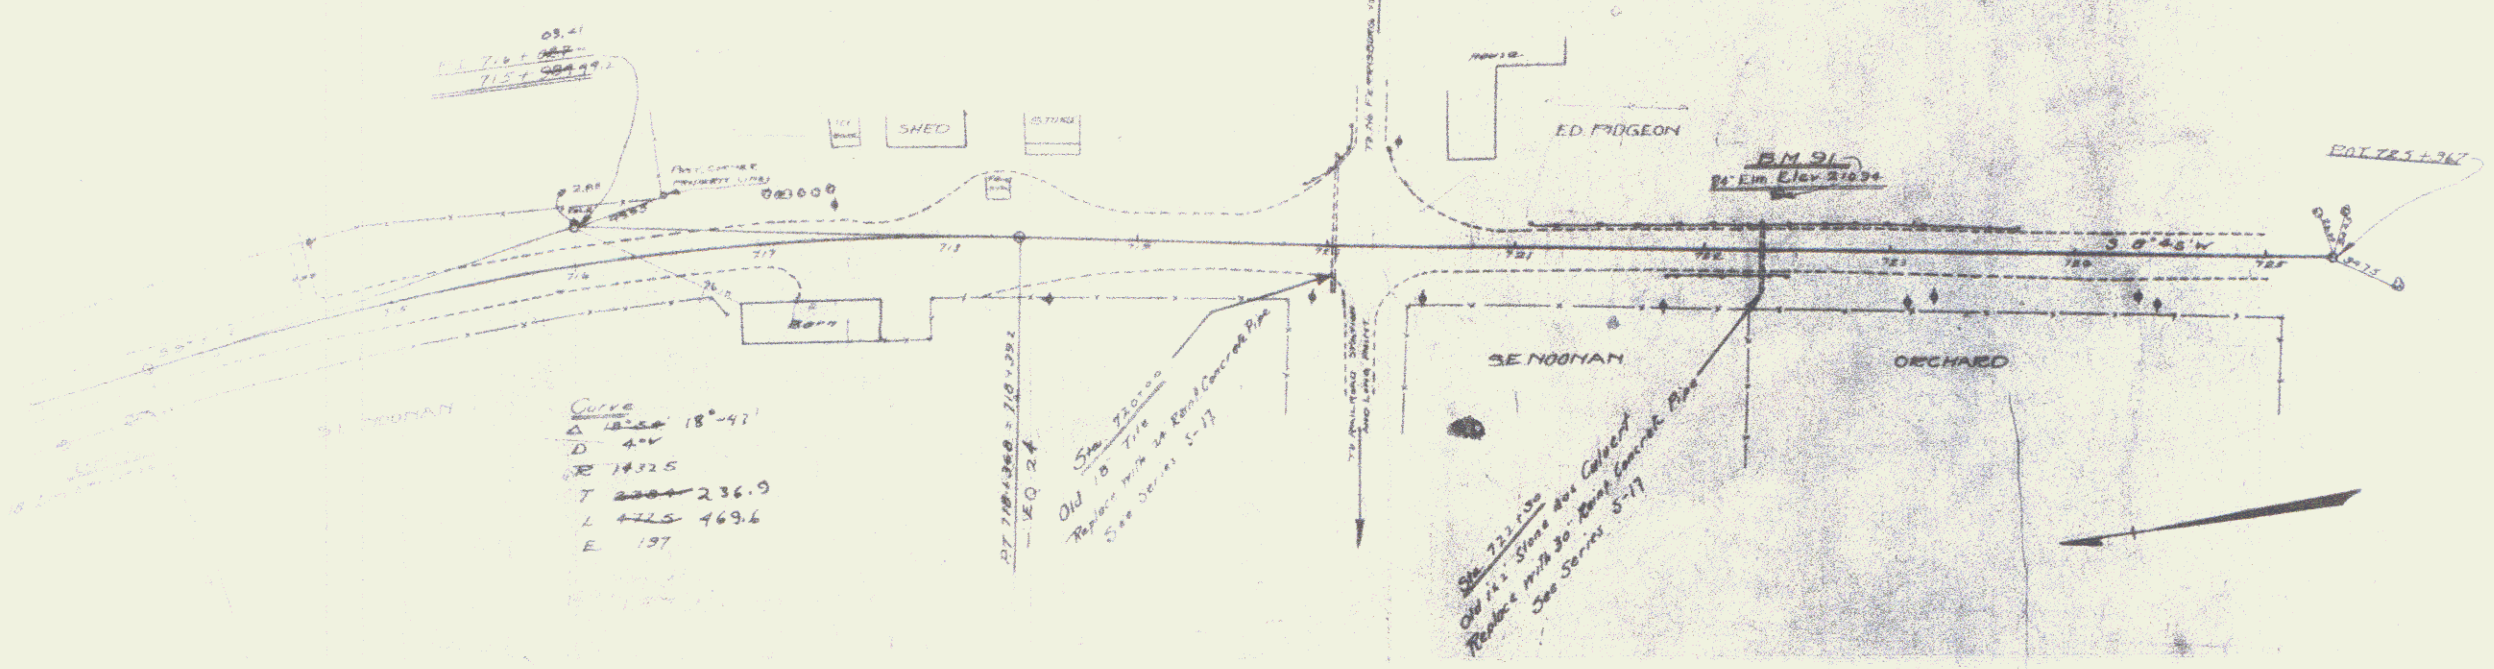

Curve
 Δ 18° 47'
 D 400
 R 192.5
 T 236.9
 L 469.6
 E 197

