


Spacing of Cur 1/2" @ 1' - 48

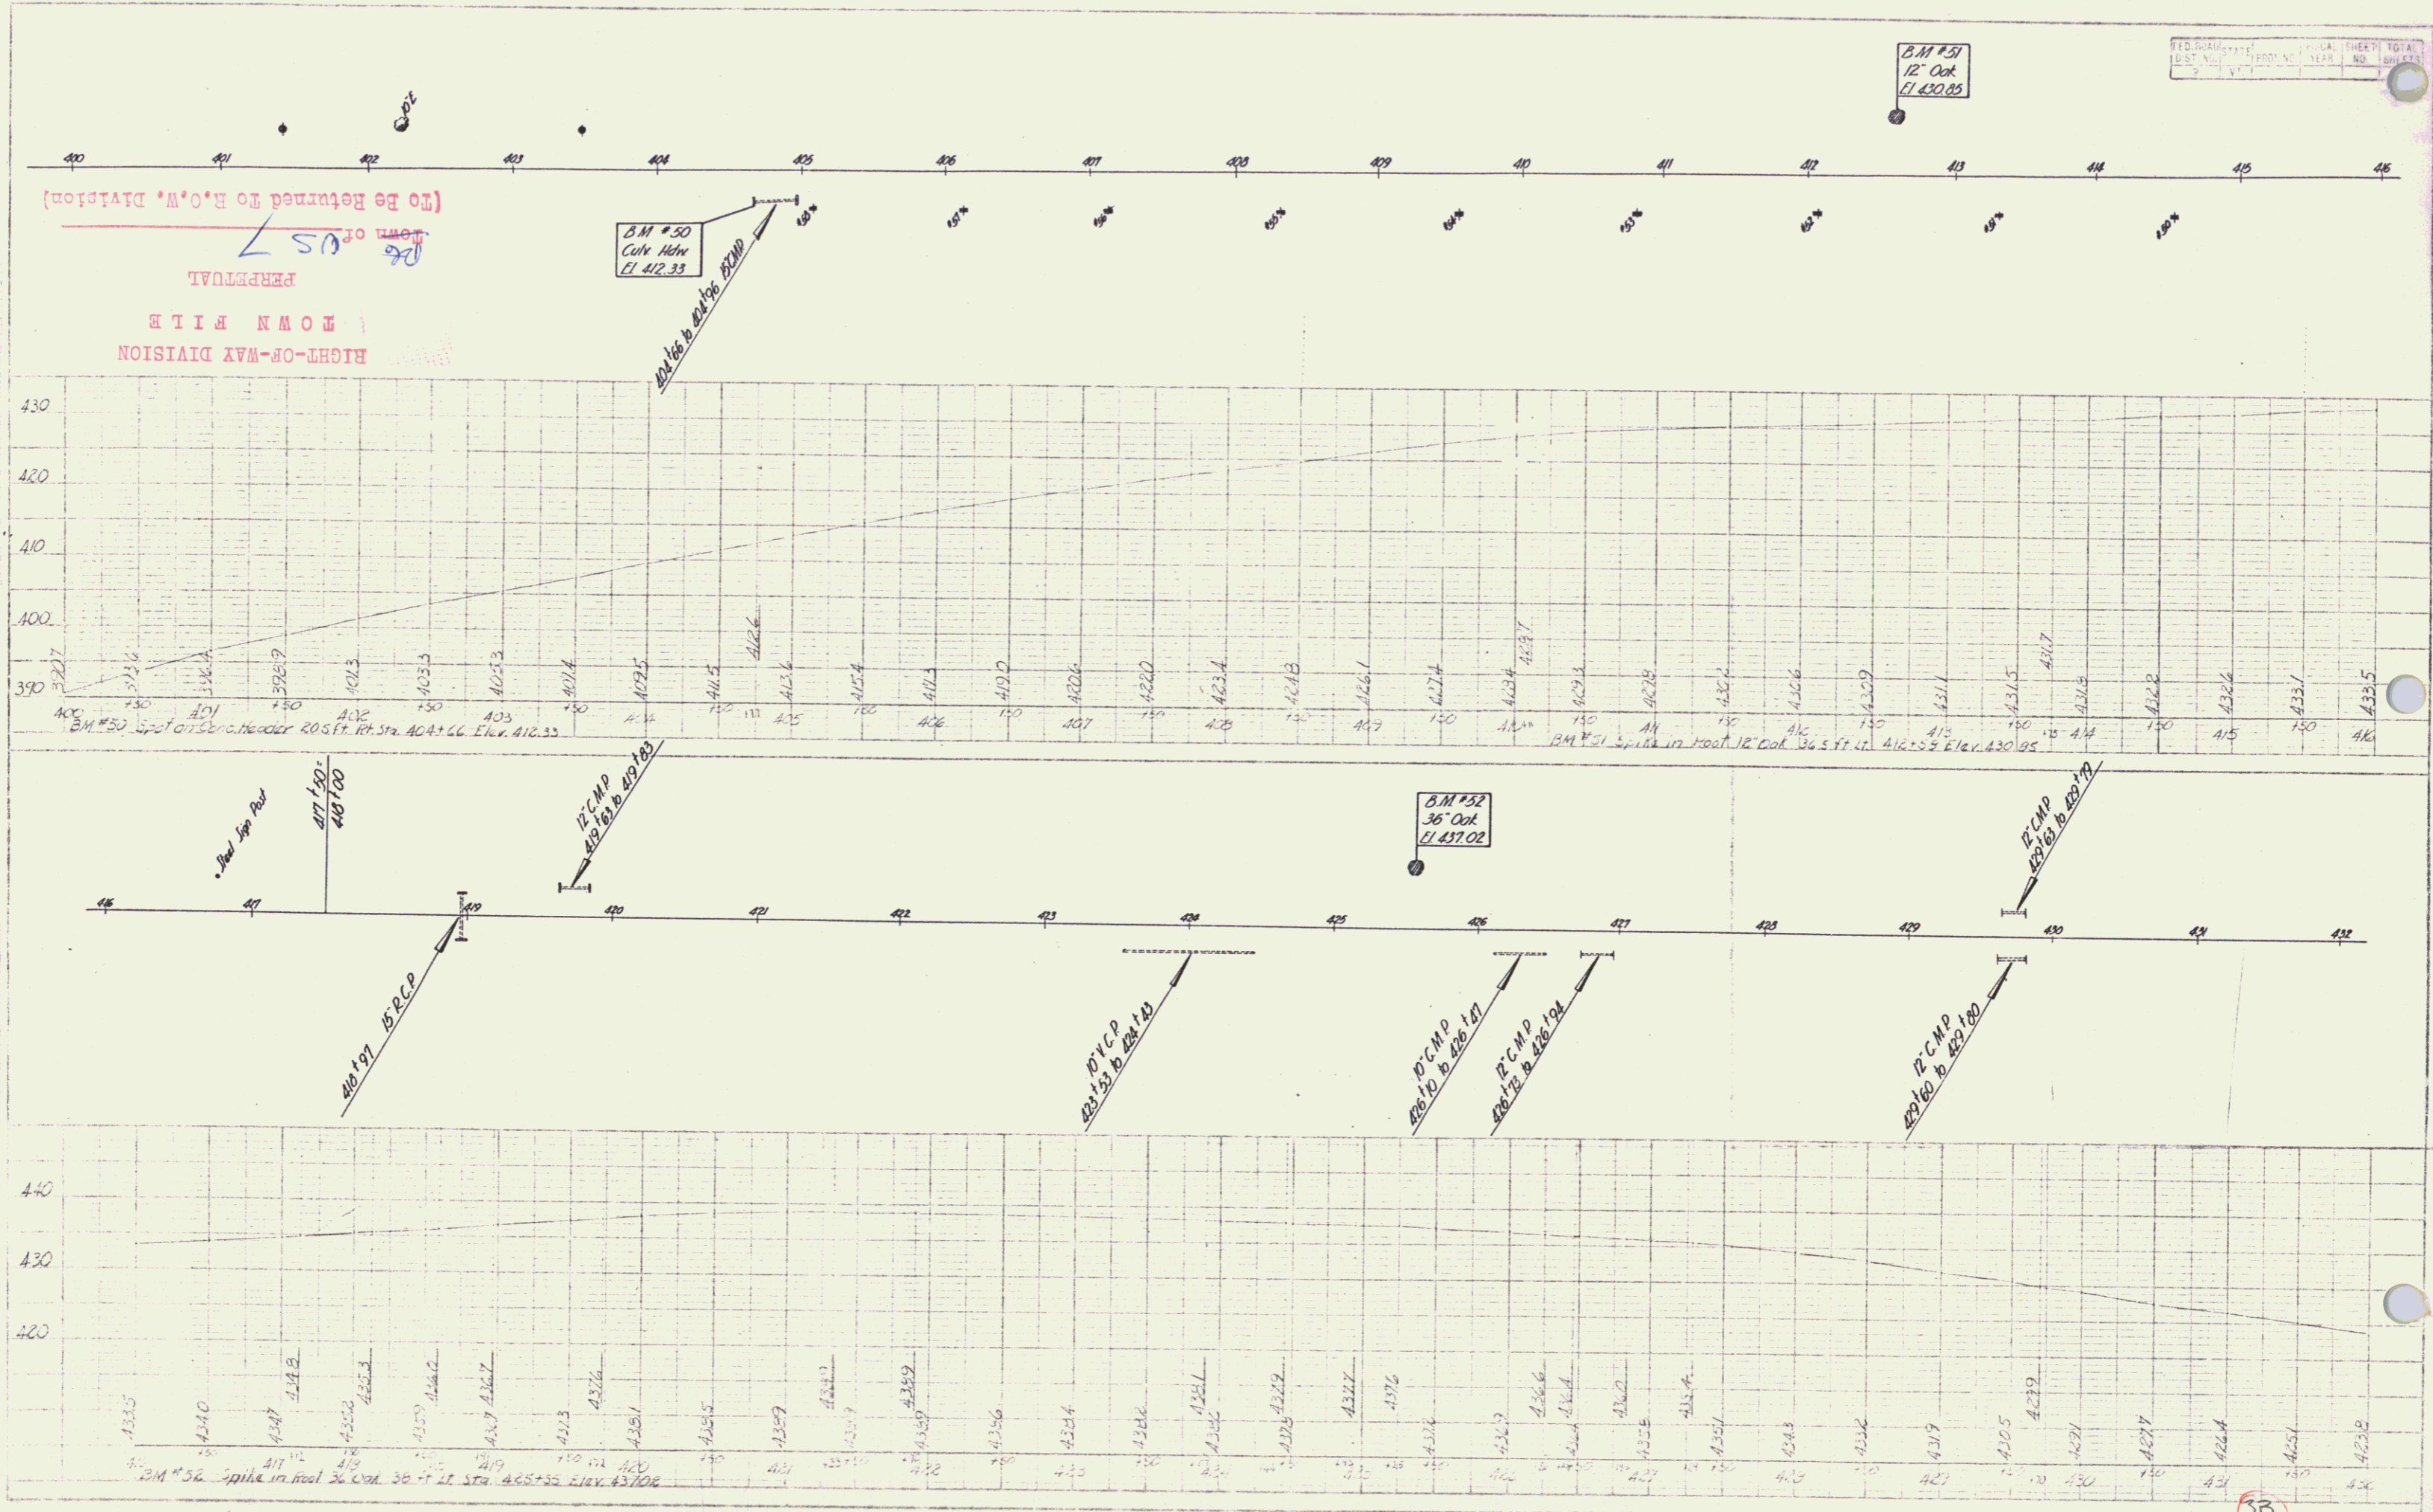

RIGHT-OF-WAY DIVISION
TOWN FILE
PERPETUAL
To Be Returned to E.O.W. Division

B.M. #50 Spot on Sero. Header 205 ft. R.F. Sta. 404+66 Elev. 412.33

B.M. #51 Spike in Root 12" Oak 36.5 ft. L. 412+53 Elev. 430.05

B.M. #52 Spike in Root 36" Oak 36.5 ft. L. Sta. 445+55 Elev. 437.02

Min 0.00 to 3.00

Charlotte F 92 (4)

SB

4

FED. ROAD DIST. NO.	STATE	PROJ. NO.	YEAR	SHEET NO.	TOTAL SHEETS