
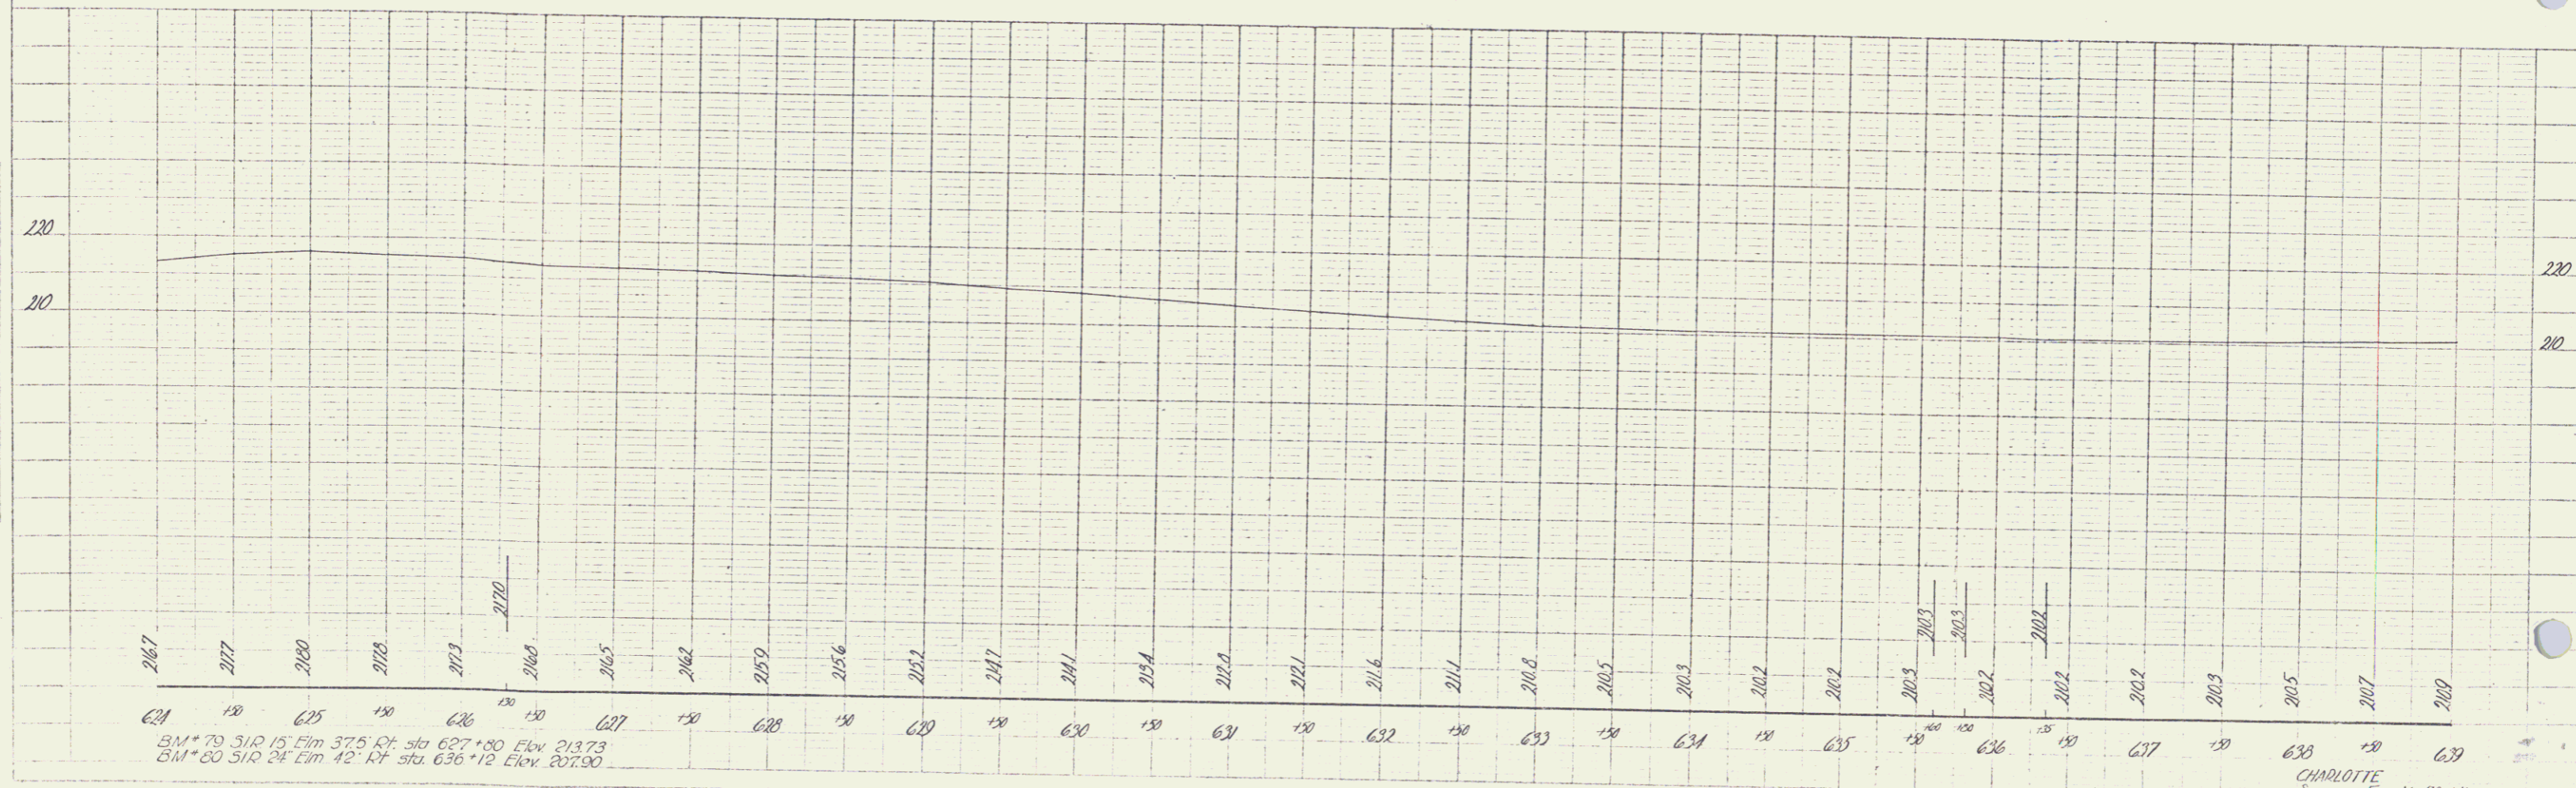


9

PLAN SHEET NO.	PROJ. NO.	YEAR	TOTAL SHEETS
9	2000	12	62

POST WAR 73 SALARY

DATE	BY	CHECKED

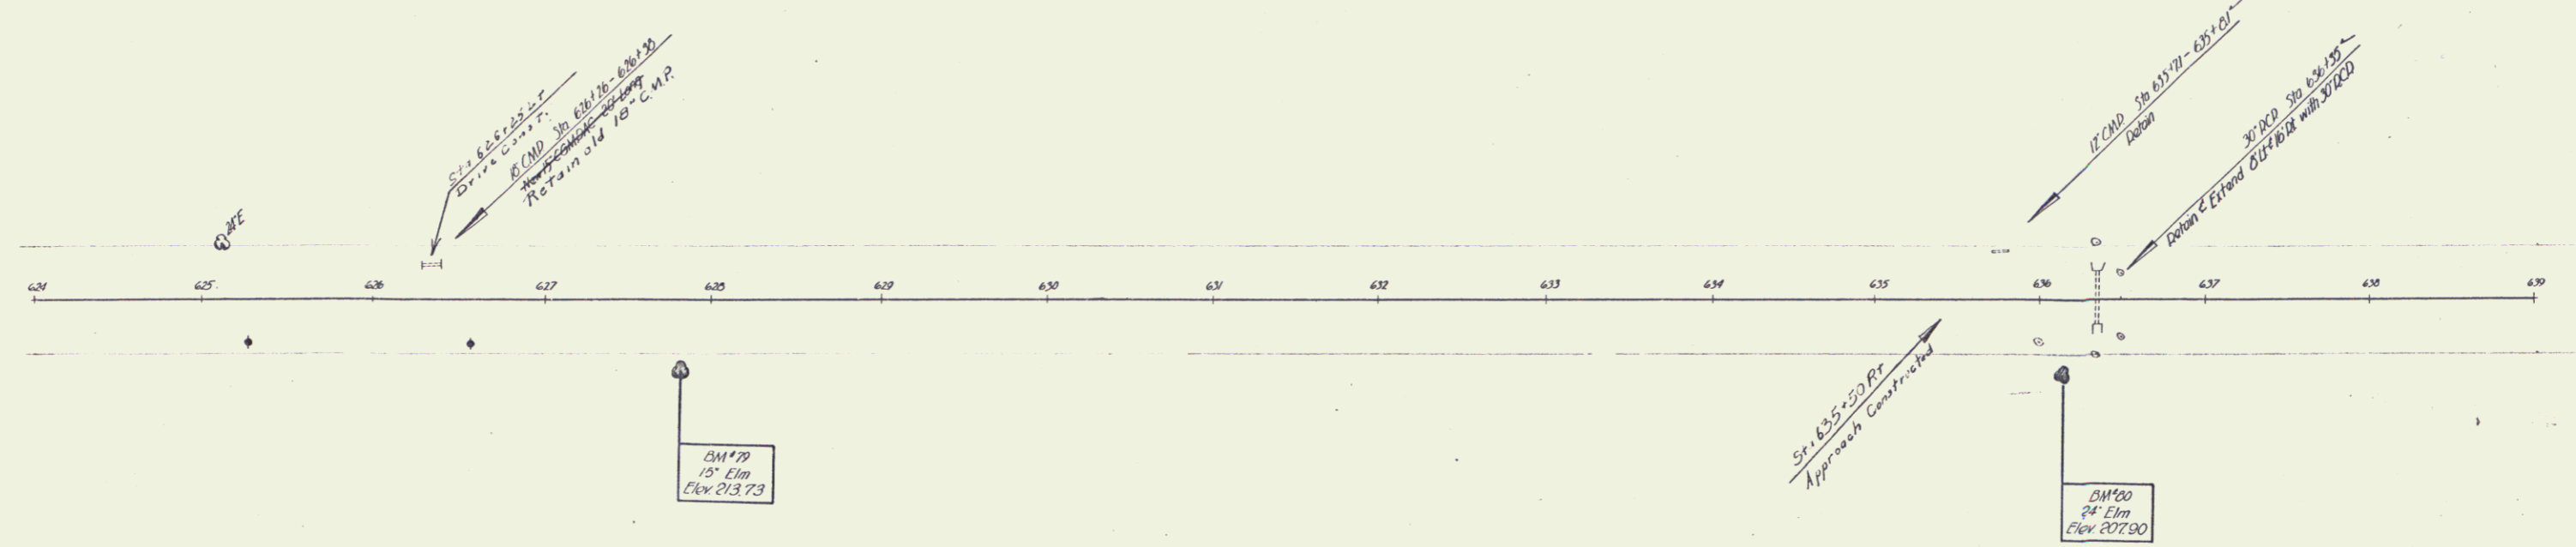

BM* 79 SIR 15' Elm 37.5' Rf. sta. 627+80 Elev. 213.73
 BM* 80 SIR 24' Elm 42' Rf. sta. 636+12 Elev. 207.90

CHARLOTTE
 Jones F. No. 72 (A)
 Sheet 12 of 62 Sheets

13