



PLAN  
 DATE: 11/1/62  
 DRAWN BY: G. Houghton  
 3-45

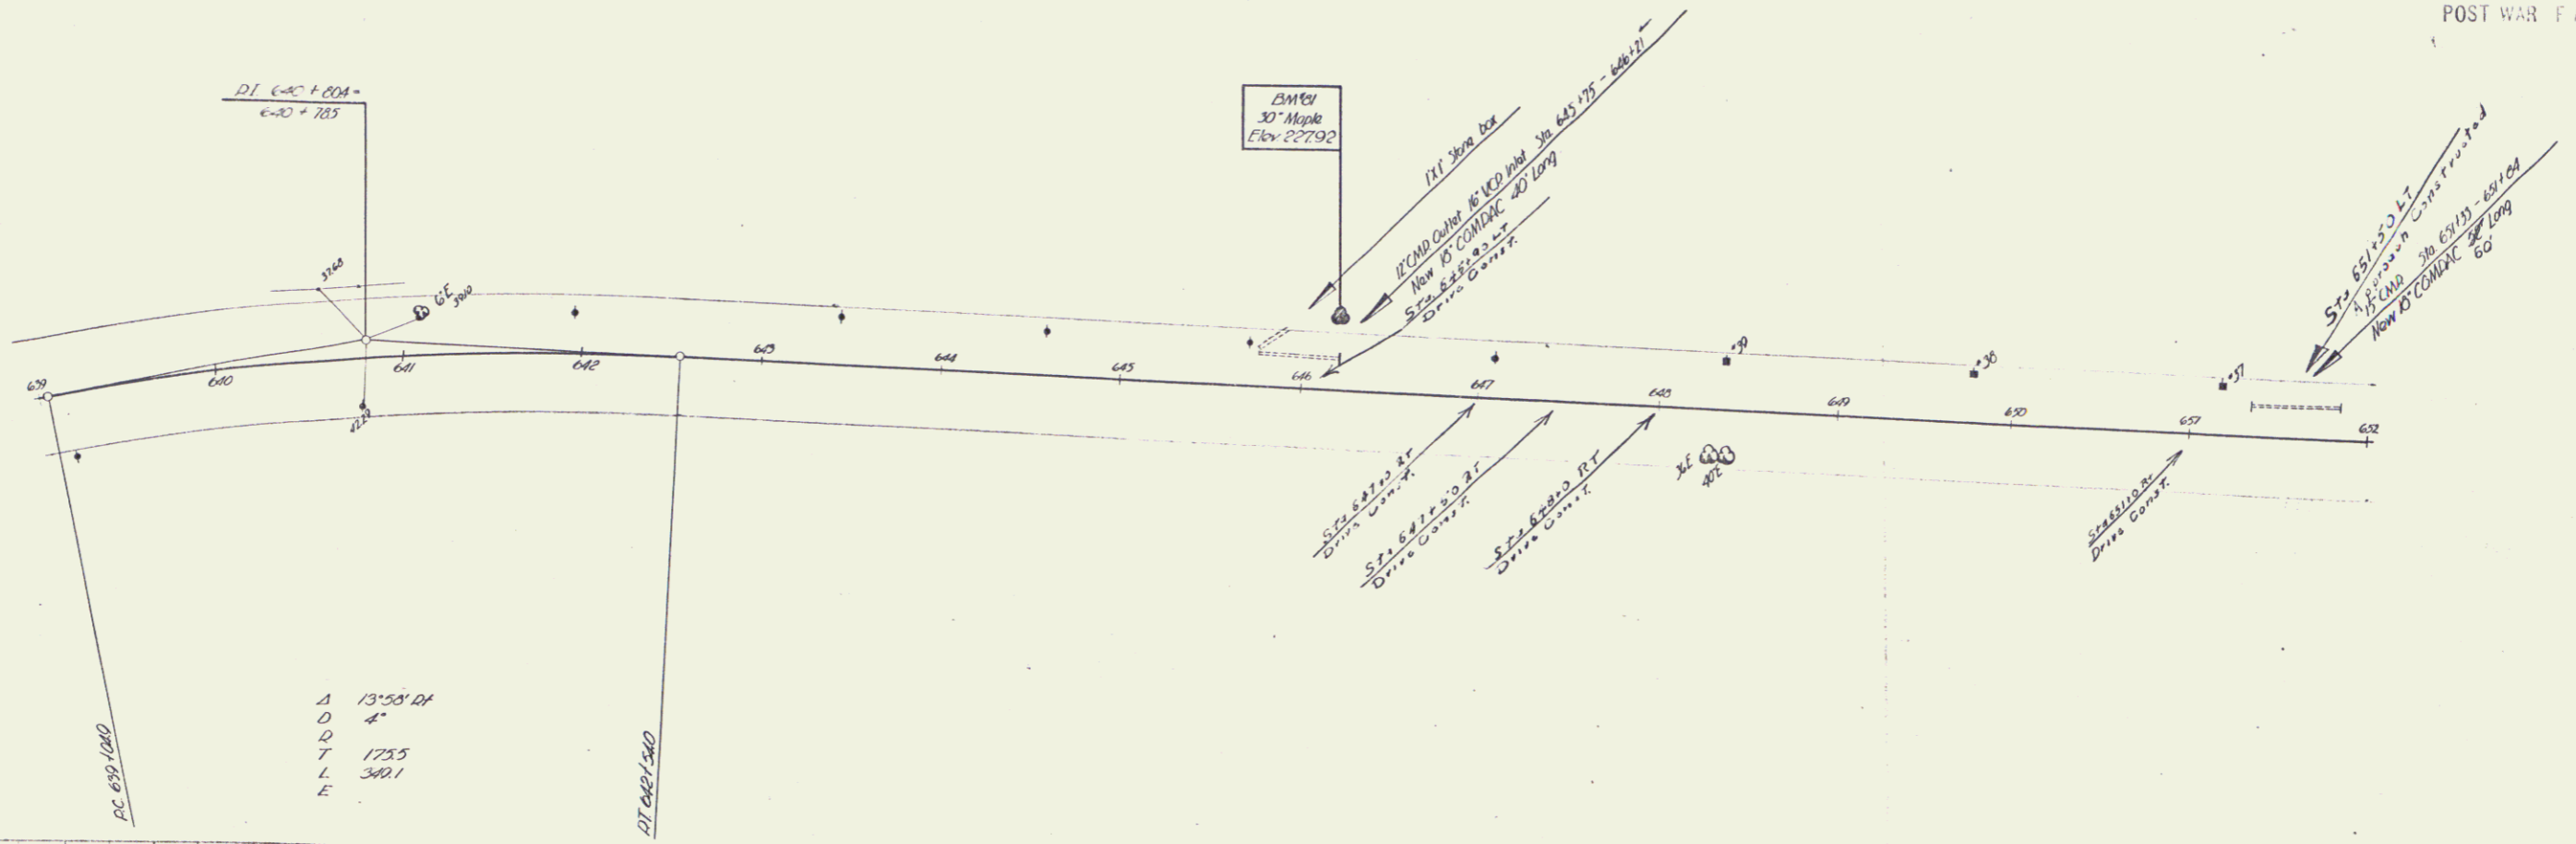

A 13.55 DI  
 O 4"  
 D  
 T 173.5  
 L 340.1  
 E

PROFILE  
 DATE: 11/1/62  
 DRAWN BY: G. Houghton  
 No. 12 of 12

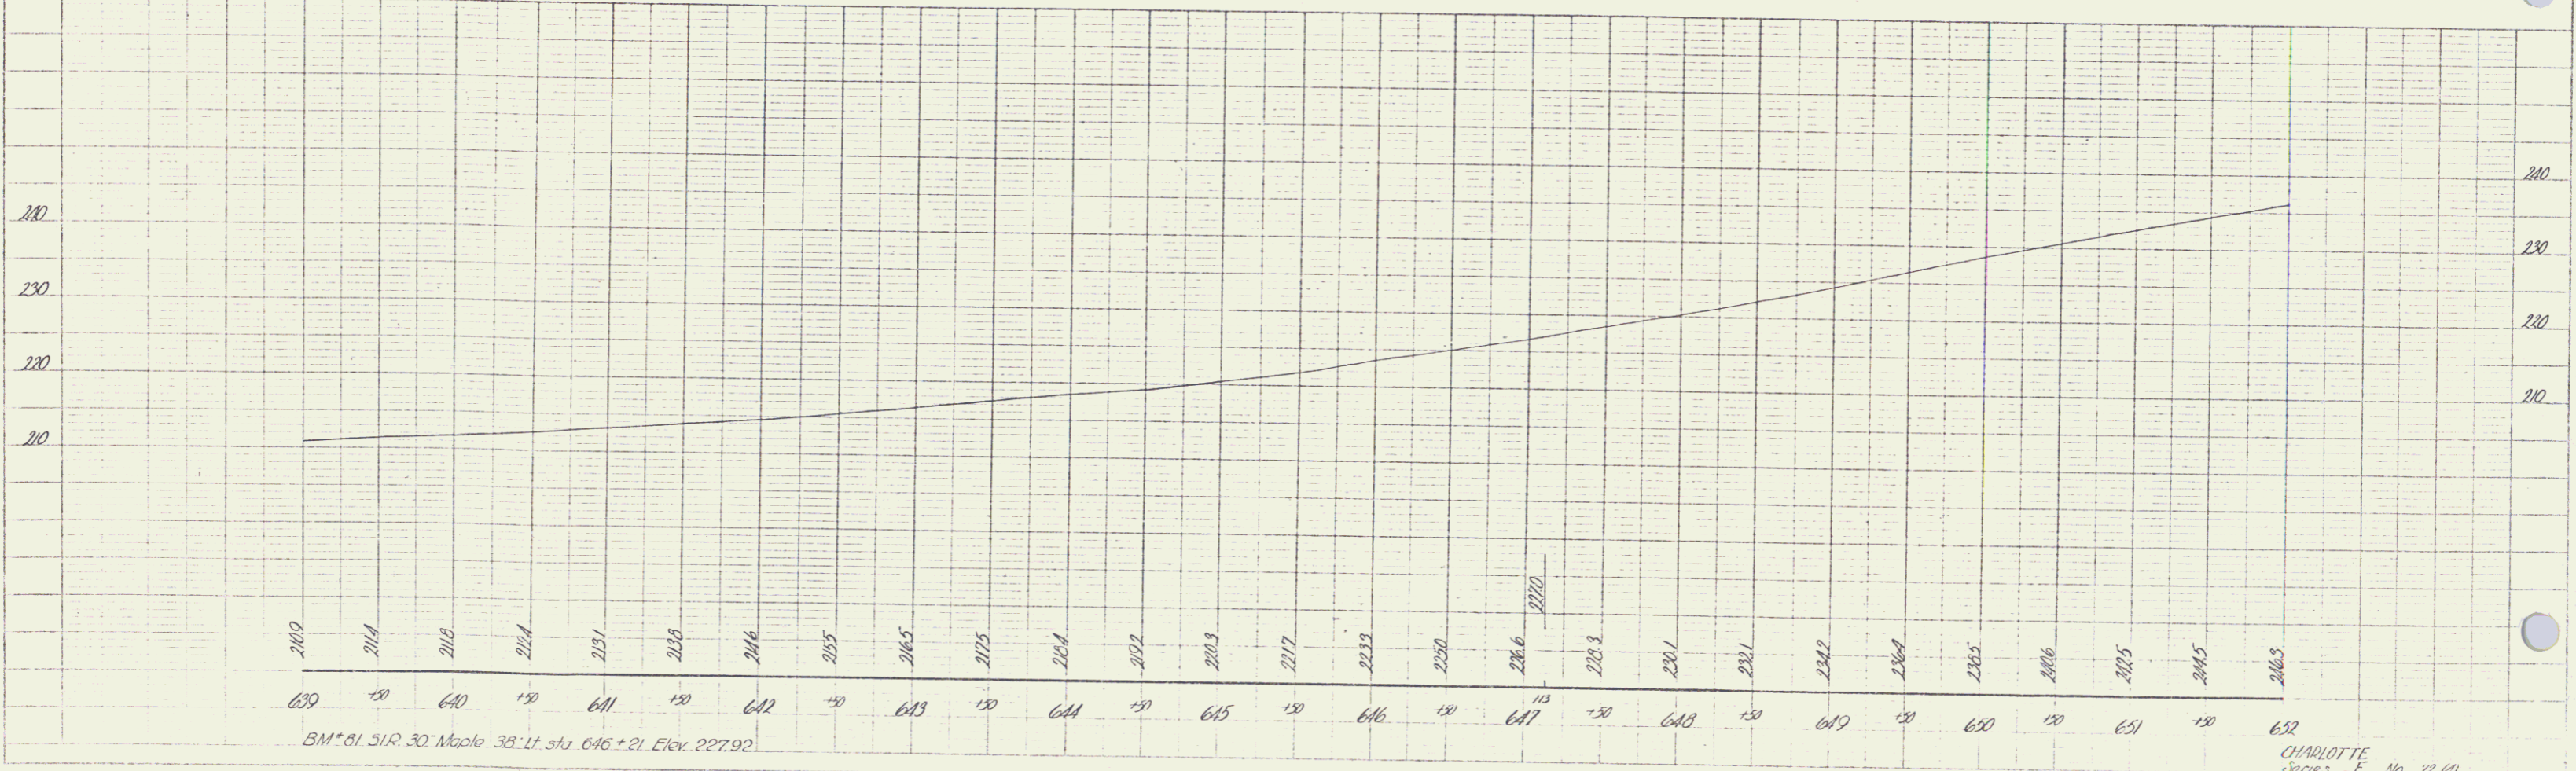

CHARLOTTE  
 Jones F. No. 12 of 12  
 Sheet 10 of 12 Sheets