


12


DESIGN NO.	PROJECT NO.	DATE	SHEET NO.	TOTAL SHEETS
9	7278		15	68

POST WALK PRIMARY

PLAN
 DATE
 DRAWN BY
 CHECKED BY
 APPROVED BY

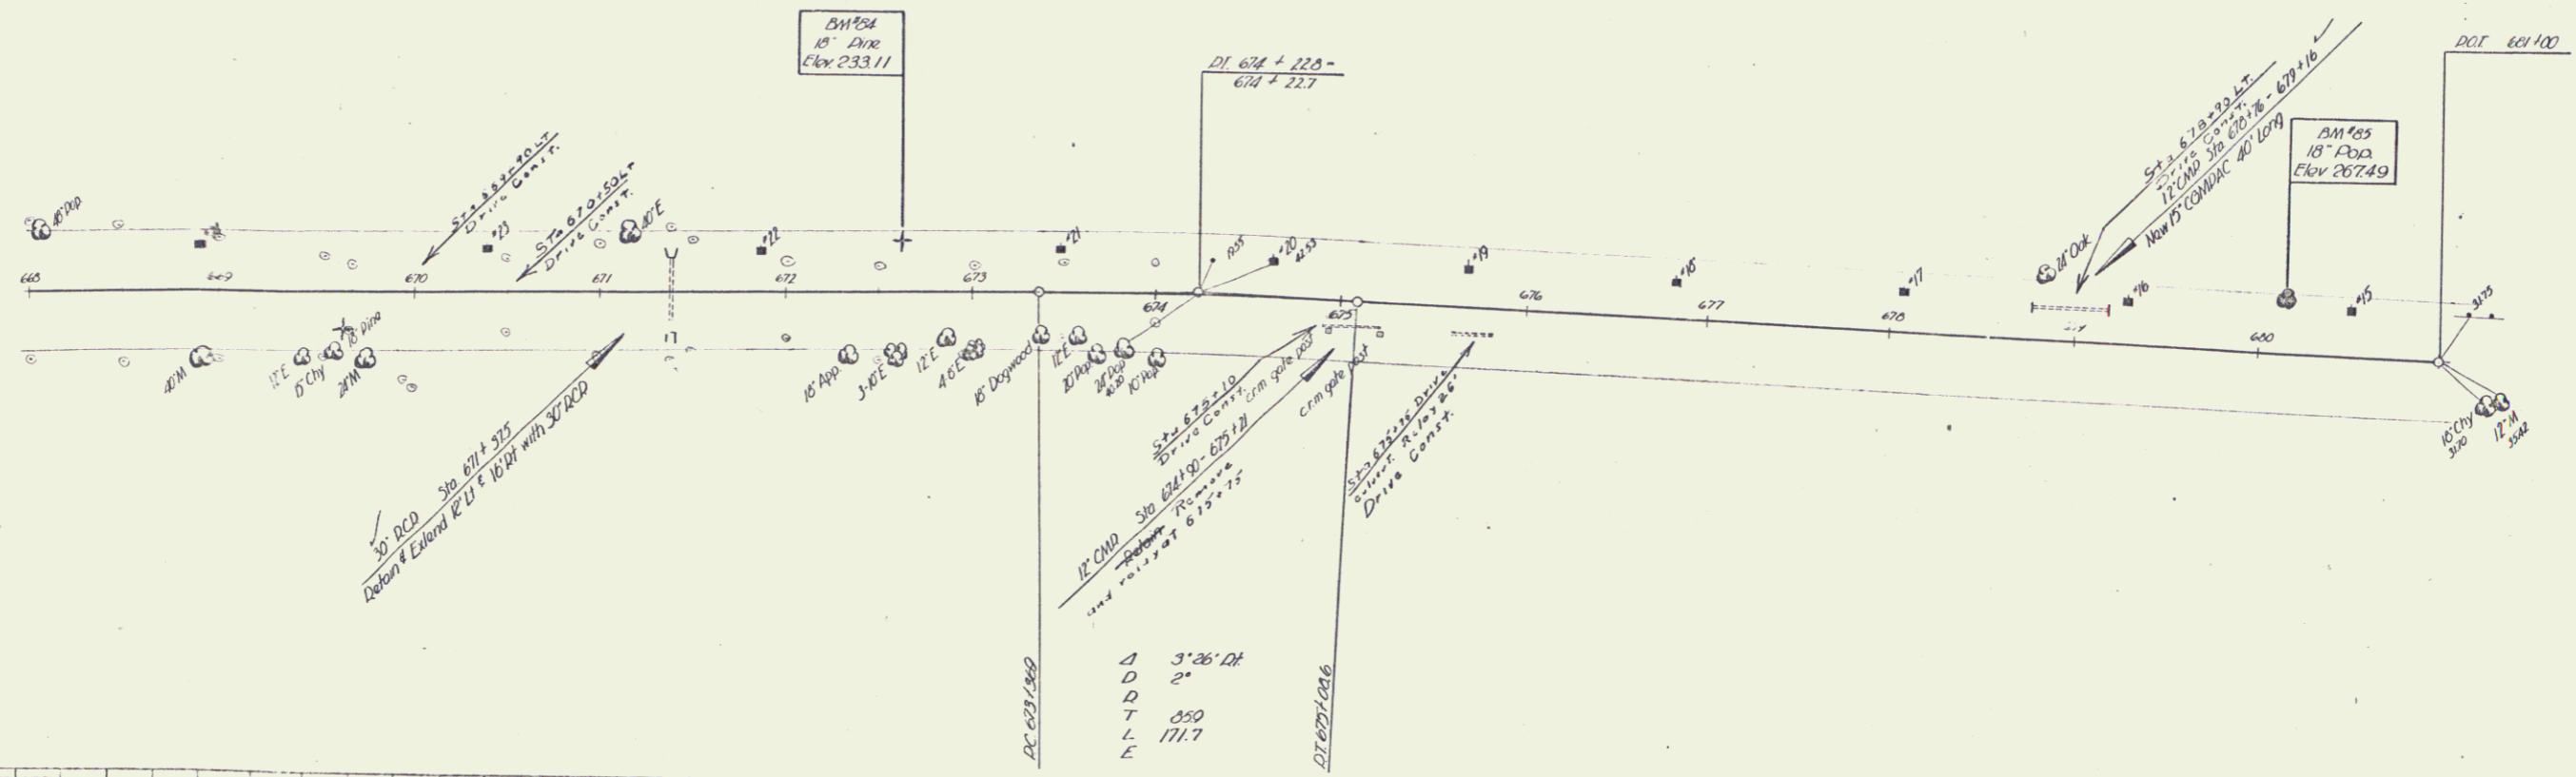

Δ 3'36" DT
 \square 2"
 \circ 350
 \bullet 171.7
 \square 27.00/1.046

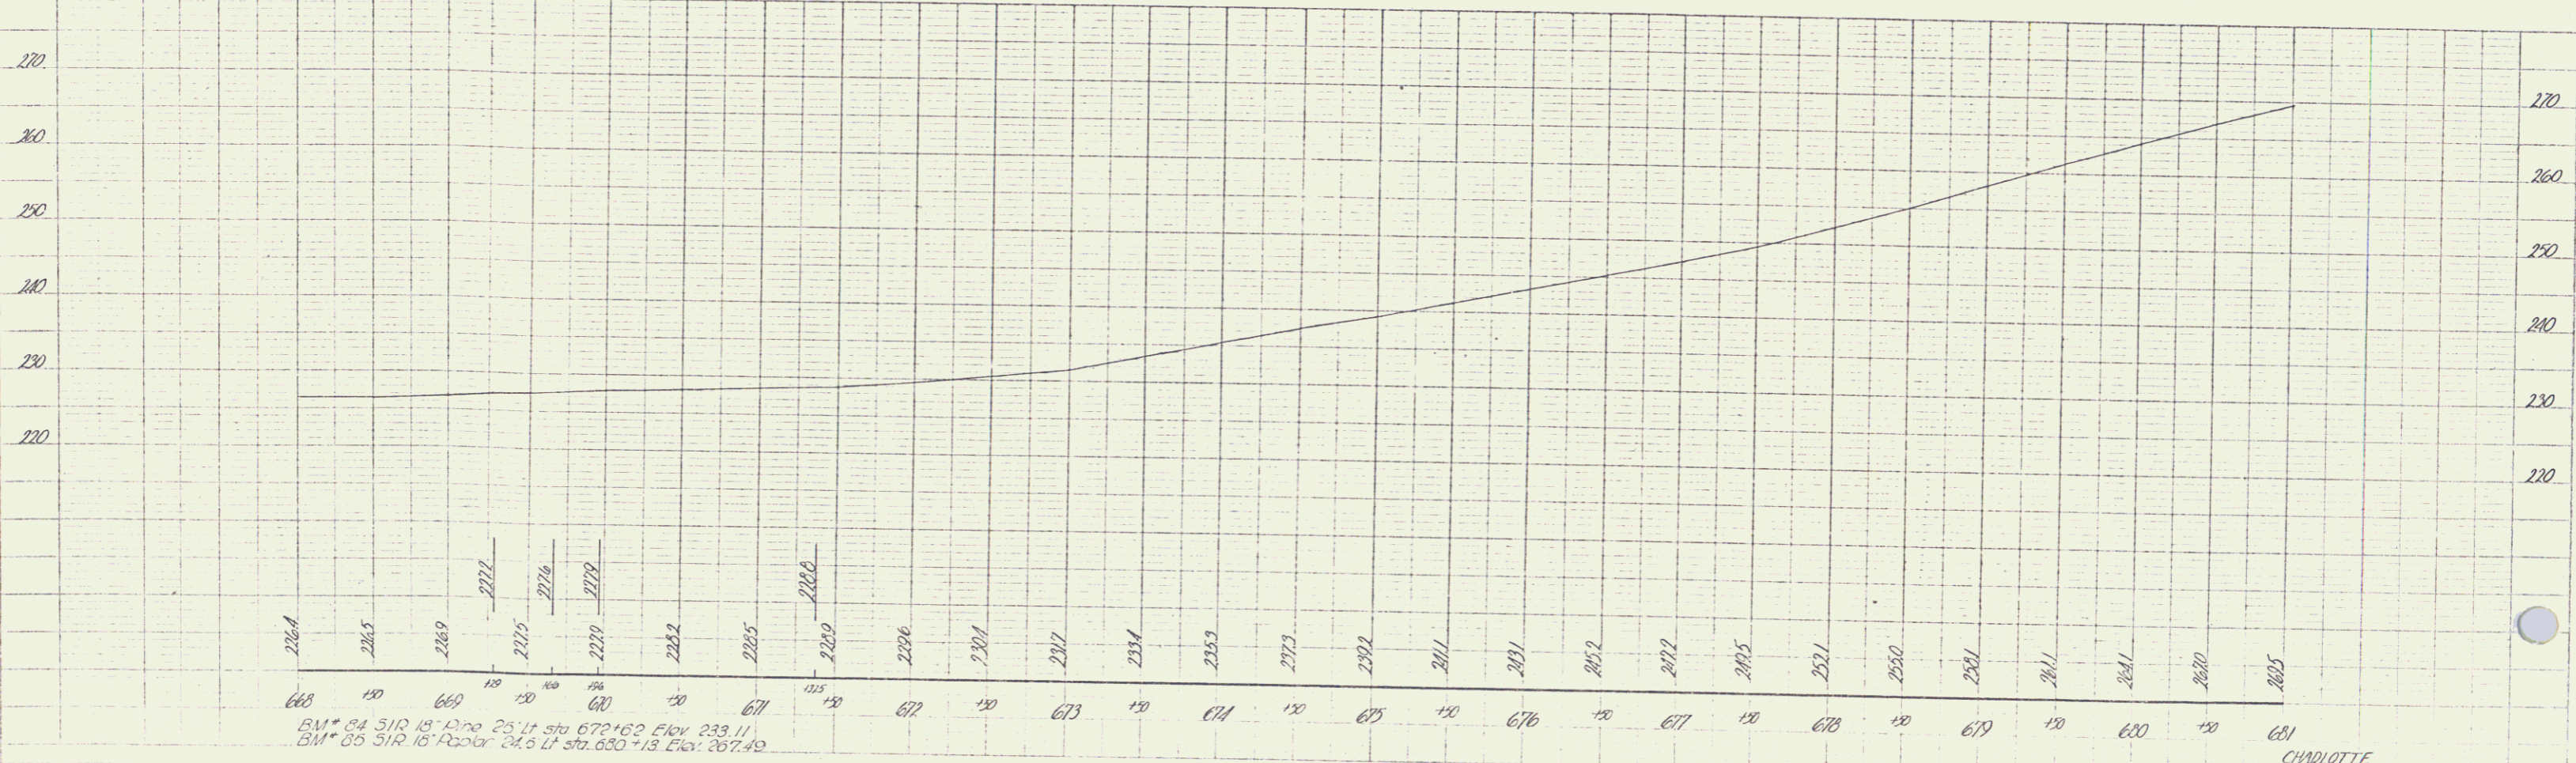

BM* 84 51R 18" Pipe 25.4' sta 672+60 Elev. 233.11
 BM* 85 51R 18" Pipe 24.6' sta 680+13 Elev. 267.49

CHARLOTTE
 Series No. 72 (A)
 Sheet 15 of 62 Sheets

16