



13

A	6:25 11
D	1:30
T	2:30
L	12:30
E	

A	15:45 11
D	4
T	12:30
L	3:30
E	1:37

POST WAR F A PRIMARY

PLAN  
 NOTE: SEE...  
 10/20/62

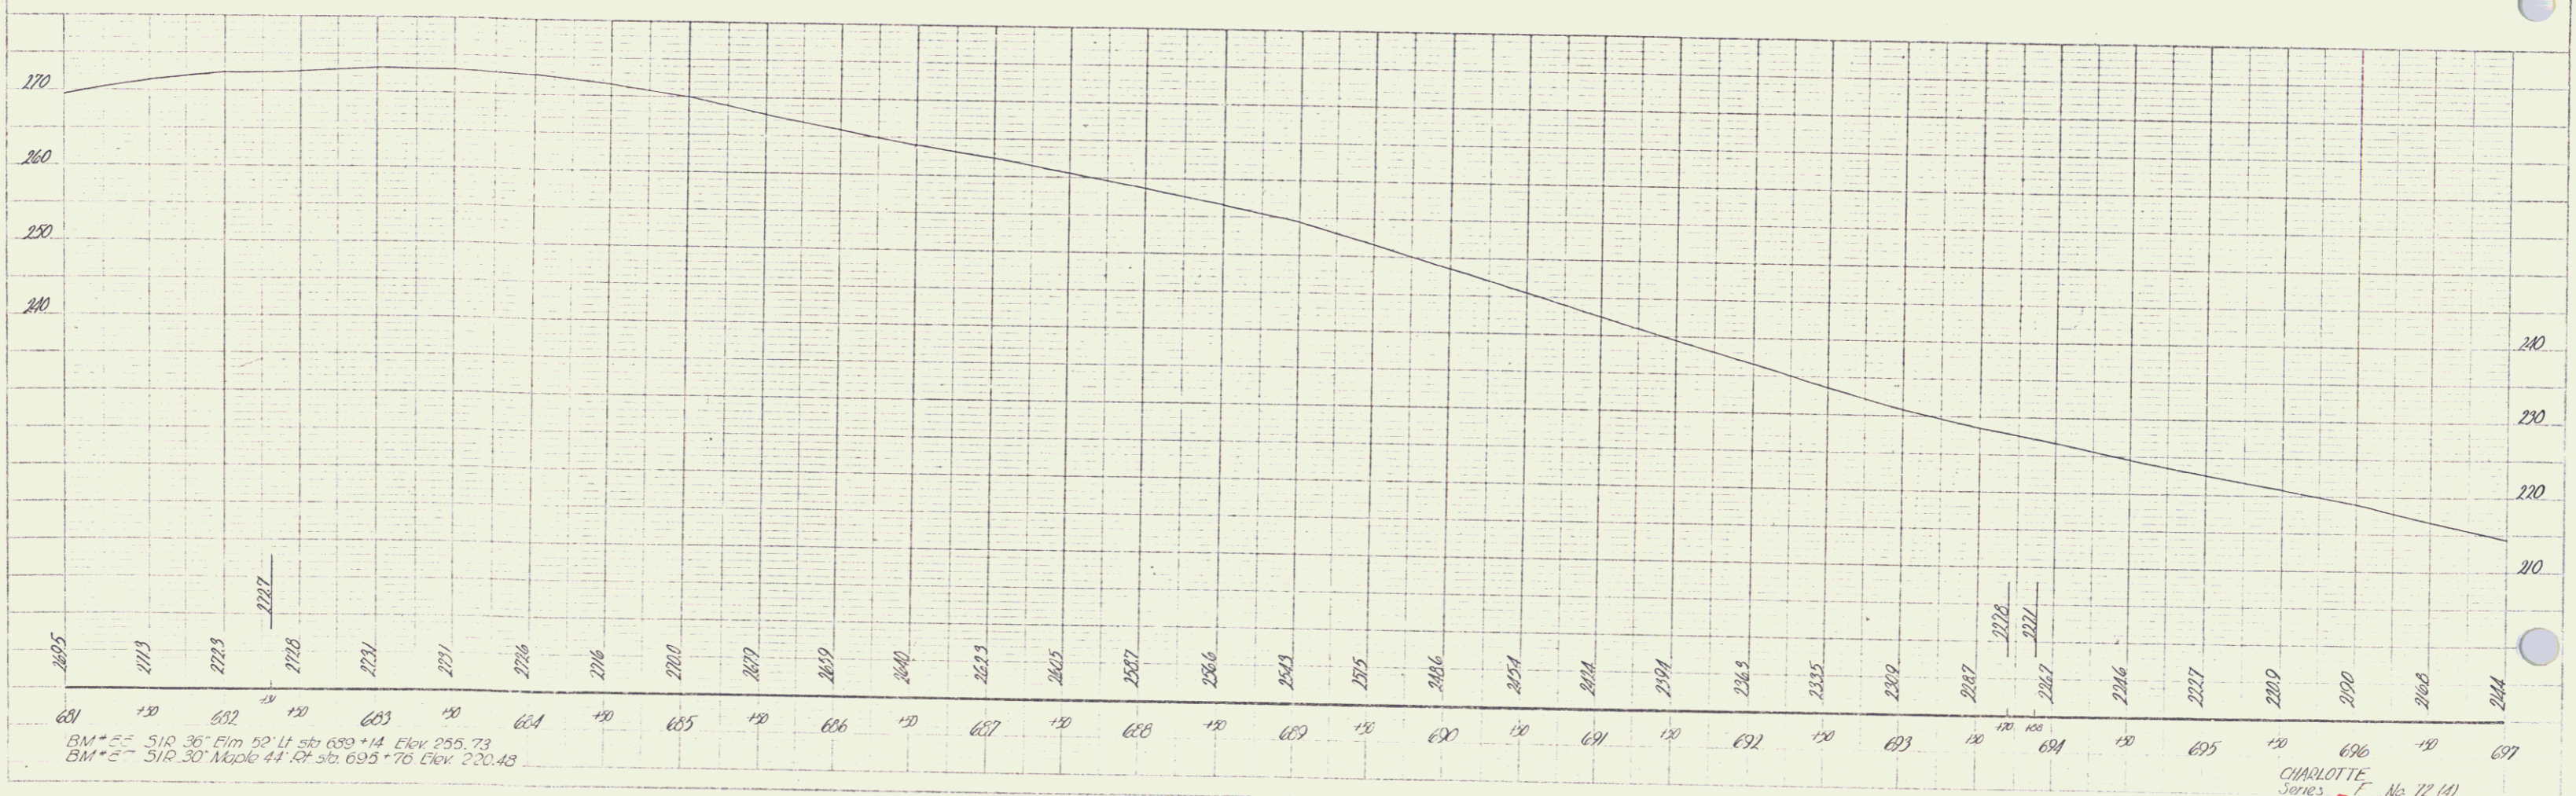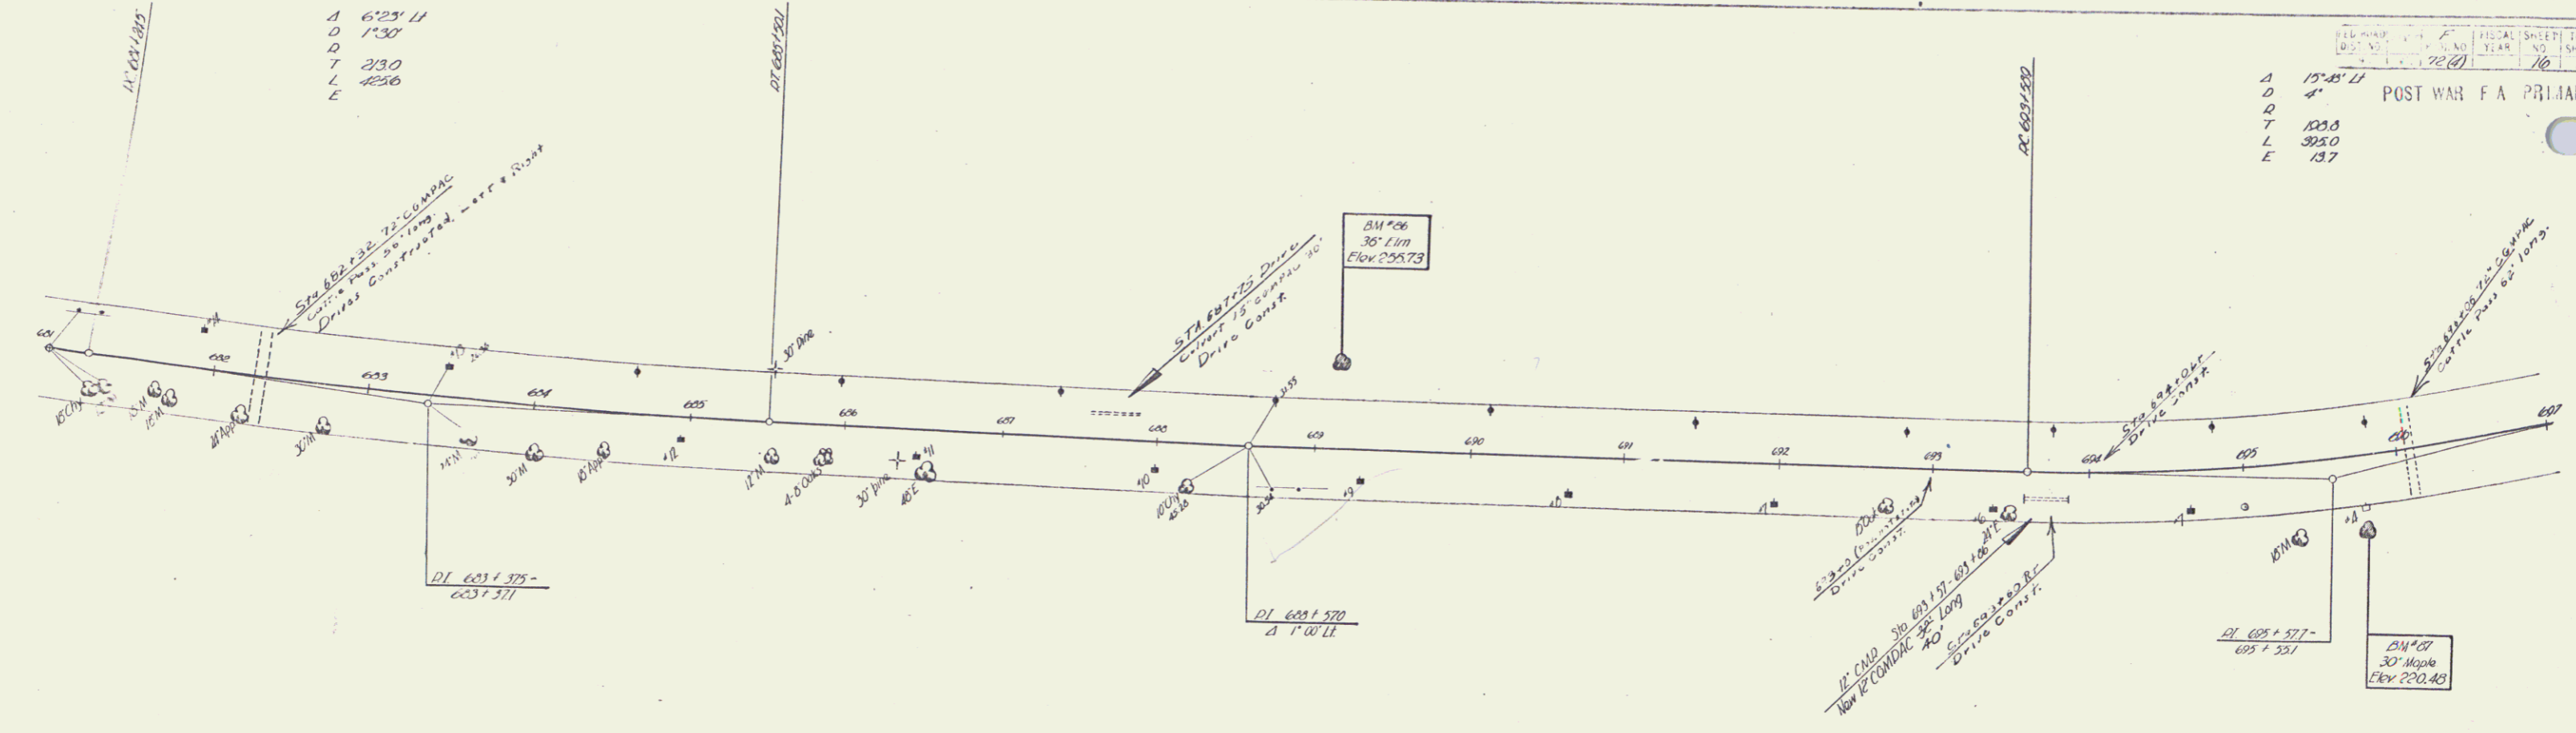

BM # 1 = 510.36 Elm 52' Lt sb 630+14 Elev 255.73  
 BM # 2 = 510.30 Maple 44' Rt sb 695+70 Elev 220.43

CHARLOTTE  
 Series F No 72 (A)  
 Sheet 10 of 62 Sheets

17