


PROJECT NO.	POSTED YEAR	TOTAL SHEETS
17-62	17	62


POST WAR F A PRIMARY

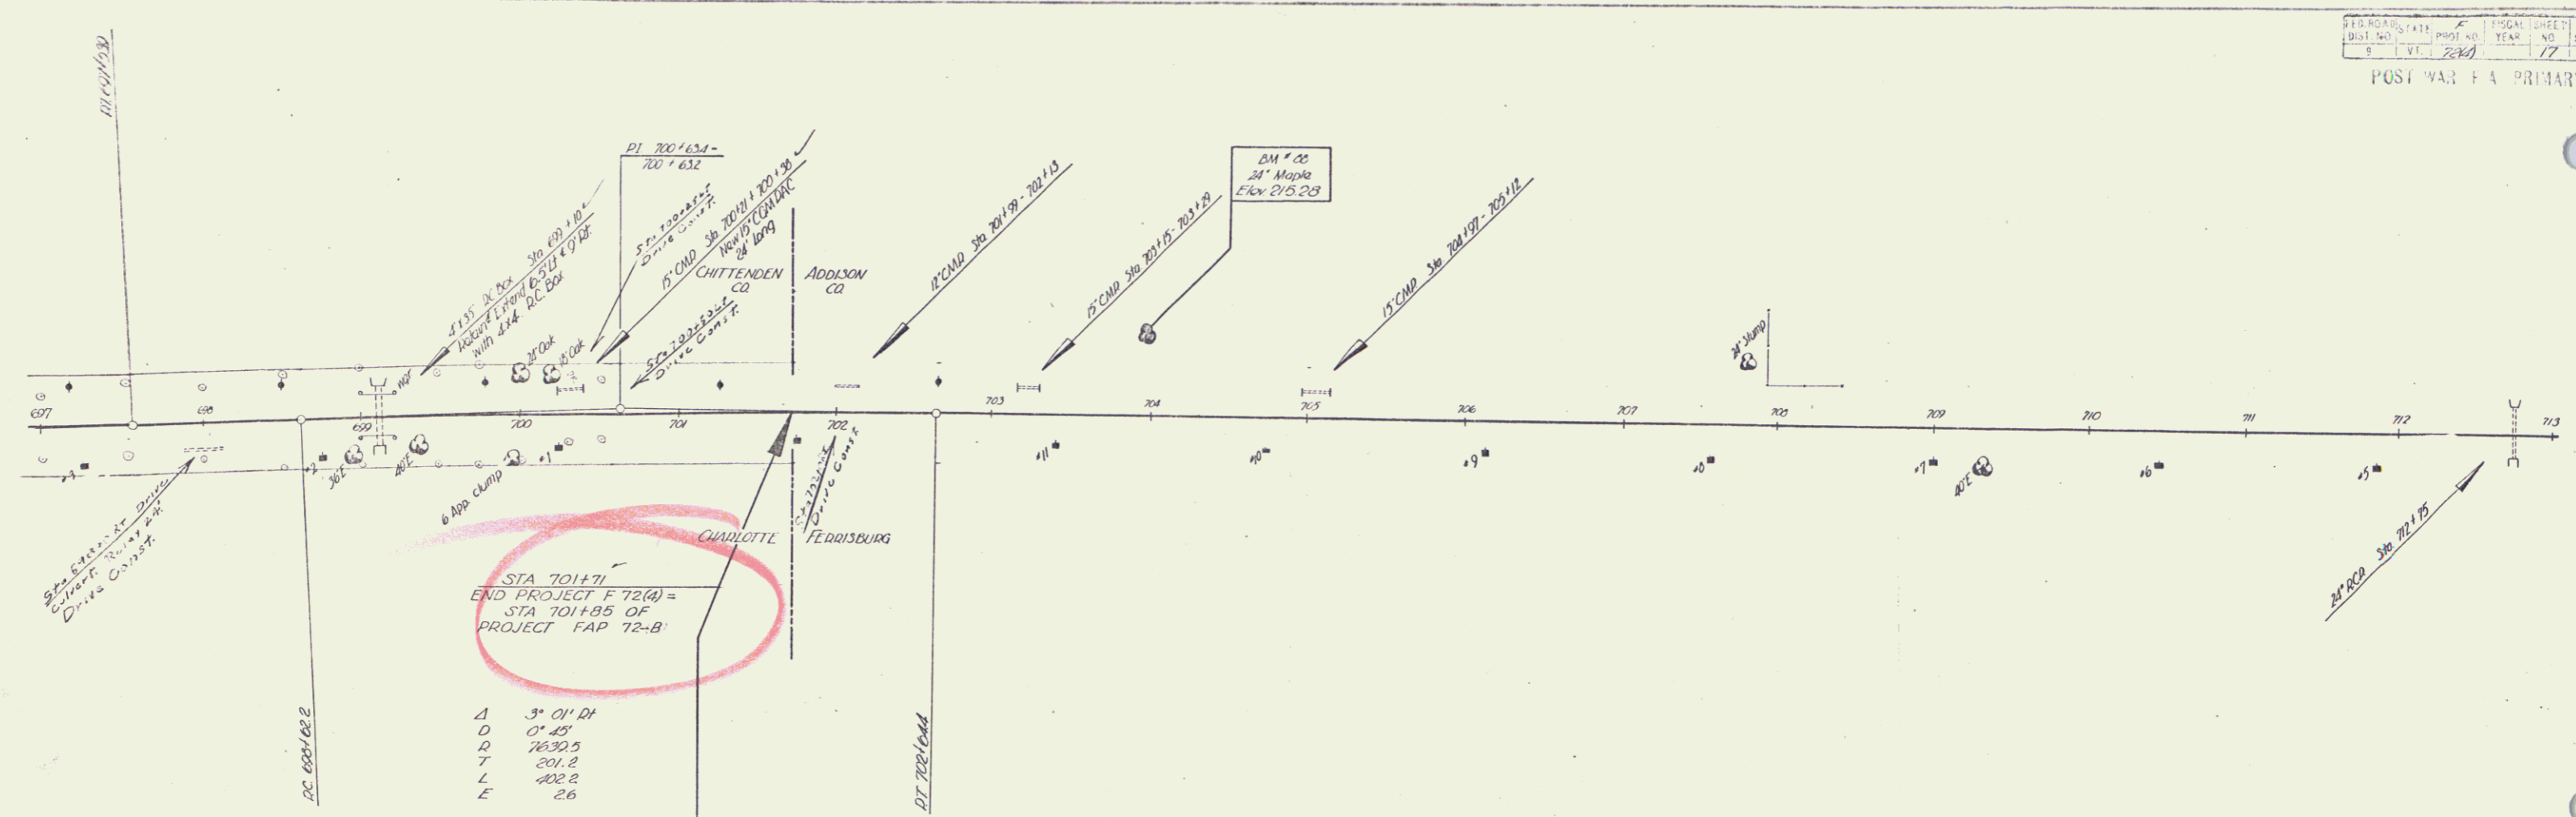

Δ	3' 01" 21
∅	0' 45"
∅	1630.5
T	201.8
L	102.2
E	2.6

DOWLING OF REINFORCED CONCRETE BOX EXTENSIONS
 STA 699+10

3/4" plain dowels 3'-0" long to be used to join present and proposed structures. Dowels to extend into existing structure 1'-6" of 10 centers and shall be securely grouted. Drilling, placing & grouting of dowels to be included in bid price of Concrete Class A, Item 41A. Dowels to be paid for as Reinforcing Steel, Item 42.

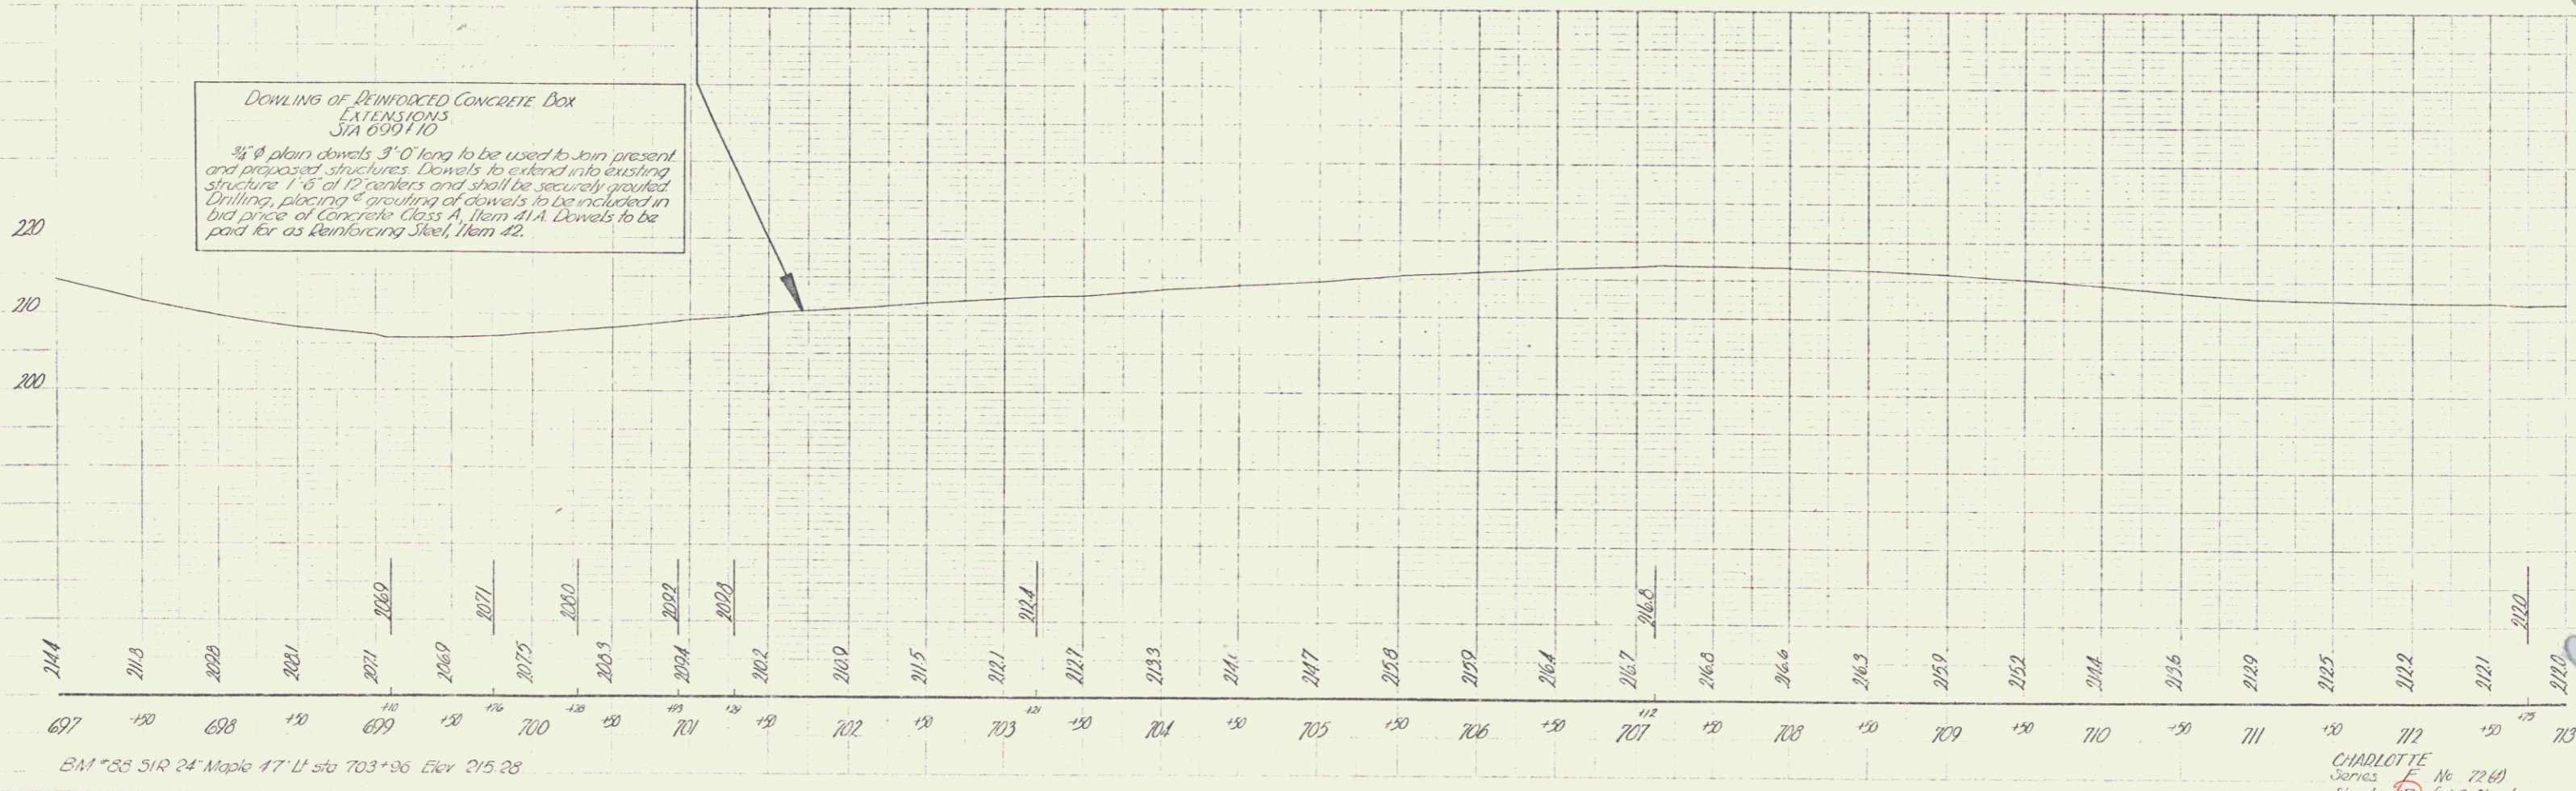

BM # 25 51R 24" Maple 47' LI sta 703+96 Elev 215.28

CHARLOTTE Series F No 72(4) Sheet 17 of 62 Sheets

18