


DIST. NO.	STATE	FISCAL YEAR	SHEET NO.	TOTAL SHEETS
9	VT.	72/72	2	15

POST WAR F A PRIMARY

TEAM
 Supervising Engineer
 Designer
 Checker
 Date

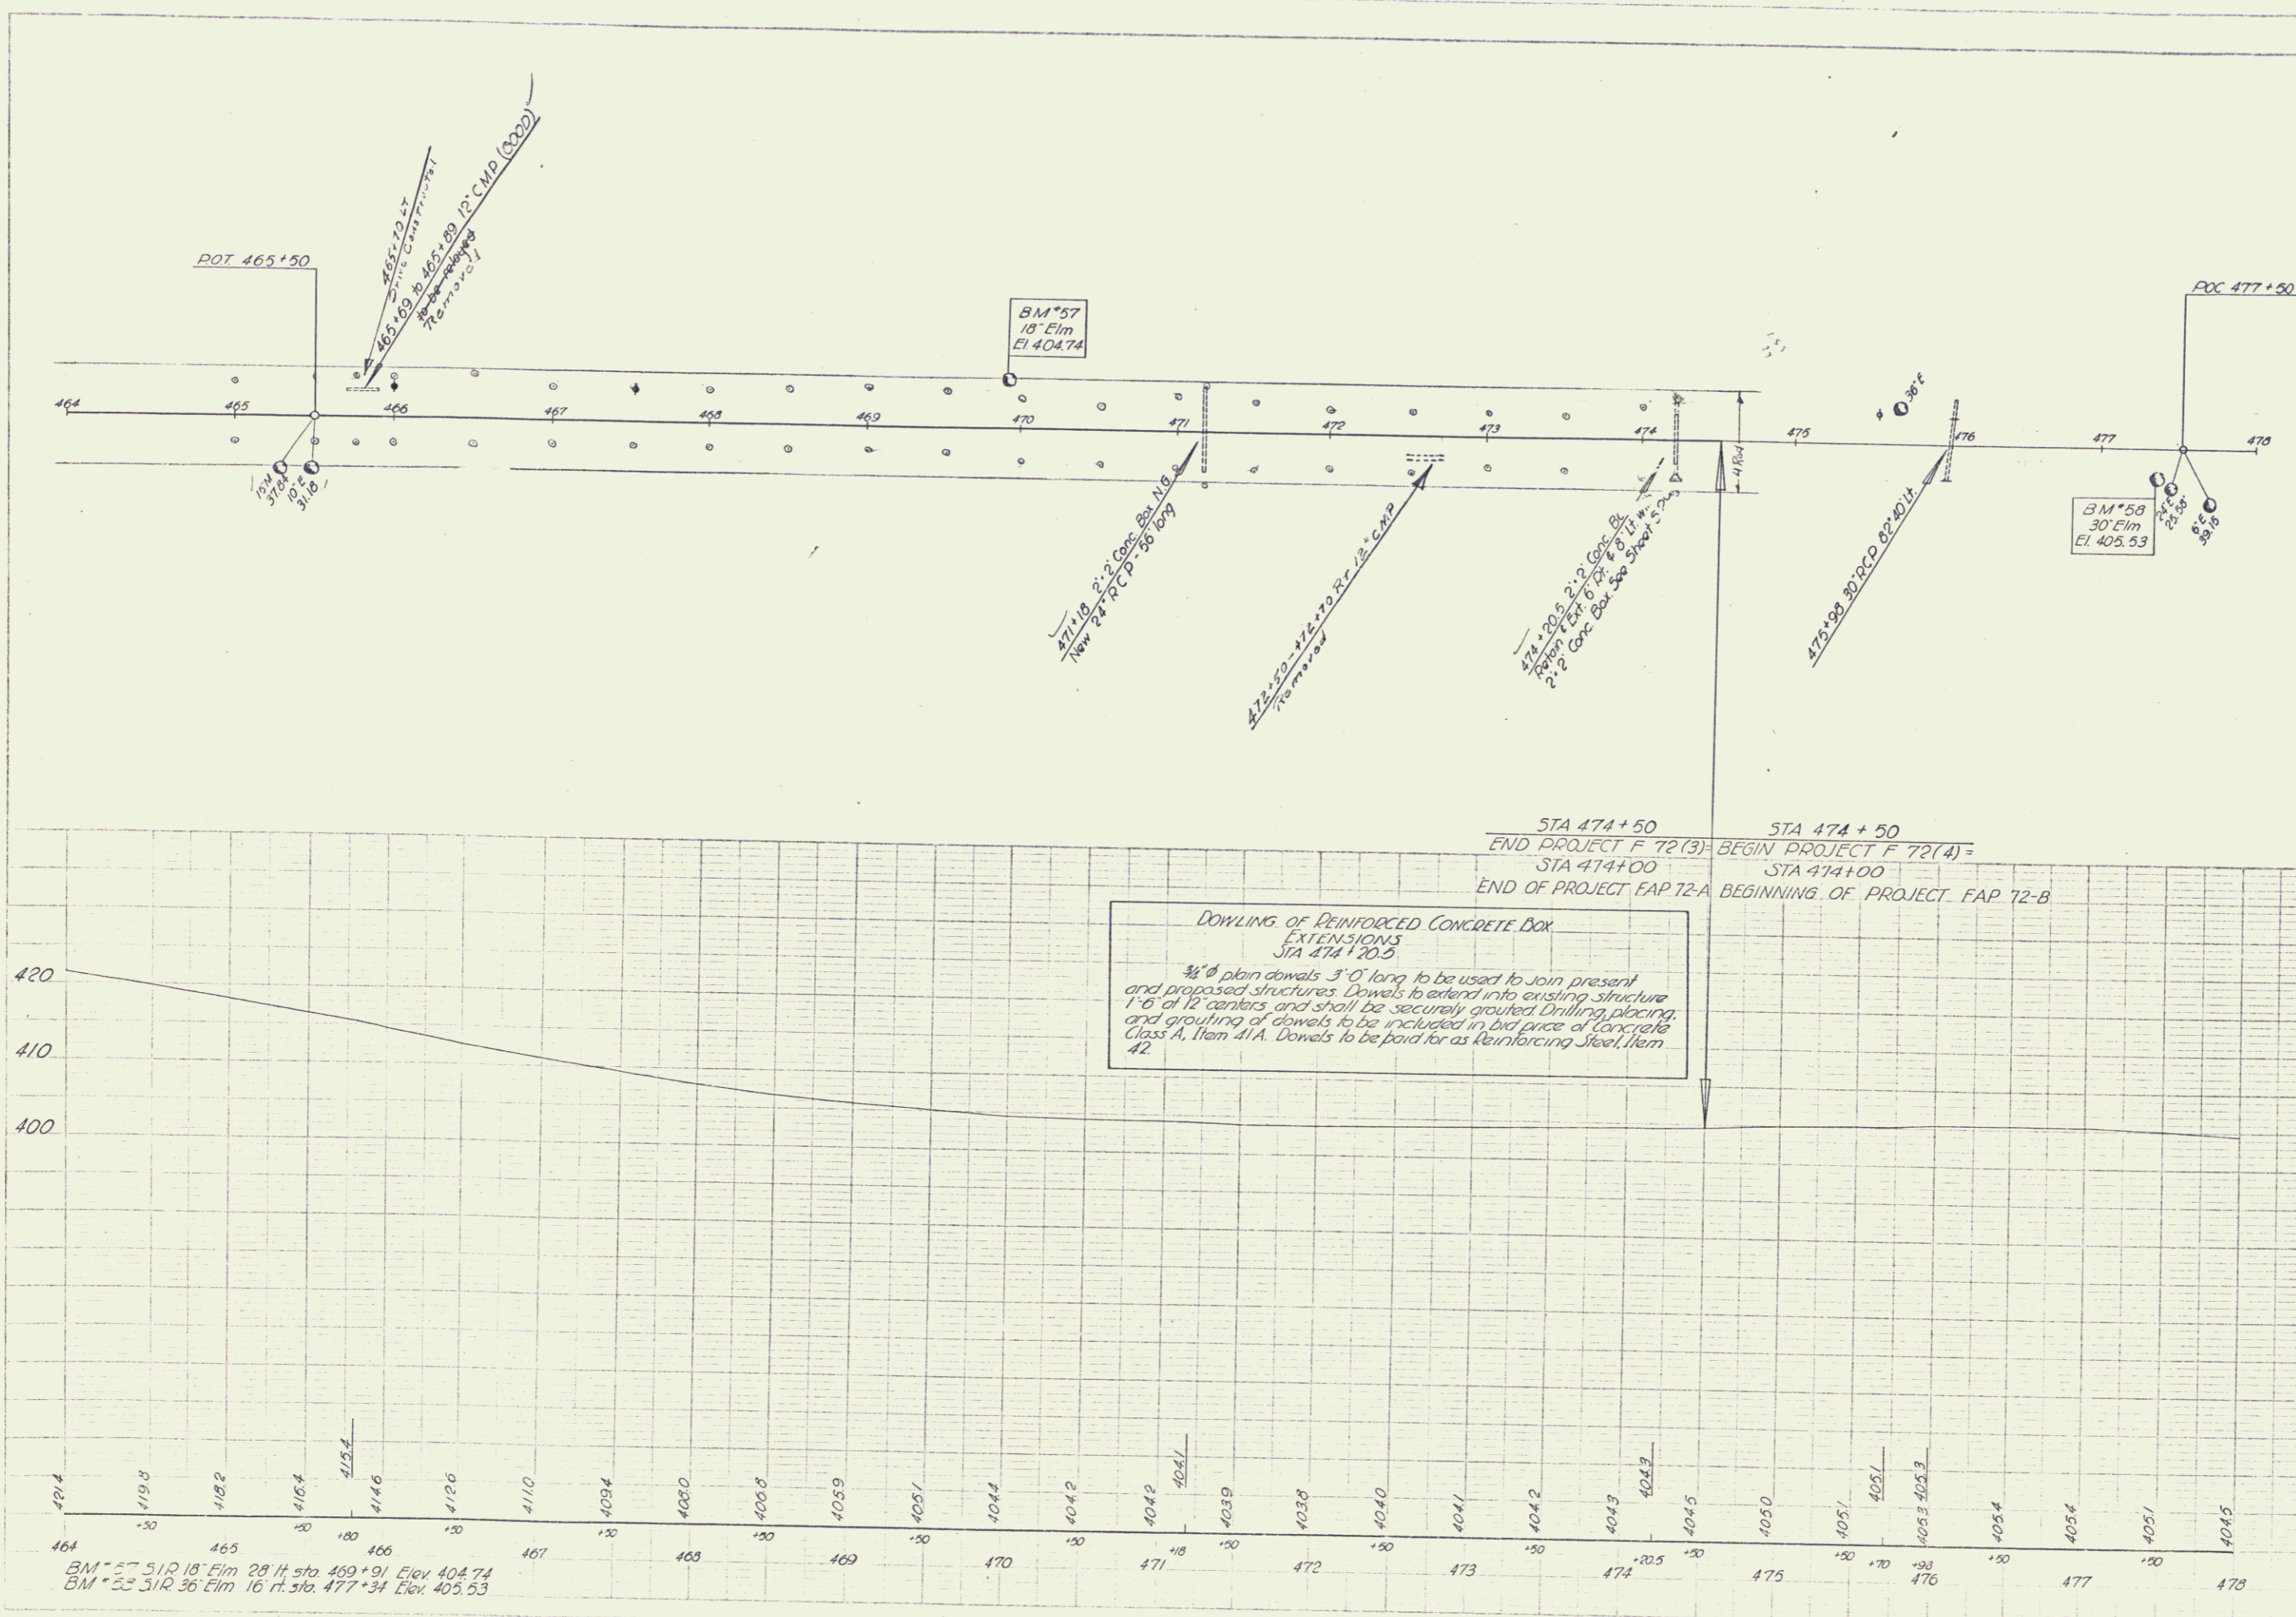

BM 57 18' Elm 28 ft sta 469+91 Elev 404.74
 BM 58 31R 36' Elm 16 ft sta 477+34 Elev 405.53

CHARLOTTE
 Series F no 72(3)
 Sheet 2 of 15 sheets