


2-D. ROAD  
 BUCKING  
 M. GEORGE  
 1/14/36

SPREAD  
 12" x 12" x 12"



| RESETTING CURB |              |              |             |
|----------------|--------------|--------------|-------------|
| STATION        | TYPE OF CURB | NO. OF CURBS | EST. AMOUNT |
| 11+00          | CONCRETE     | 1            | 1.00        |
| 11+10          | CONCRETE     | 1            | 1.00        |
| 11+20          | CONCRETE     | 1            | 1.00        |
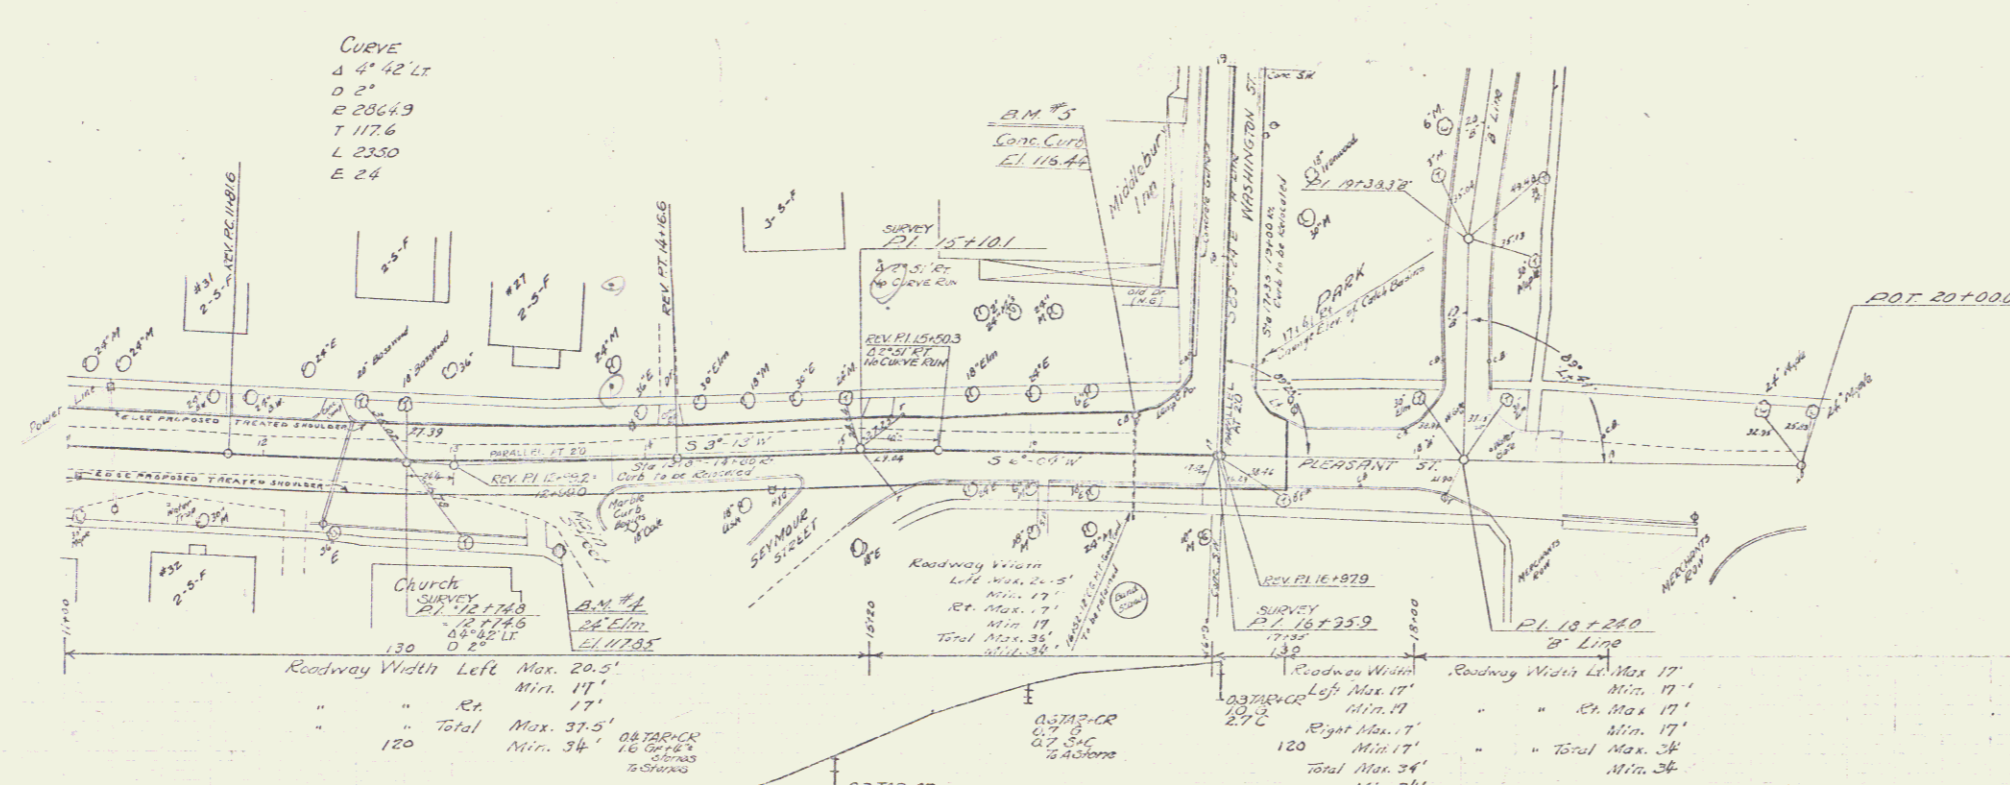