


DATE	DESCRIPTION
10/20/58	AS BUILT
10/20/58	CONSTRUCTION
10/20/58	FINAL

DATE	DESCRIPTION
10/20/58	AS BUILT
10/20/58	CONSTRUCTION
10/20/58	FINAL

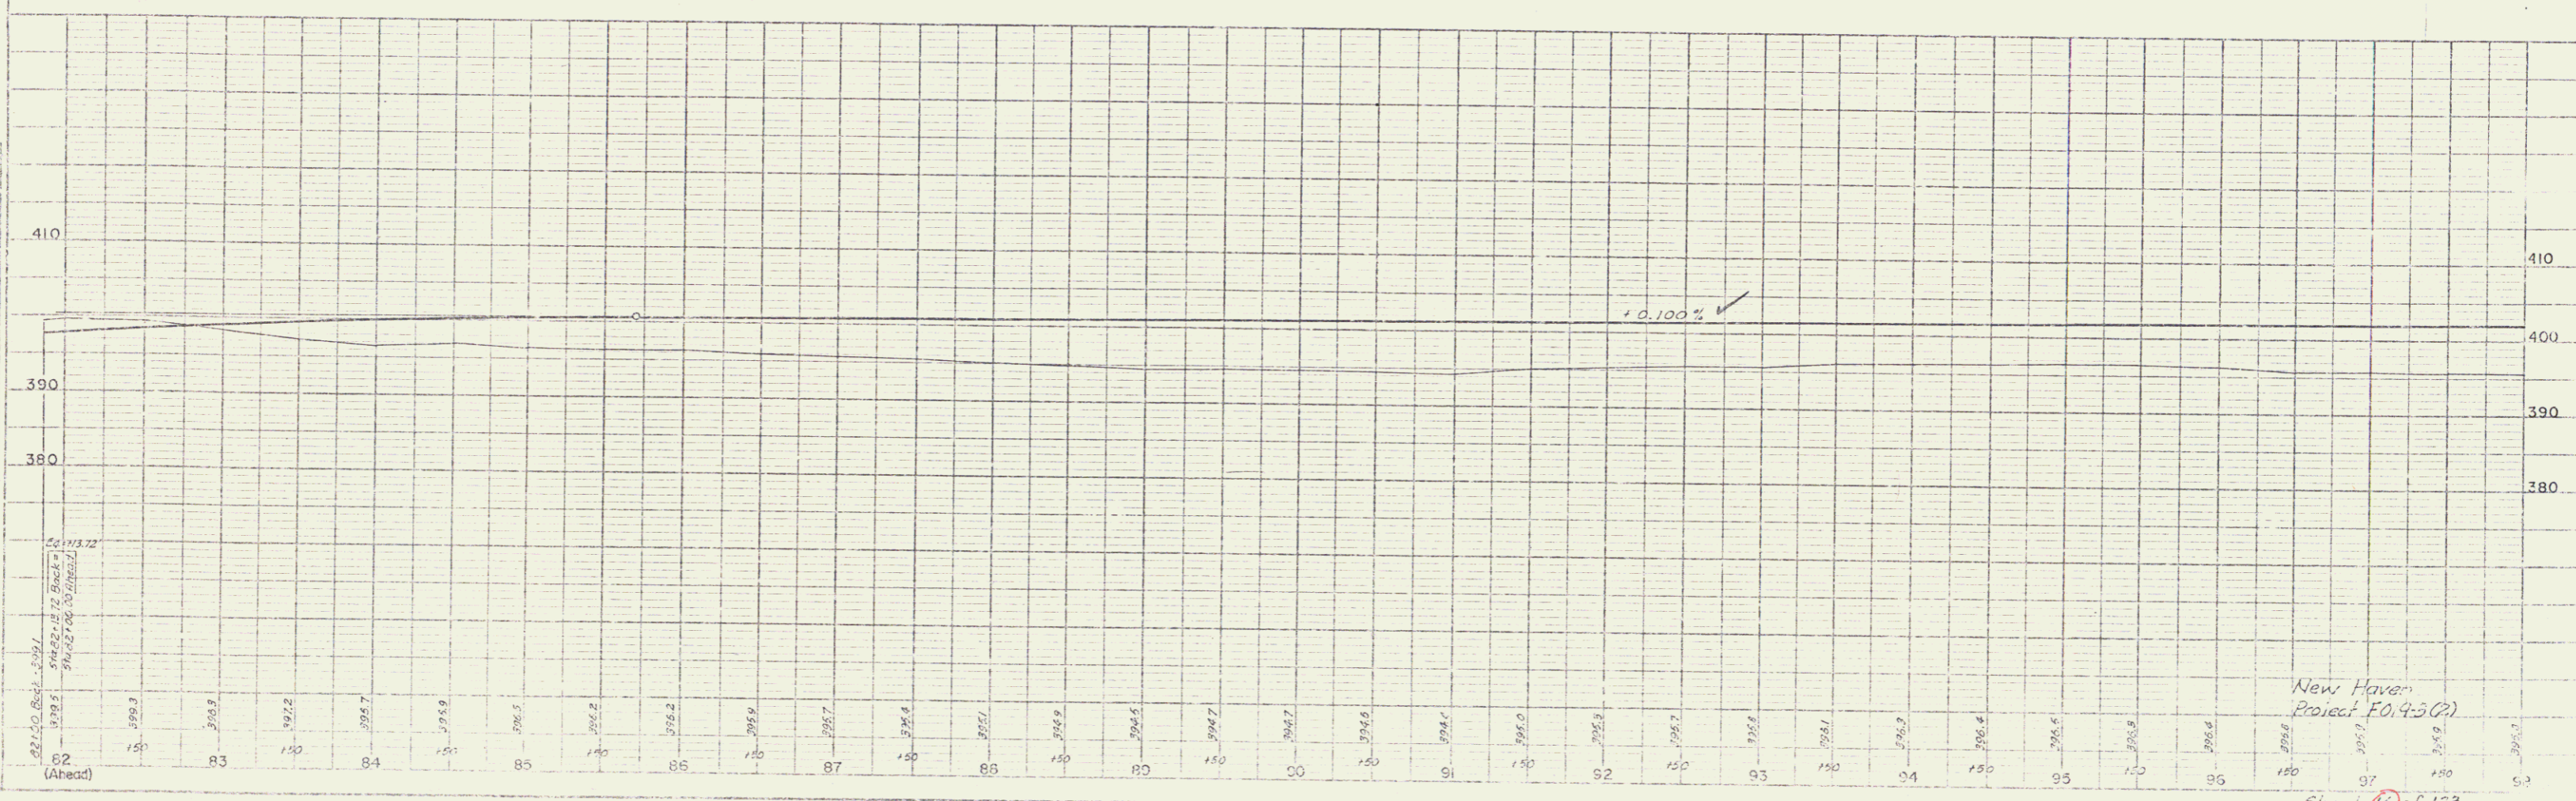

7